

SITE PLAN

MADISON TOWNSHIP, LAKE COUNTY, OHIO

for: DONALD MAH 428-1748

CLIENT OWNER

ADDRESS STREET CITY ZIP

SUBDIVISION VOL. - PG. NAME LOT 878 TRACT 475
SUBLOT NO. STREET PERM. PARCEL NO. 18-128-29 HIGHWAY 80, STREET

LEGEND

SANITARY MANHOLE WATER VALVE (GAS) WATER METER (GAS)
STORM MANHOLE INLET OR CATCH BASIN AS BUILT ELEVATION
HYDRANT EXISTING CONTOURS PROPOSED CONTOURS
EXIST. ELEV. 100.00 PROP. ELEV. 100.00
INDICATES DIRECTION OF SURFACE DRAINAGE

REMARKS

ALL BOUNDARY DATA SHOWN WAS OBTAINED FROM DEEDS, RECORDED SUBDIVISION PLAT OR OTHER PUBLIC RECORDS
LOCATIONS AS SHOWN OF ADJACENT WELLS AND SEPTIC TANKS OBTAINED FROM LAKE COUNTY HEALTH DEPARTMENT

DESIGN CERTIFICATION

THIS PLAT WAS PREPARED BY ME, AND IS CORRECT TO THE BEST OF MY KNOWLEDGE AND BELIEF.

NAME SURVEYOR REGISTRATION NO.

CHECK LIST

NO. OF BEDROOMS
DIMENSIONS
BEARINGS
TIE TO NEAREST STREET
SUBLOT NO. PARCEL NO.
SURROUNDING OWNERS
BLDG. DIMENSIONS FIN. GR.
BLDG. TYPE FLY. GRADES
APPROX. TYPE WIDTH THICKNESS
DIRECTION OF FLOW
CULVERT TYPE DIA. LENGTH
ROCK OUTCROPPINGS
WATER MAIN SIZE, LOCATION
SAN. SEWER SIZE & GR. LOC.
SAN. MH. CAST. ELEV. INV. ELEV.
SAN. CORR. SIZE, LOC. DEPTH
STORM SEWER SIZE & GR. LOC.
STORM MH. CAST. ELEV. INV. ELEV.
PAV. TYPE GRADES
GAS LINE LOC. SIZE PRESSURE
SEPTIC TANK LOCATION & DUPLICATION AREA
WELL LOCATION
ISOLATION RADII FROM WELL

PLAN PREPARED BY: BABCOCK • JONES & ASSOCIATES, INC. PAINESVILLE, OHIO

NO.	DATE	BY
1		
2		
3		
4		
5		
6		

DRAWN BY	HT	SCALE	1" = 20'	PHONE NO.	357-1811
CHKD.	HT	DATE	6/21/76	DRAWING NO.	96-170
CREW	LD	APPD.	HT		
CHIEF					

"AS BUILT" CERTIFICATION

I, HEREBY CERTIFY THAT THE CIRCLED GRADES ARE EXISTING FINISH GRADES CHECKED IN THE FIELD ON 1976 AND ARE CORRECT TO THE BEST OF MY KNOWLEDGE AND BELIEF.

REGISTERED SURVEYOR REG. NO.

TBM - P.L. MARK AND POWER POLE

ELEV. = 100.00

Grading Plan Approved as shown and/or noted

LSH

7-11-76

"I, the undersigned hereby certify that this topography indicated by 6", 1" or 2" contours, and elevations shown herein represent an actual field survey made by me on the 28th day of JULY, 1976 and that the elevations were taken at appropriate intervals and that as of that date they existed as indicated herein."

Name Reg. No.


Reviewed and Accepted

LAKE COUNTY GENERAL HEALTH DISTRICT

JOEL LUCIA, R.S., M.P.H.

Health Commissioner


BY J. Lucia

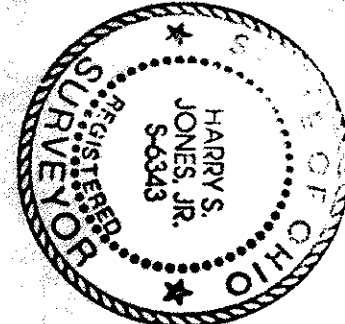

SEWAGE DISPOSAL PERMIT MUST BE OBTAINED BY A LAKE COUNTY LICENSED INSTALLER BEFORE INSTALLATION IS STARTED.

LOW YIELD WATER FIXTURES REQUIRED ON ALL: Shower Head Toilet

- A. To be brought to finished grade
- 1. Septic tank manhole covers
- 2. Splitter box cover
- 3. Distribution box cover
- B. No footer drains or downspouts to be discharged into septic tanks
- C. All waste water to be discharged into septic tanks

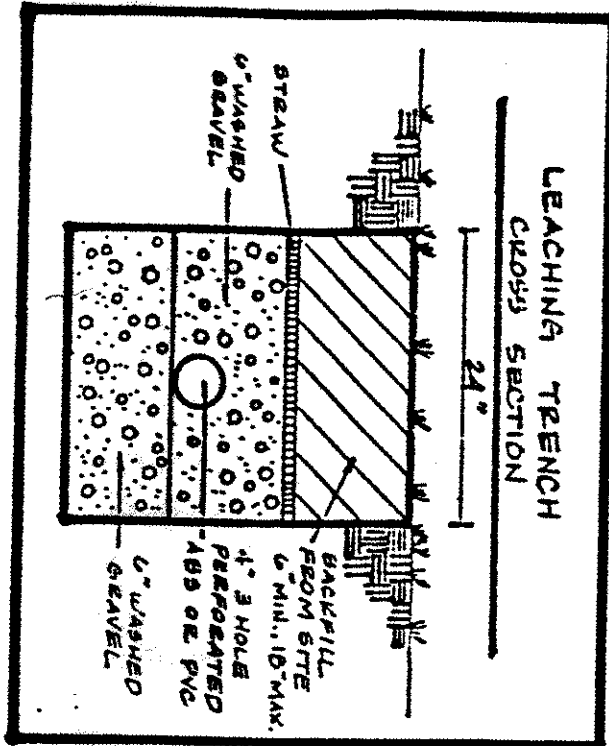

HYDRAULIC PROFILE
HORIZ 1" = 20' VERT 1" = 20'

APPROVED
MADISON TOWNSHIP ZONING

JUL 5 1996

PERMIT 150200
ZONING INSPECTOR CLE

MEMORANDUM ROAD-50