


MIDDLE RIDGE ROAD 60'

S 88°00'00" E

200.00'

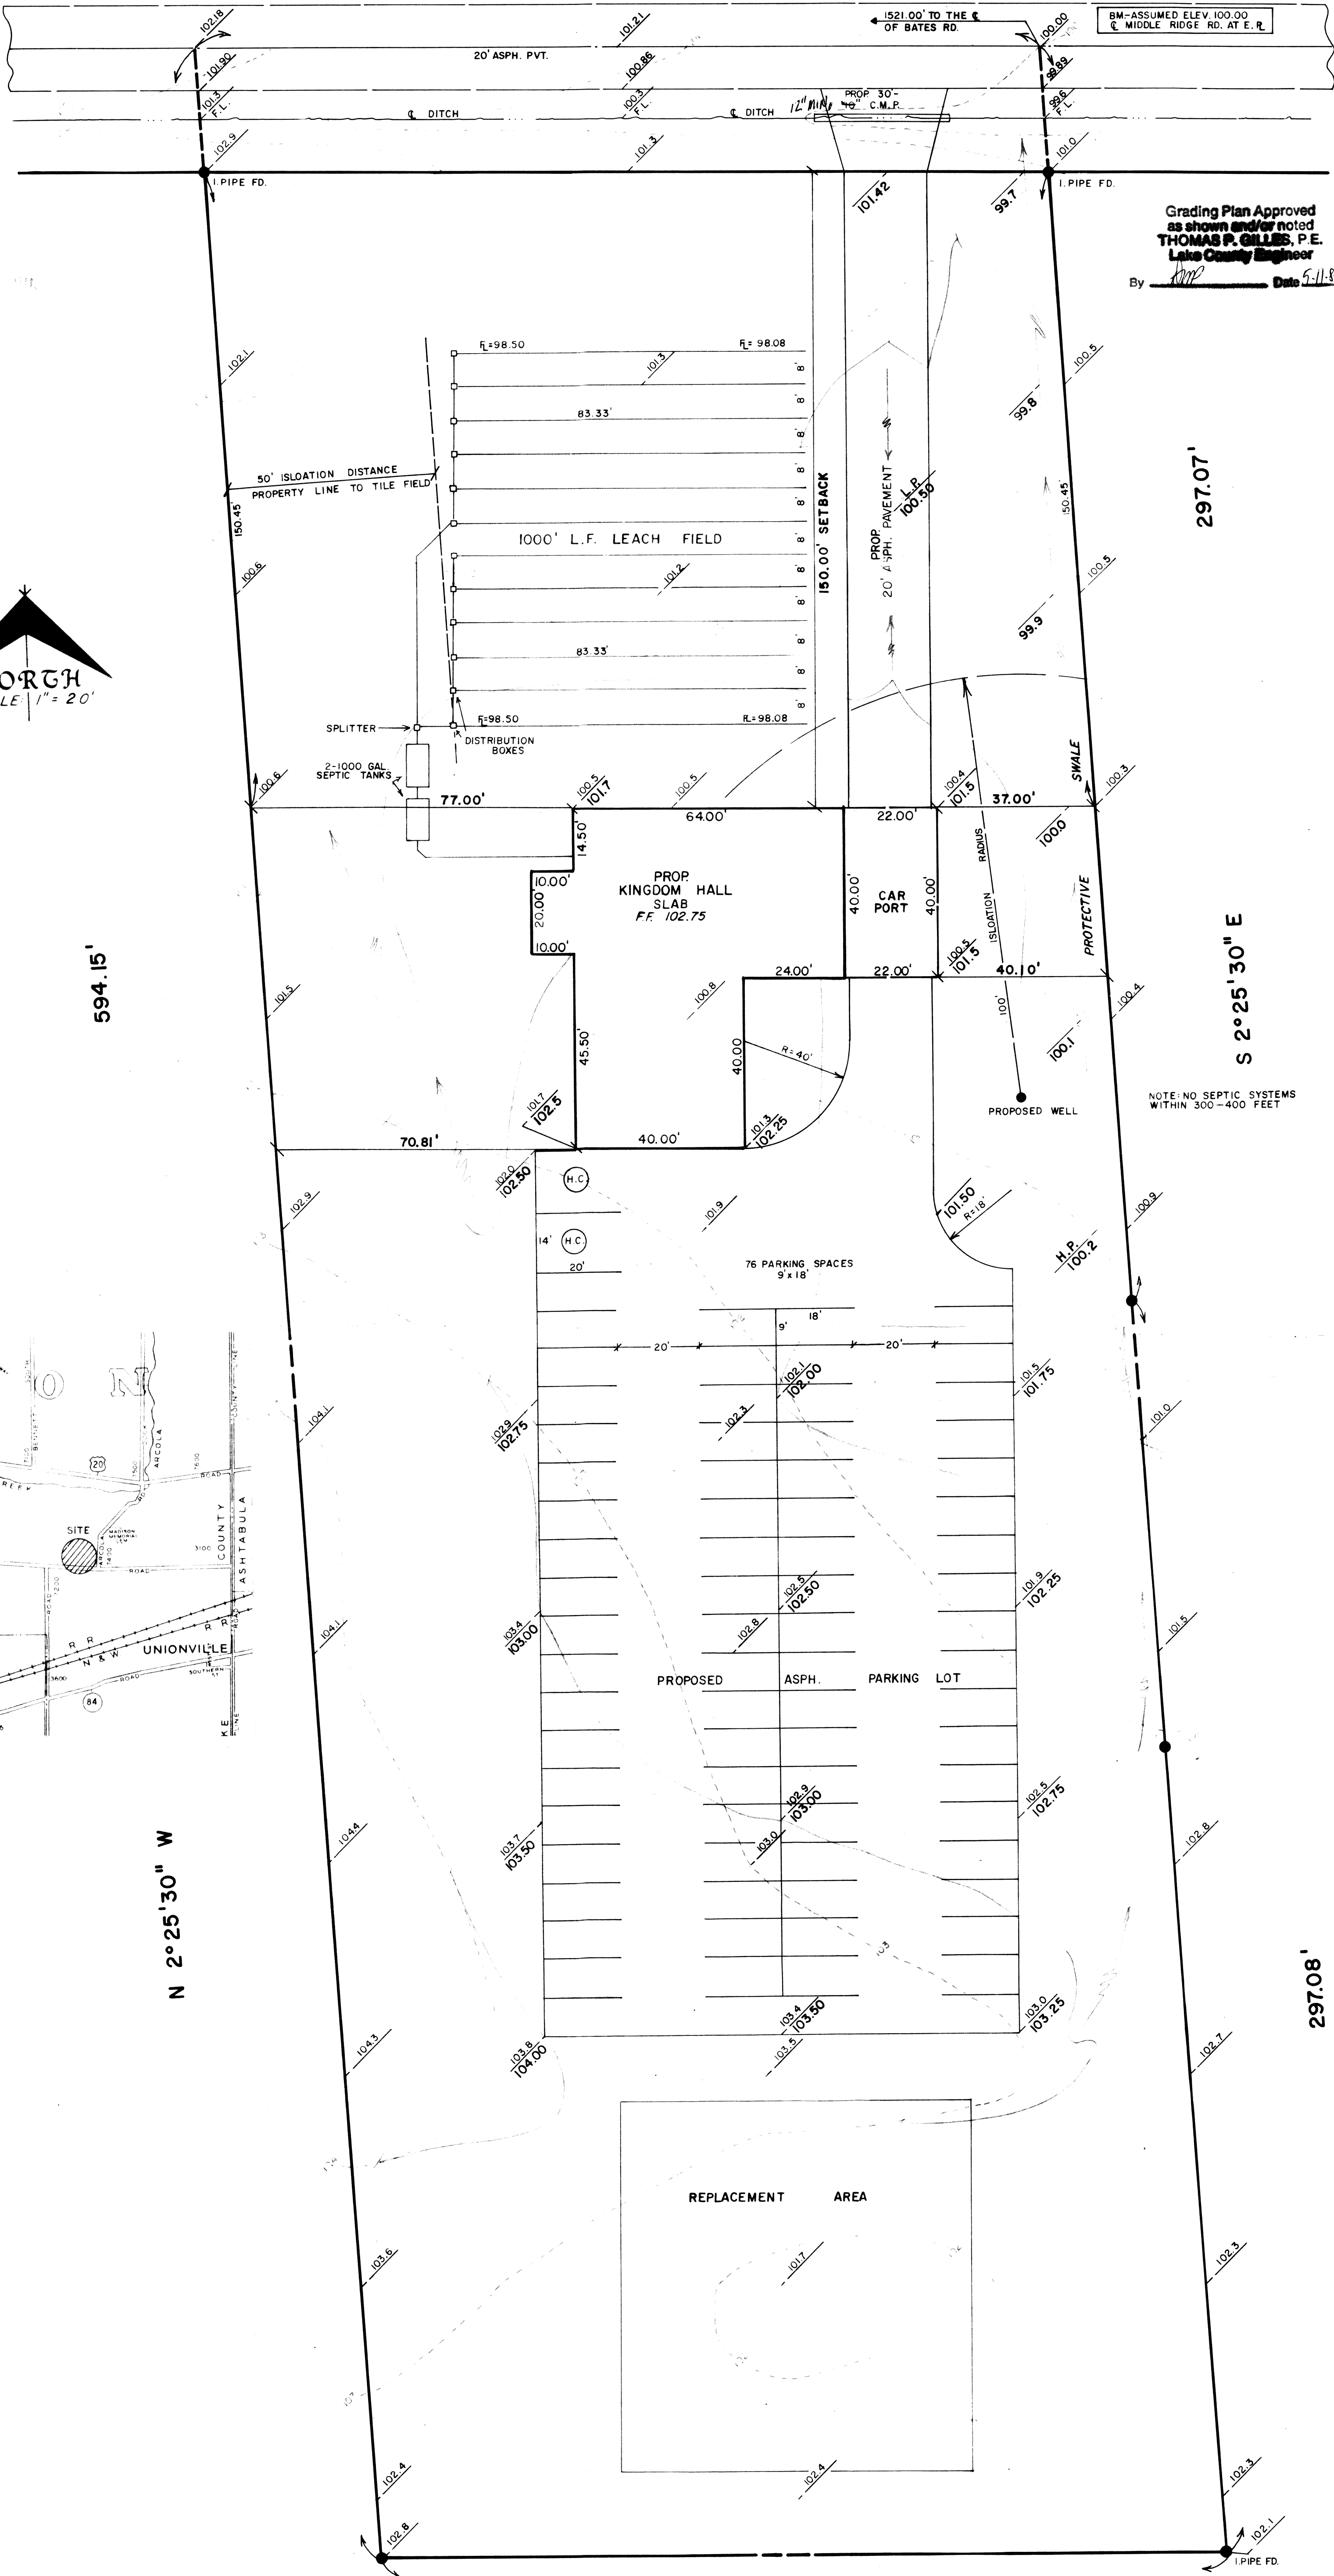

SITE PLAN			
MADISON LAKE COUNTY, OHIO			
for: MADISON CONGREGATION OF JEHOVAH'S WITNESSES KINGDOM HALL			
CLIENT OWNER			
3040 ANTIOCH RD. N. PERRY 44081			
ADDRESS STREET CITY ZIP			
SUBDIVISION	NAME	LOT	TRACT
VOL. - PG.		VOLUME	PAGE
SUBLOT NO.	STREET	PERM. PARCEL NO.	STREET
LEGEND			
SANITARY MANHOLE	---●---	WATER VALVE (GAS)	---+---
STORM MANHOLE	---●---	WATER METER (GAS)	---+---
INLET OR CATCH BASIN	---●---	AS BUILT ELEVATION	100.0
HYDRANT	---●---	INDICATES	DIRECTION OF SURFACE DRAINAGE
EXISTING CONTOURS	---		
PROPOSED CONTOURS	---		
EXIST. ELEV.	100.0	PROP. ELEV.	100.0
REMARKS			
ALL BOUNDARY DATA SHOWN WAS OBTAINED FROM (DEEDS, RECORDED SUBDIVISION PLAT OR OTHER PUBLIC RECORDS)			
LOCATIONS AS SHOWN OF ADJACENT WELLS AND SEPTIC TANKS OBTAINED FROM LAKE COUNTY HEALTH DEPARTMENT			
DESIGN CERTIFICATION			
THIS PLAT WAS PREPARED BY ME, AND IS CORRECT TO THE BEST OF MY KNOWLEDGE AND BELIEF.			
NAME	SURVEYOR	REGISTRATION	NO.




HYDRAULIC PROFILE

SCALES

HORIZONTAL 1" = 20'
VERTICAL 1" = 5'

LEGEND

EXISTING GROUND -----
PROPOSED GROUND -----

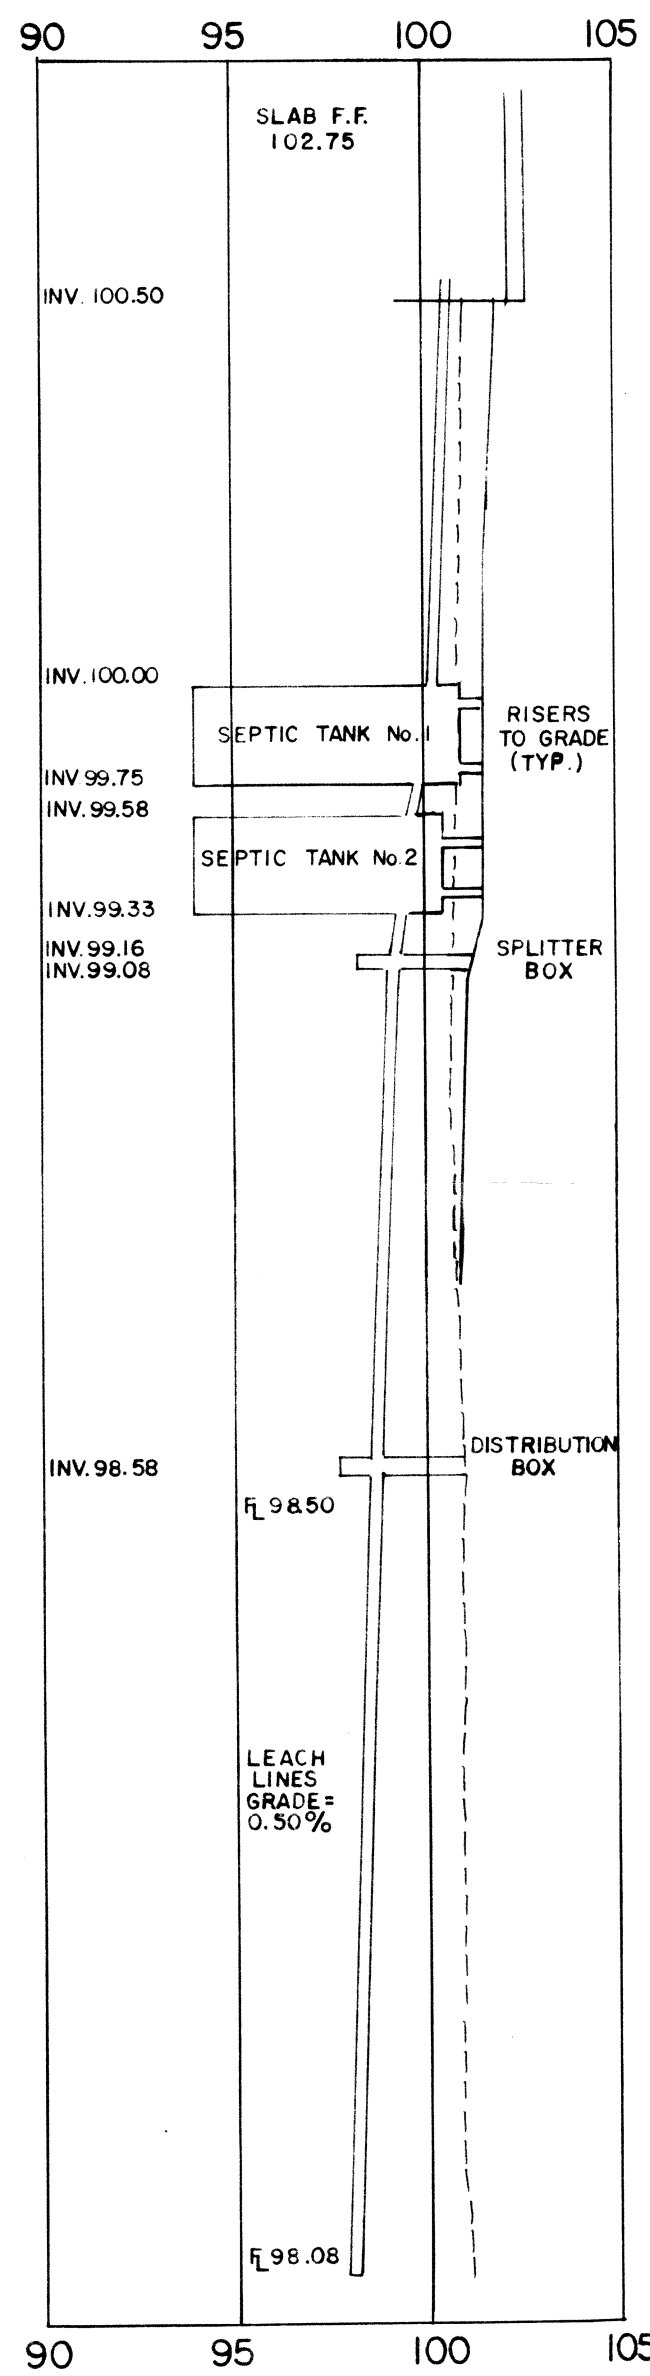

APPROVED
MADISON TWP. ZONING
Permit: 11854
Zoning Inspector: [Signature]

REVISIONS			PLAN PREPARED BY:		
NO.	DATE	BY	DEBEVEC • SALO & ASSOCIATES, INC.		
1			125 E ERIE ST PAINESVILLE, OHIO		
2			DRAWN BY	SCALE 1" = 20'	PHONE NO. 352-9250
3			CHK'D.	DATE 6/86	DRAWING NO. 6470
4			CREW		
5			CHIEF		