


Topographic Survey Map and Site Plan

for the
Property of Christopher D. Hoyt
Reference Lake County Document 980009963
0.7174 Acres as Surveyed

Situate in the Township of Madison,
County of Lake, and the State of Ohio,
and known as being a part of Original Lot 11,
Tract 4, Twp. 11N, Range VI,
of The Connecticut Western Reserve.

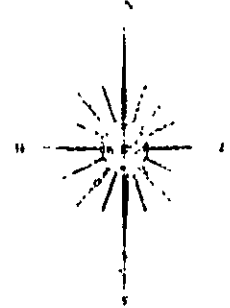

Bearings are Assumed

AND ACCEPTED
COUNTY GENERAL
HEALTH DISTRICT
2-7-00
Dwight B. Morris, Jr.


PERMIT MUST BE
LAKE COUNTY LICENSED
INSTALLATION IS

CONSTRUCTION NOTES

ALL CONSTRUCTION OF SEPTIC SYSTEM AND HOUSE DRAINAGE SHALL CONFORM TO THE LAKE COUNTY BOARD OF HEALTH AND THE MADISON TOWNSHIP ZONING REGULATIONS

THE SEPTIC LEACHING SYSTEM AND CURTAIN DRAIN SHALL BE INSTALLED TO DETAILS AS DESCRIBED AND DRAWN IN CHAPTER 9.33 OF THE LAKE COUNTY GENERAL HEALTH DISTRICT ORDINANCES

THE SEPTIC TANK MANHOLES SHALL BE INSTALLED WITH SAFETY SECURED COVERS EXTENDED TO GRADE TO PROVIDE ACCESS TO THE INLET AND OUTLET PIPES AND TO EACH COMPARTMENT OF THE TANK FOR INSPECTION AND CLEANING. THE DISTANCE FROM THE LIQUID LEVEL TO THE COVER SHALL BE AT LEAST TWELVE (12") INCHES.

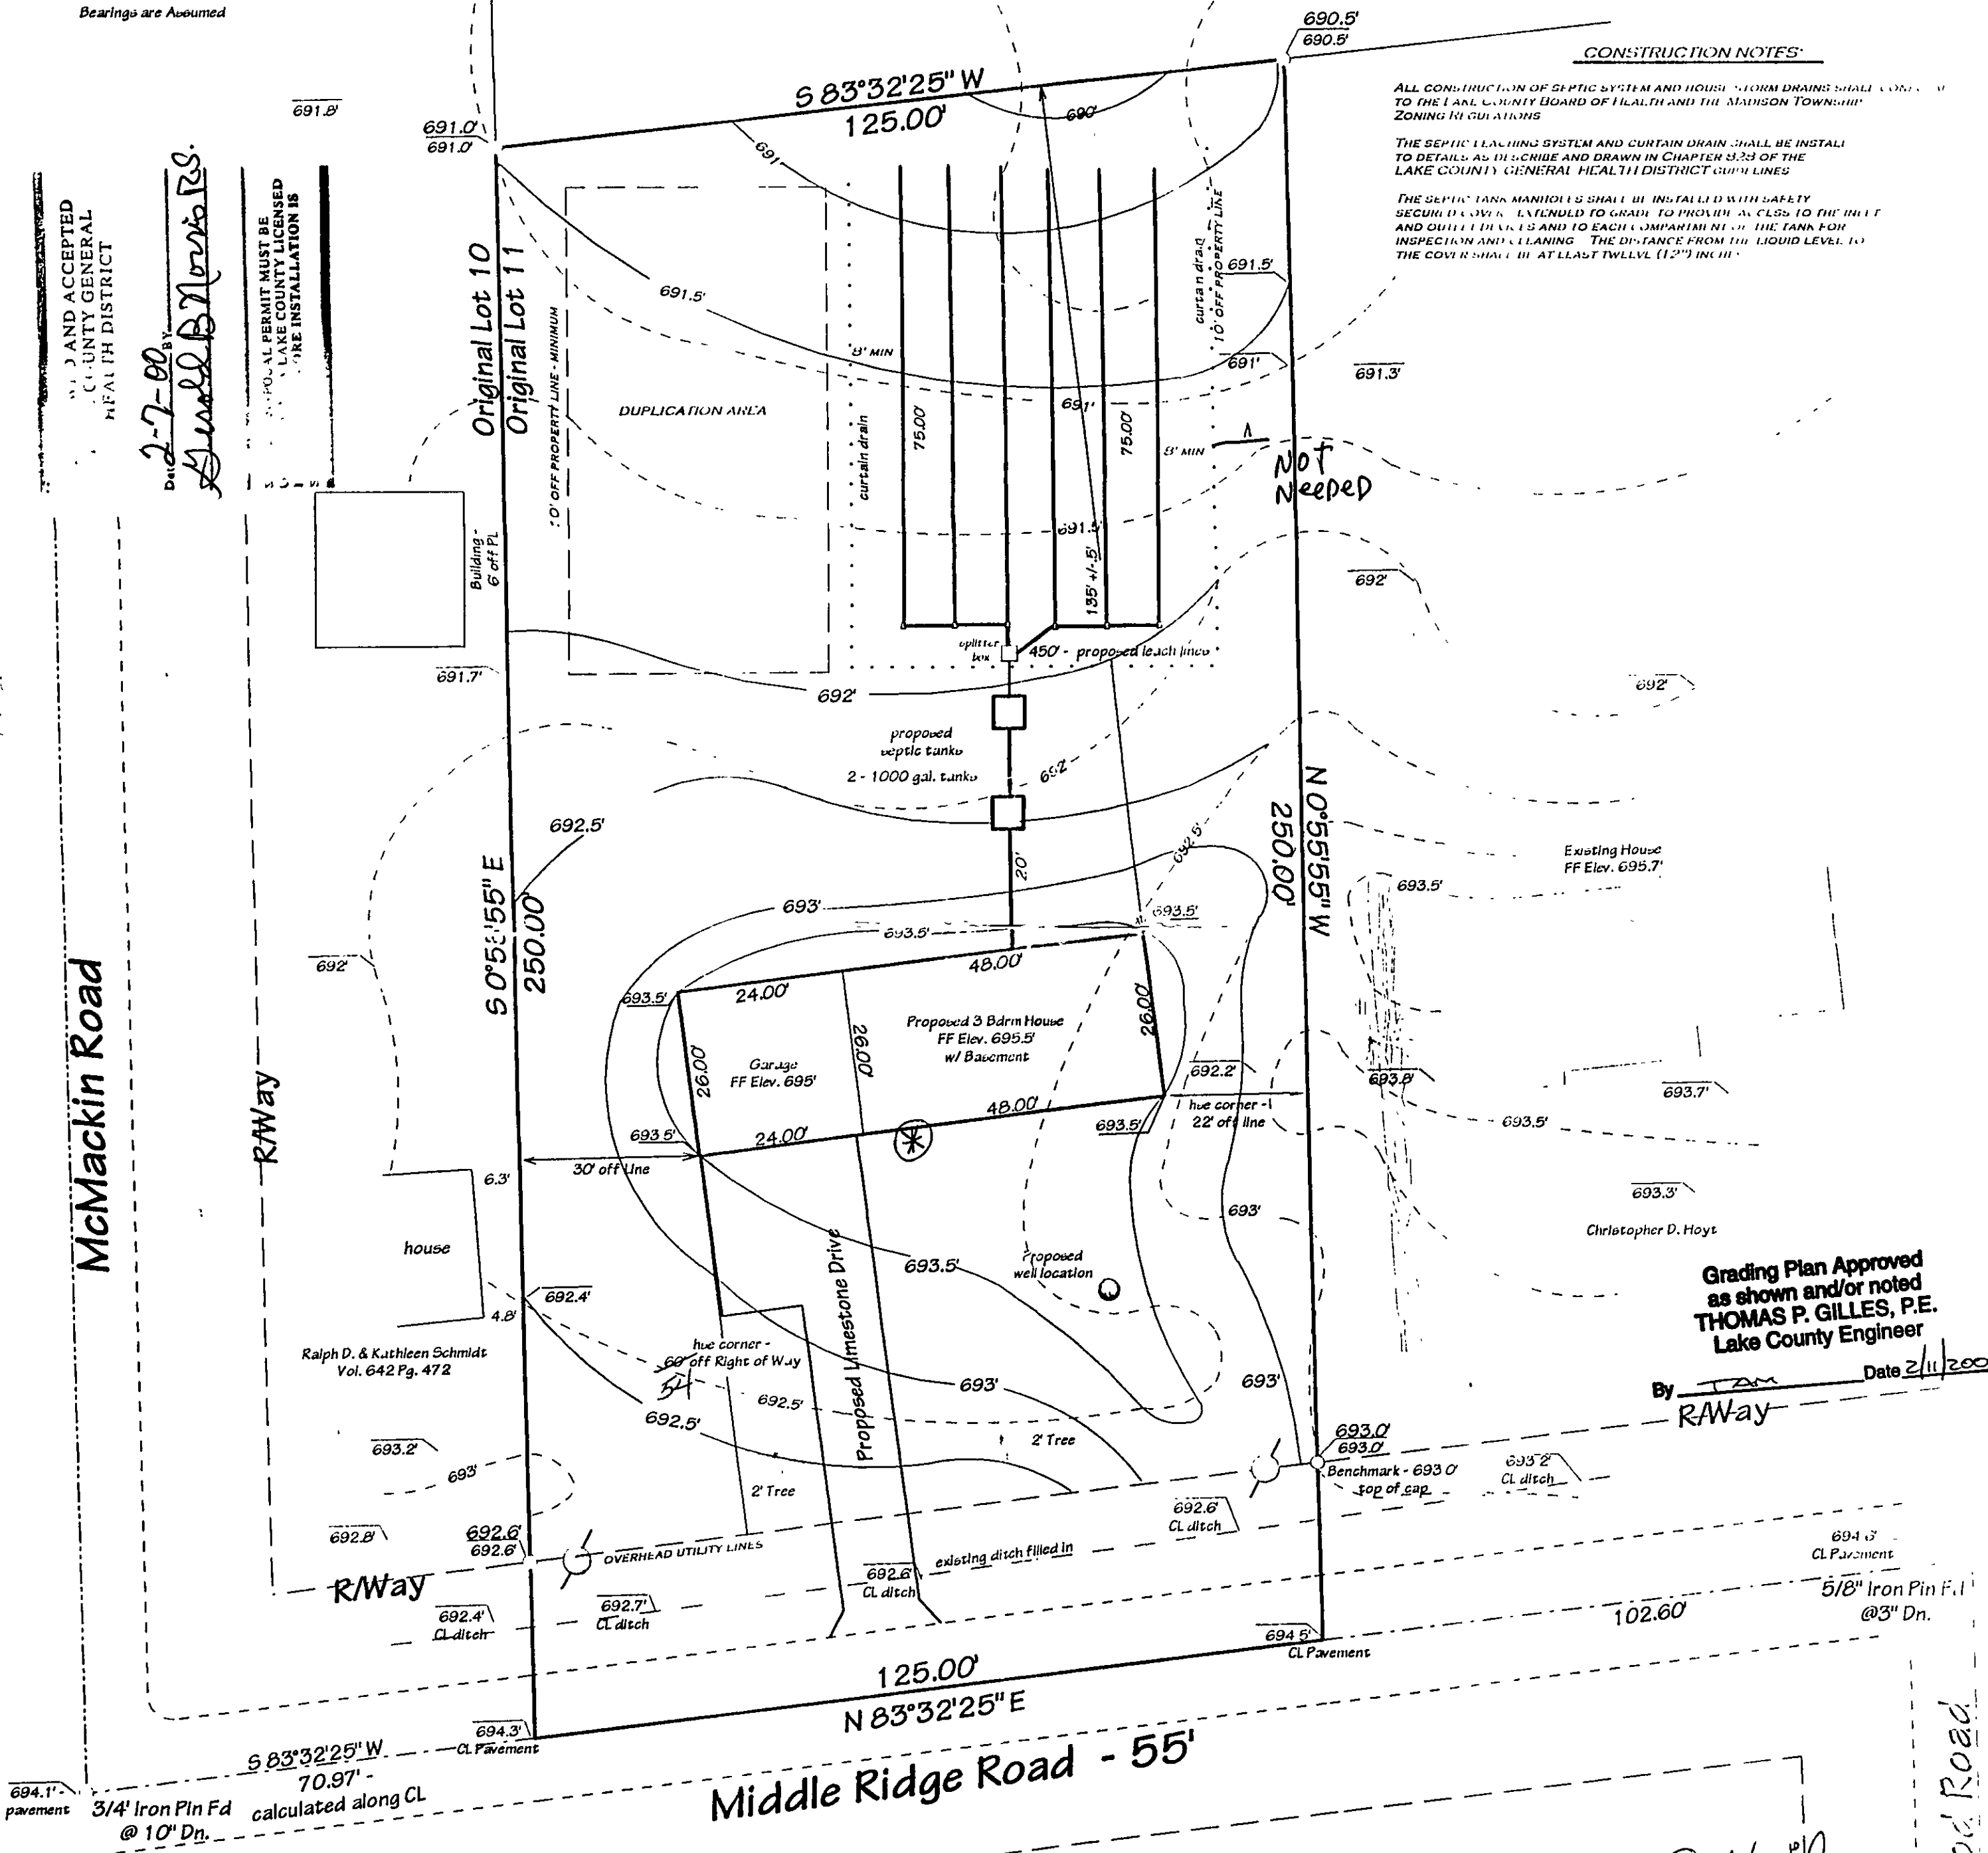

Grading Plan Approved
as shown and/or noted
THOMAS P. GILLES, P.E.
Lake County Engineer

By TAM Date 2/11/2000
R/Way

Legend

5/8" Iron Pin found

Utility Pole

690.5' - Proposed
690.5' - Existing

Graphic Scale



Reviews

Approved by Madison township Zoning

Date: _____

Approved by The Lake County
General Health District


Date: _____

Approved by The Office of the
Lake County Engineer

Date: _____

Approved by The Office of the
Lake County Building Department

Date: _____

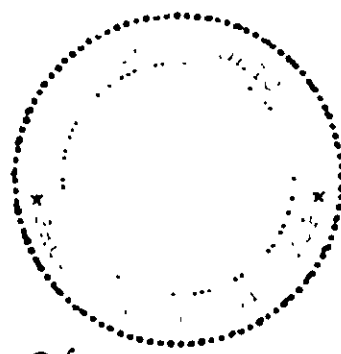

Attest: _____

Thomas P. Gilles
Professional Land Surveyor
Ohio Registration No. 7827

I certify this plat represents a true survey based upon field measurements made under my supervision. All distances are expressed in feet and decimal parts thereof in accordance with Ohio Administrative Code 4733-37. Monuments were found or set as indicated.

* 6' wide
Front Yard
Included, not
shown

APPROVED
MADISON TOWNSHIP ZONING

Date: 2/11/2000

MAF Surveying

PO Box 163
Madison, Ohio 44057
1-440-428-9563