


Reviewed and Accepted
LAKE COUNTY COMMISSIONER GENERAL
DISTRICT OF HEALTH
Date 8-2-76
PAUL C. KILUTH, M.D.
Health Commissioner

Grading Plan Approved
as shown and/or noted
THOMAS P. GILLES, P.E.
Lake County Engineer
By JWK Date 8-2-76

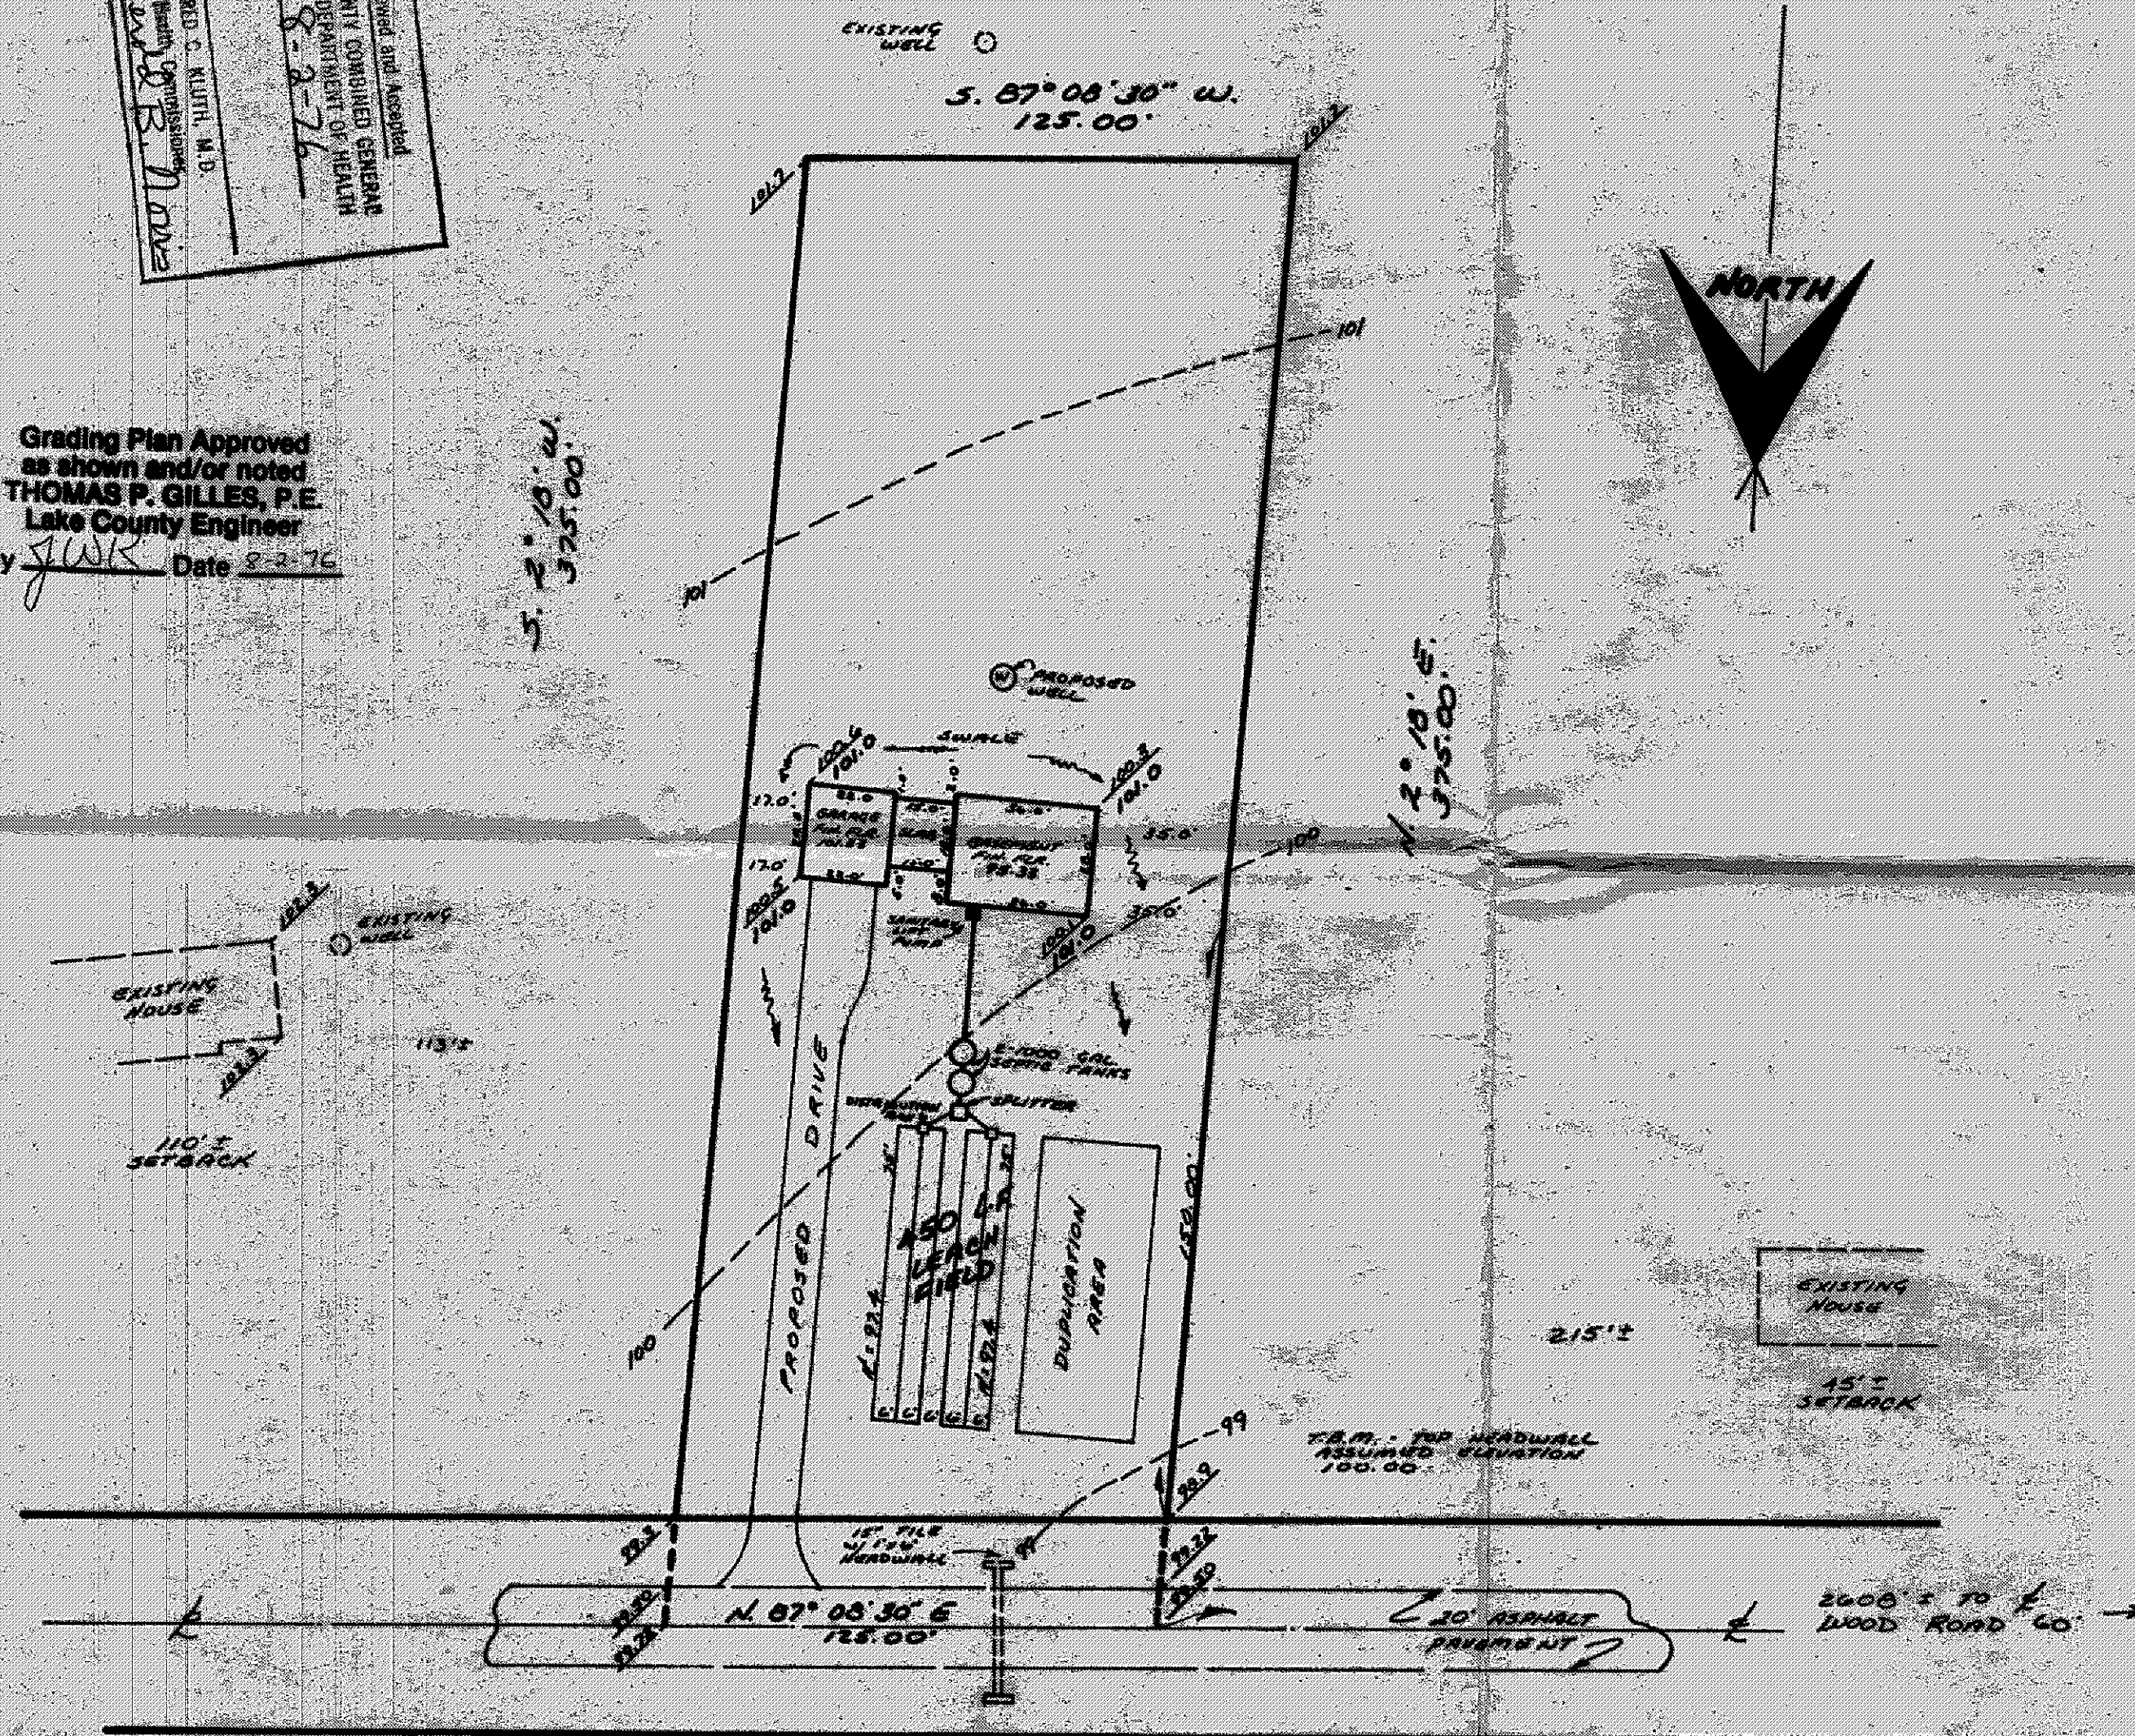

MIDDLE RIDGE ROAD 55'

SITE PLAN

MADISON LAKE COUNTY, OHIO
TOWNSHIP

for: NEFF, NAUGHTON, FAUVER
CLIENT OWNER

ADDRESS STREET CITY ZIP

SUBDIVISION	NAME	LOT	TRACT
VOL. 100		6	3
SUBLOT NO.	STREET	VOLUME	PAGE
		PERM. PARCEL NO.	<u>CURVE RADIUS</u>

LEGEND

SANITARY MANHOLE	---○---	WATER VALVE (GAS)	---●---
STORM MANHOLE	---●---	WATER METER (GAS)	---○---
INLET OR CATCH BASIN	---○---	AS BUILT ELEVATION	100.0
HYDRANT	---○---	INDICATES	
EXISTING CONTOURS	---○---	DIRECTION OF	
PROPOSED CONTOURS	---○---	SURFACE DRAINAGE	
EXIST. ELEV.	100.0	PROP. ELEV.	100.0

REMARKS

ALL BOUNDARY DATA SHOWN WAS OBTAINED FROM (DEEDS, RECORDED SUBDIVISION PLAT OR OTHER PUBLIC RECORDS)

LOCATIONS AS SHOWN OF ADJACENT WELLS AND SEPTIC TANKS OBTAINED FROM LAKE COUNTY HEALTH DEPARTMENT

DESIGN CERTIFICATION

THIS PLAN WAS PREPARED BY ME, AND IS CORRECT TO THE BEST OF MY KNOWLEDGE AND BELIEF.

NAME Richard H. Salo SURVEYOR REGISTRATION NO. PS 11 5244

CHECK LIST

NO. OF BEDROOMS	WATER MAIN SIZE, LOCATION
DIMENSIONS	SAN. SEWER SIZE & GR. LOC.
BEARINGS	SAN. MH. CAST. ELEV. INV. ELEV.
TIE TO NEAREST STREET	SAN. CONN. SIZE, LOC. DEPTH
SUBLOT NO. PARCEL NO.	STORM SEWER SIZE & GR. LOC.
SURROUNDING OWNERS	STORM MH. CAST. ELEV. INV. ELEV.
BLDG. DIMENSIONS FIN. GR.	PAV'T TYPE GRADE CURBS
BLDG. TIES FL'R. GRADES	GAS LINE LOC. SIZE PRESSURE
APRON TYPE WIDTH THICKNESS	SEPTIC TANK LOCATION & DUPLICATION AREA
SIDEWALK TYPE WIDTH THICKNESS	WELL LOCATION
CULVERT TYPE DIA. LENGTH	ISOLATION RADIUS FROM WELL
ROCK OUTCROPPINGS	

REVISIONS			PLAN PREPARED BY:	
NO.	DATE	BY	DEBEVEC • SALO & ASSOCIATES, INC.	
1			130 EAST JACKSON ST. PAINESVILLE, OHIO	
2			DRAWN BY	SCALE 1" = 40'
3			CHK'D. <u>RJB</u>	DATE 26 July 76
4			CREW CHIEF	APP'D.
5				4710

"AS BUILT" CERTIFICATION
I, HEREBY CERTIFY THAT THE CIRCLED GRADES ARE EXISTING FINISH GRADES CHECKED IN FIELD ON 19 BY SURVEYING AND ARE CORRECT TO THE BEST OF MY KNOWLEDGE AND BELIEF.

REGISTERED SURVEYOR REG. NO.

APPROVED
MADISON TWP. ZONING
Permit 9670
Zoning Inspector John P. Brown