


SITE PLAT FOR WILLIAM YOE

ALL THAT CERTAIN LANDS SITUATE IN LOT NO. 5, TRACT NO. 3, TOWNSHIP OF MADISON, COUNTY OF LAKE, STATE OF OHIO. LANDS TO WILLIAM S. YOE, SR. & WILLIAM S. YOE, JR., AS RECORDED IN DEED VOLUME 417, PAGE 832 IN THE OFFICE OF THE COUNTY RECORDER.

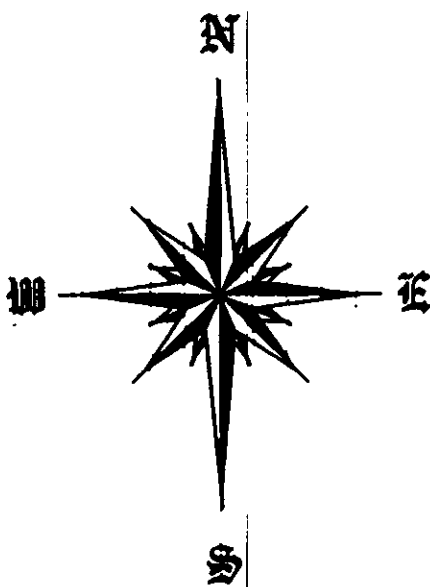

CHK: T. STOCKER
DRN: S. LOVEJOY
REV:
PAGE 1 OF 1

PROJECT ADDRESS:
MIDDLE RIDGE ROAD
MADISON, OHIO 44057

PROJECT NAME:
SITE PLAN

PREPARED FOR:
WILLIAM YOE

FOR INQUIRIES CONCERNING THIS SURVEY CONTACT:
U.S. SURVEYOR
CRABBS' SURVEYING SERVICE
10 WEST ERIE STREET, SUITE 101
PAINEVILLE, OH 44077
1-800-488-9888

LOT 2, TRACT 4

LOT 1, TRACT 4




LOT 5, TRACT 4

W.S. YOE, SR. & W.S. YOE, JR.
VOL. 417, PG. 832
PPN 1A-4-18

REVIEWED AND ACCEPTED
LAKE COUNTY GENERAL
HEALTH DISTRICT
DATE: 6-11-01
BY: [Signature]
SEWAGE DISPOSAL: IT MUST BE OBTAINED FROM A COUNTY LICENSED INSTALLER. INSTALLATION IS STARTED.



USPARY A. HEDOUK, TRUSTEE
DOC: 200006371
PPN 1A-4-19

CHARLES & HELEN KOHANEK
VOL. 410, PG. 487
PPN 1A-4-17

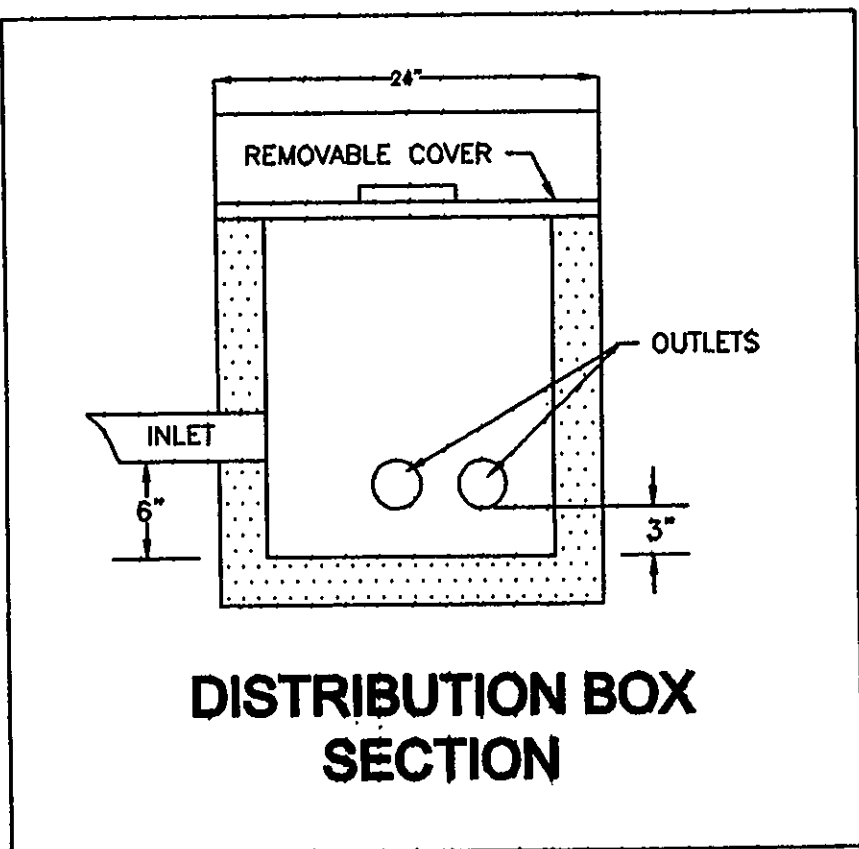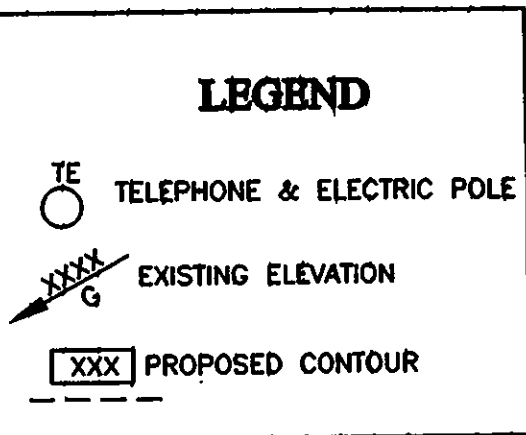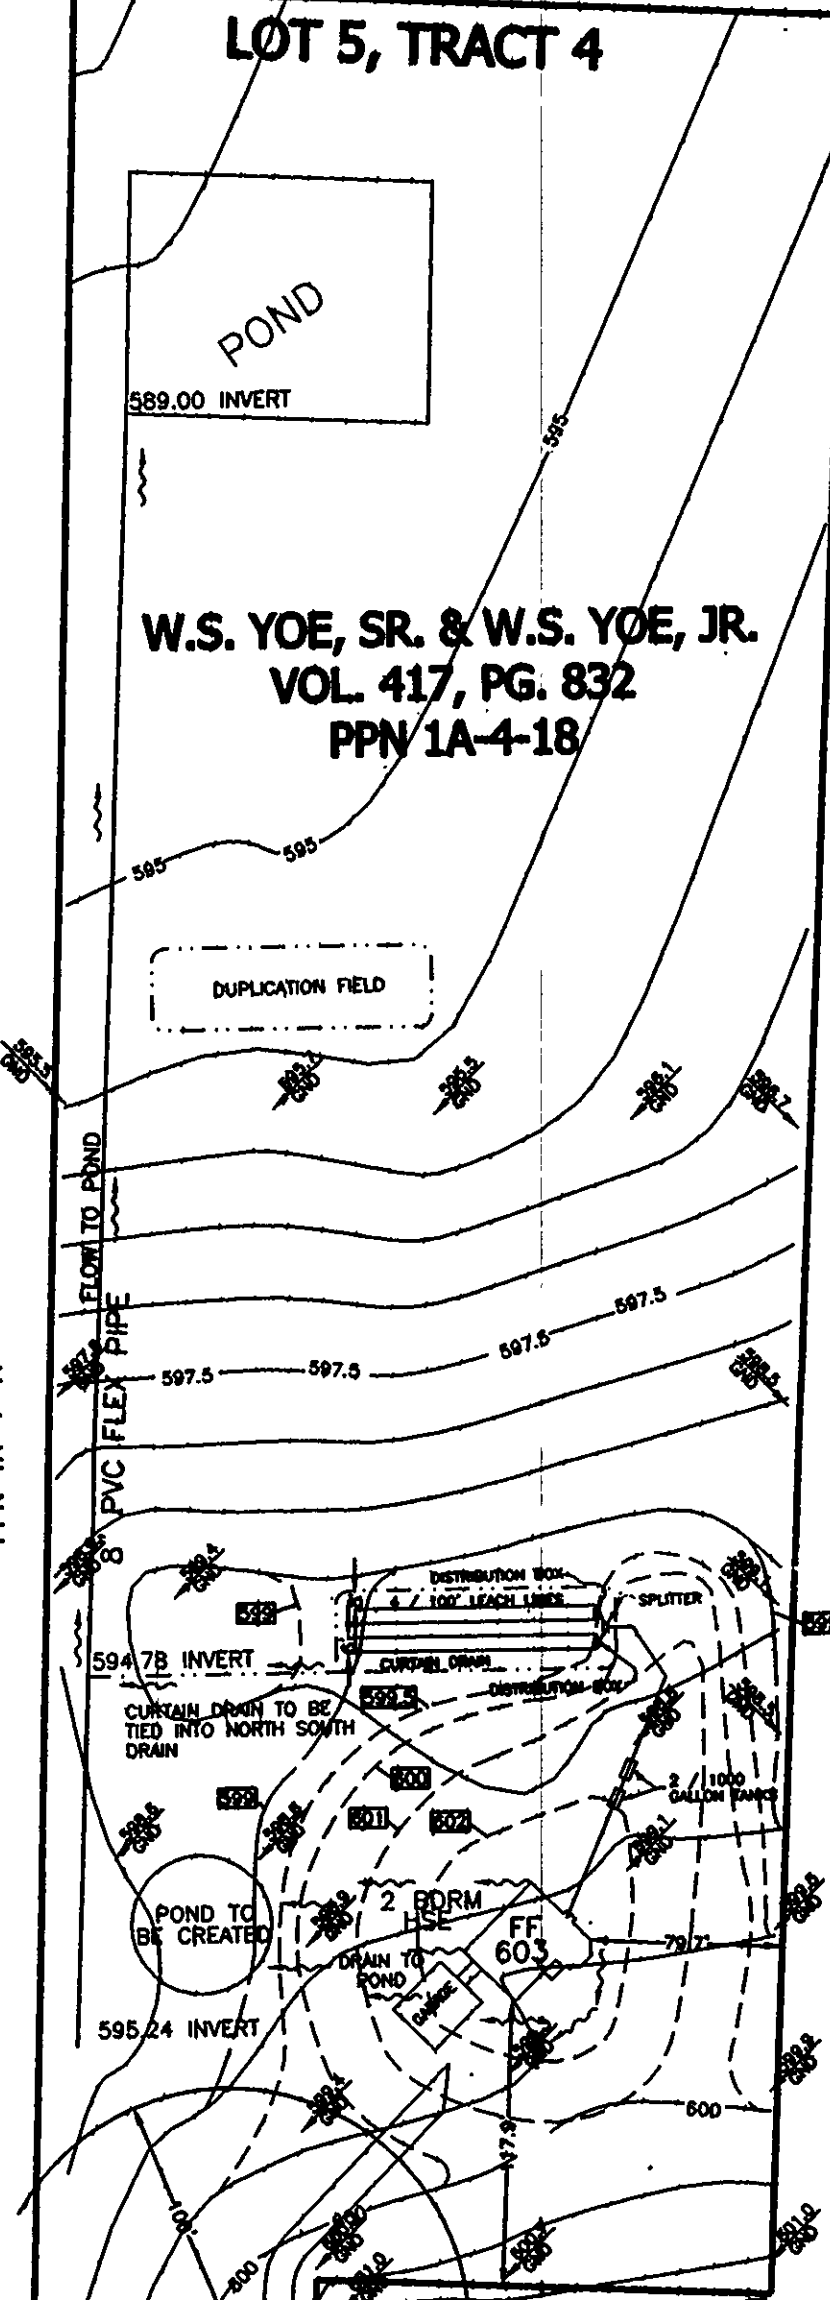

NOTES:

- " THE STANDARD LEACH TRENCH IS 24 INCHES, HOWEVER THE TRENCH CAN VARY BETWEEN 18 INCHES AND 24 INCHES DEEP, NO GREATER. WHEN TRENCH DEPTH VARIES, THE SAND AT THE TOP OF TRENCH WILL VARY FROM 10 TO 18 INCHES DEEP. "
- " ET TRENCHES MUST BE 18 INCHES DEEP. NO DEEPER. "
- " CURTAIN DRAIN MUST BE AT LEAST 6 INCHES DEEPER THAN BOTTOM OF LOWEST TRENCH. "

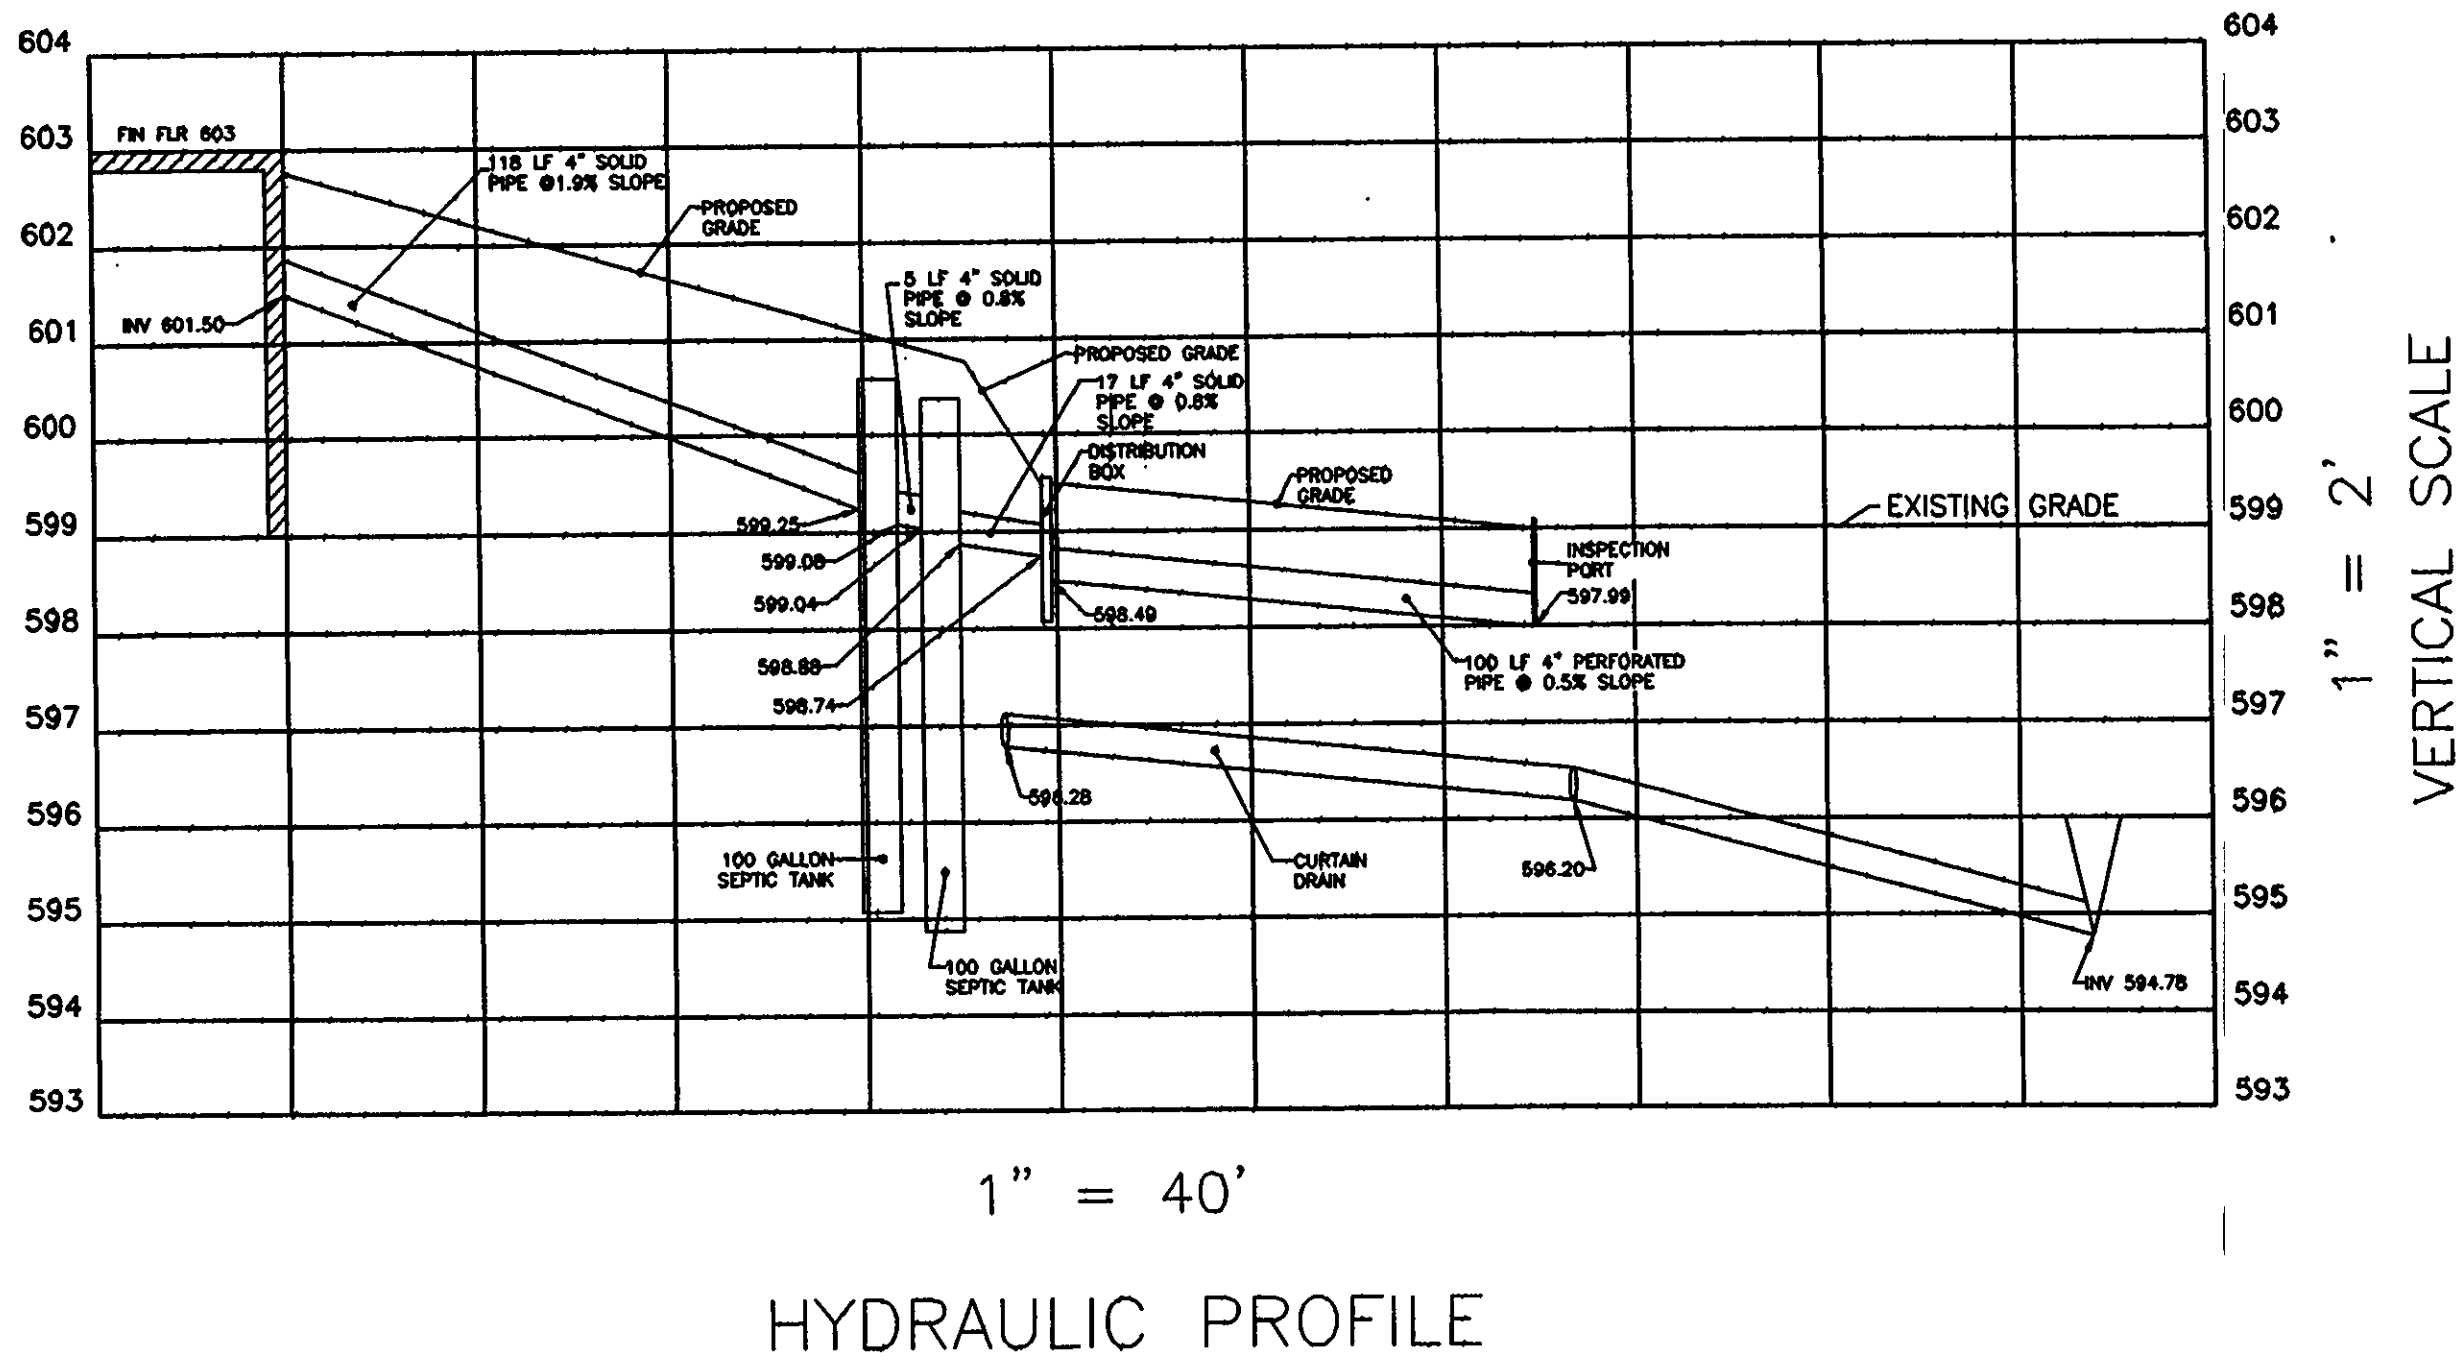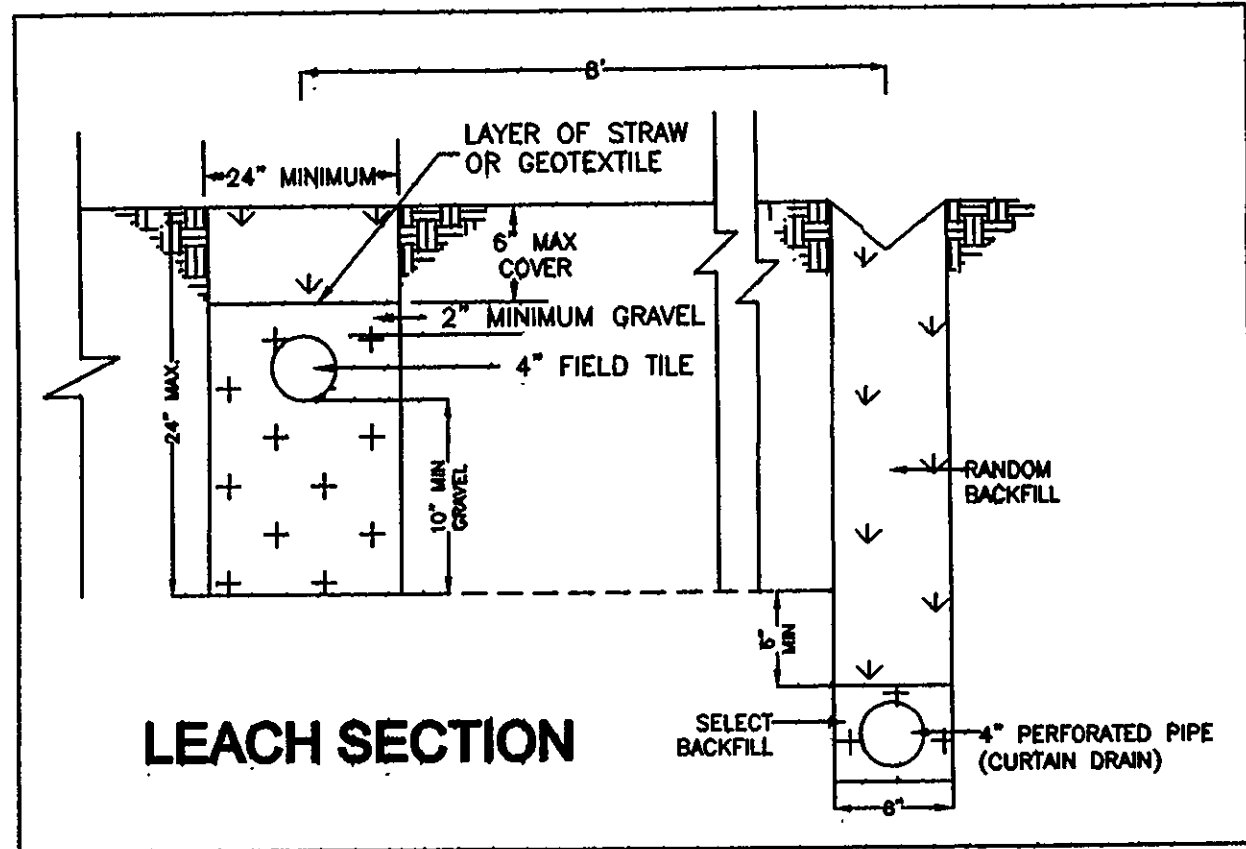

80' 0' 80' 160'
SCALE: 1" = 80'

REVISED JUNE 8, 2001

" I THE UNDERSIGNED HEREBY CERTIFY THAT THE TOPOGRAPHY SHOWN HEREON INDICATED BY 1' CONTOURS AND ELEVATIONS REPRESENTS AN ACTUAL FIELD SURVEY MADE BY ME ON THE 1ST DAY OF MAY, 2001 AND THAT THE ELEVATIONS WERE TAKEN AT APPROPRIATE INTERVALS AND THAT AS OF THAT DATE THE EXISTED AS INDICATED HEREON. "

DATE: June 8, 2001

[Signature]
TIMOTHY E. STOCKER, P.S. 7245



MIDDLE RIDGE ROAD, 55' R/W
DAYTON ROAD, 60' R/W

6 ACRES