



HYDRAULIC PROFILE
DATE: 10-15-50
VERT. 1:20

CHANGING LOT FROM 102.5 TO 102.5

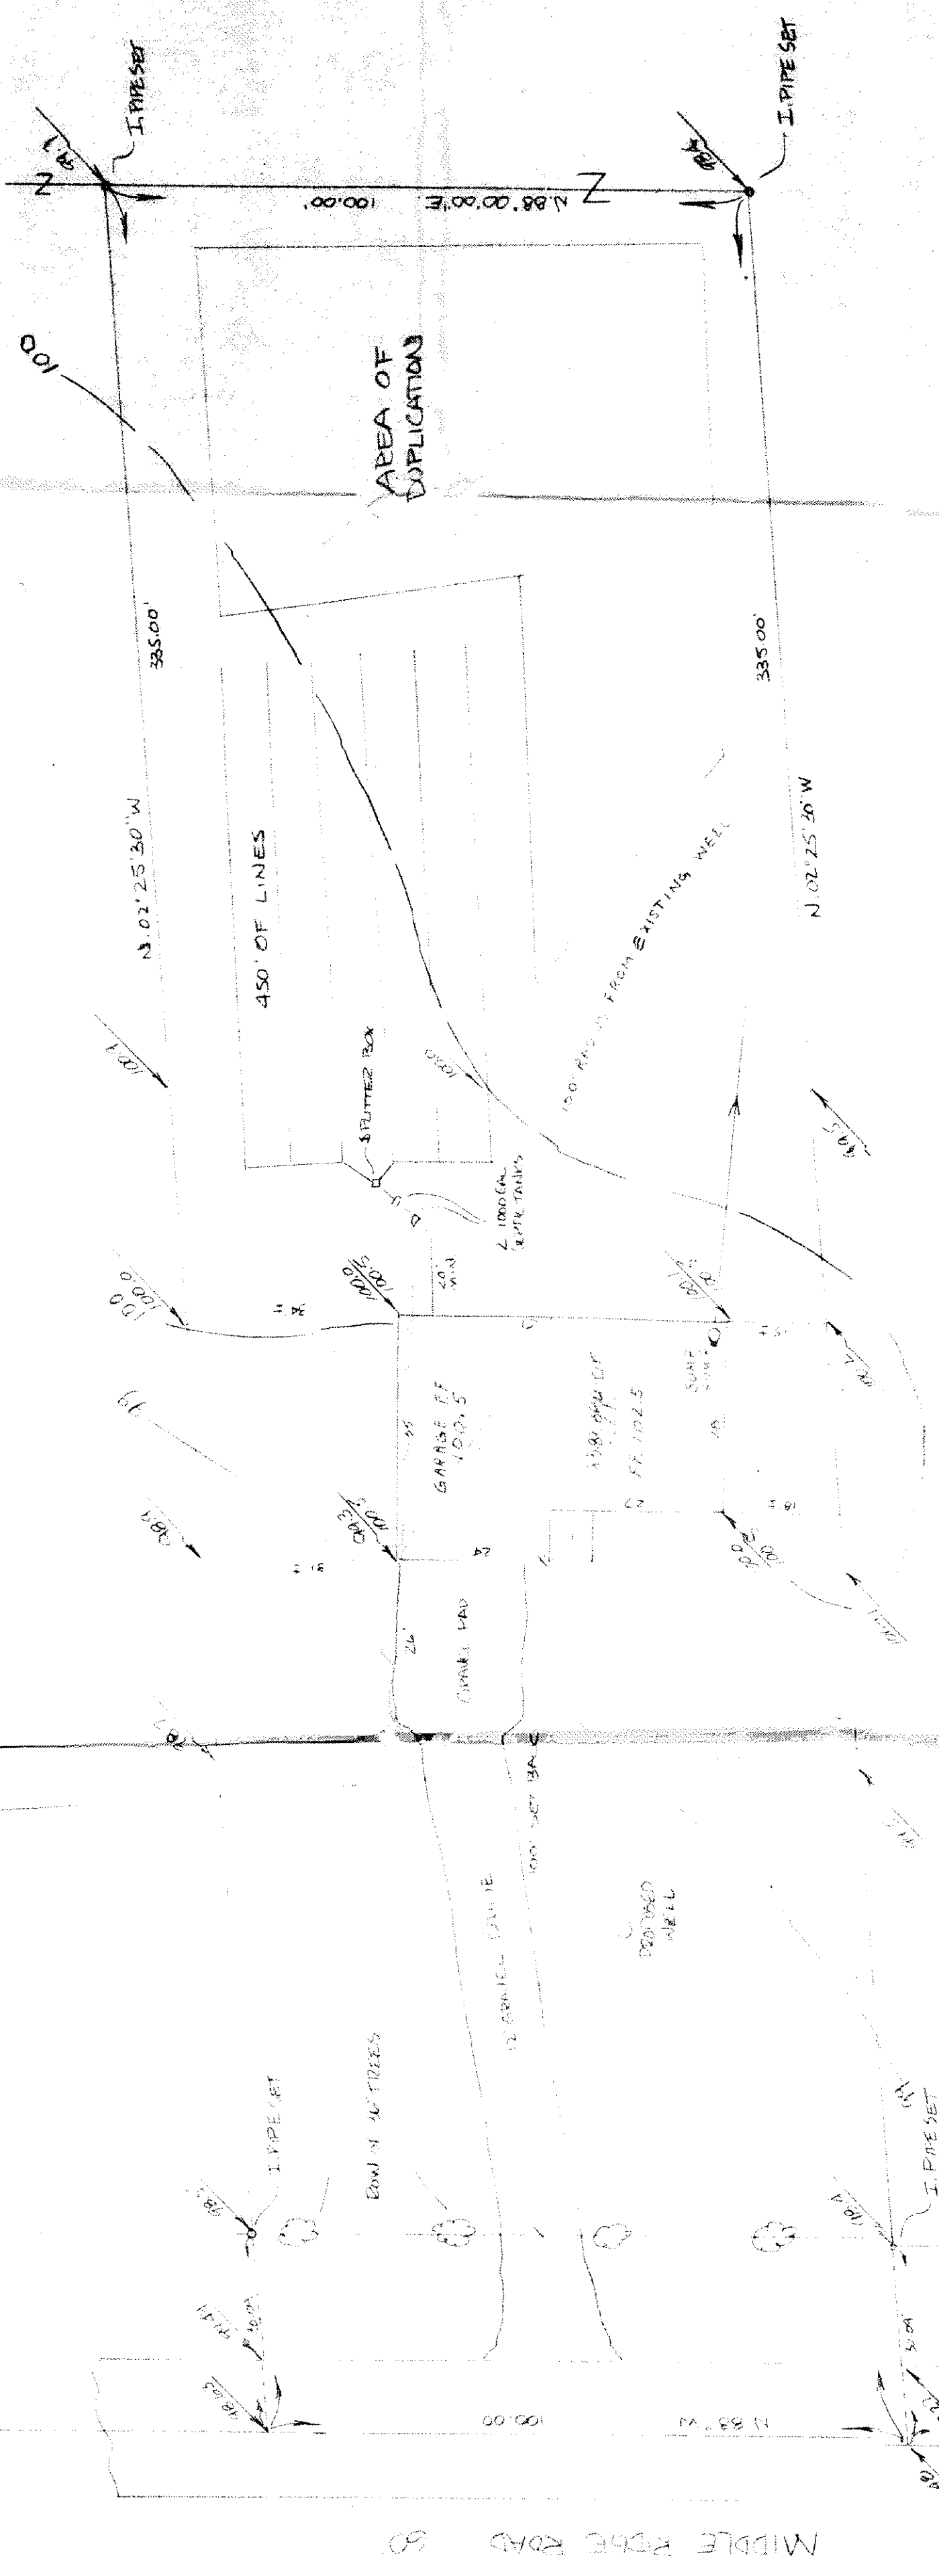


- A. To be located in finished grade
1. Sewer line
 2. Sewer box
 3. Distribution box
- B. No water drains or downspouts to be discharged into septic tanks
- C. All waste water to be discharged into septic tanks

NORTH

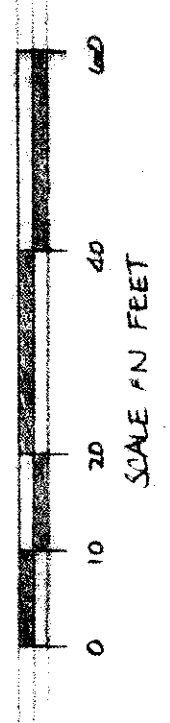

W. HOLLINGSHEAD
102.5' x 102.5' x 102.5'
L.C.D.R.
P.D. NO. 1A-59-01

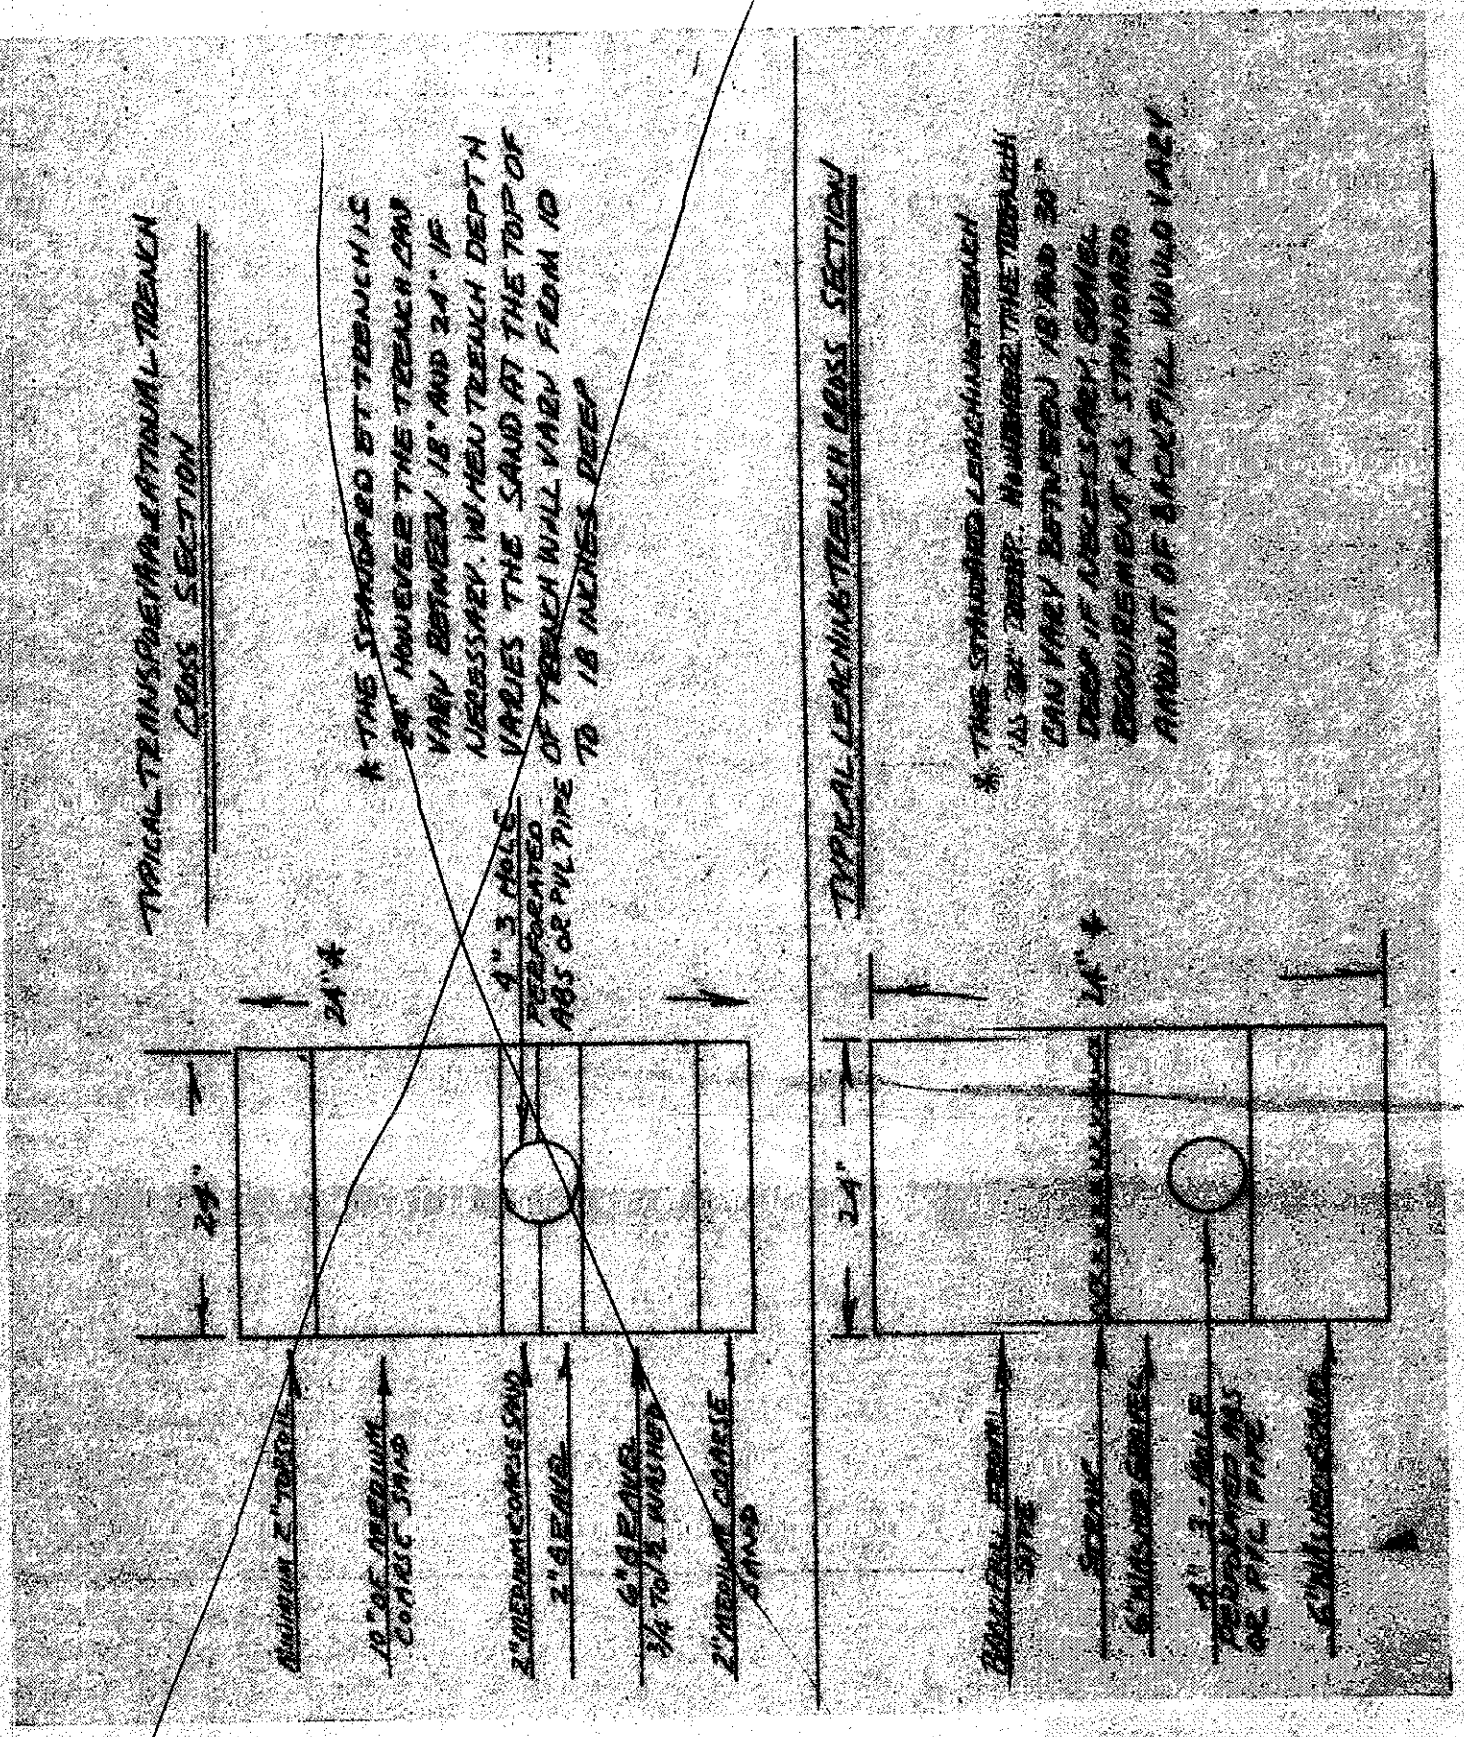

NOTES:

1. DOWNSPOUTS SHOULD BE DIRECTED AWAY FROM THE SEWAGE SYSTEM.
2. HOUSE SHOULD BE EQUIPPED WITH WATER SAVING TOILETS AND SINKS.
3. MANHOLES ON SEPTIC TANKS, SPLITTER BOX AND DISTRIBUTION BOXES MUST BE BROUGHT UP TO GRADE.

I, THE UNDERSIGNED, HEREBY CERTIFY THAT THE TOPOGRAPHY SHOWN HEREON BY ONE FOOT CONTOURS AND ELEVATIONS REPRESENTS AN ACTUAL FIELD TOPOGRAPHIC SURVEY MADE BY ME ON THE 28TH OF APRIL 1954 AND THAT THE ELEVATIONS WERE TAKEN AT APPROPRIATE INTERVALS AND THAT AS OF THAT DATE THEY EXISTED AS INDICATED HEREON. IRON MONUMENTS WERE FOUND OR SET AT ALL LOT CORNERS AS SHOWN ON MAP.

WILLARD E. SCHADE
REGISTERED SURVEYOR
RES. NO. 6008

Reviewed and Accepted
LAKESIDE GENERAL HEALTH DISTRICT
DATE: 6-24-54
THOMAS P. GILLES, P.E.
L.C.D.R.
P.D. NO. 1A-59-01

LOW YIELD WATER
FIXTURES REQUIRED
ON ALL
Showers
Toilets

JAN 22 1954



SEWAGE DISPOSAL PRINT MUST BE OBTAINED BY A LAKE COUNTY LICENSED INSTALLER BEFORE INSTALLATION IS STARTED.

Grading Firm Approved
as shown and/or noted
THOMAS P. GILLES, P.E.
Lake County Engineer
By: T.P.G. Date: 6-22-54

SCHADE SURVEYING COMPANY
951 6454

SEPTIC SYSTEM SITE PLAN FOR
SAL. HOLLINGSHEAD