

SITE PLAN
FOR
OHIO TECH CONSTRUCTION CO.
MADISON TOWNSHIP LAKE COUNTY
STATE OF OHIO
OCTOBER 19, 2003


TOPOGRAPHY SURVEY WAS PERFORMED
BY GREENLAND CONSULTANTING

This project is exempt from
ESC Plan Review
Date 10-28-03
Lake SWCD

REVIEWED AND ACCEPTED
LAKE COUNTY GENERAL
HEALTH DISTRICT

Date 10-24-03
David B. Jones

SEWAGE DISPOSAL PERMIT MUST BE
OBTAINED BY A LAKE COUNTY LICENSED
INSTALLER BEFORE INSTALLATION IS
STARTED

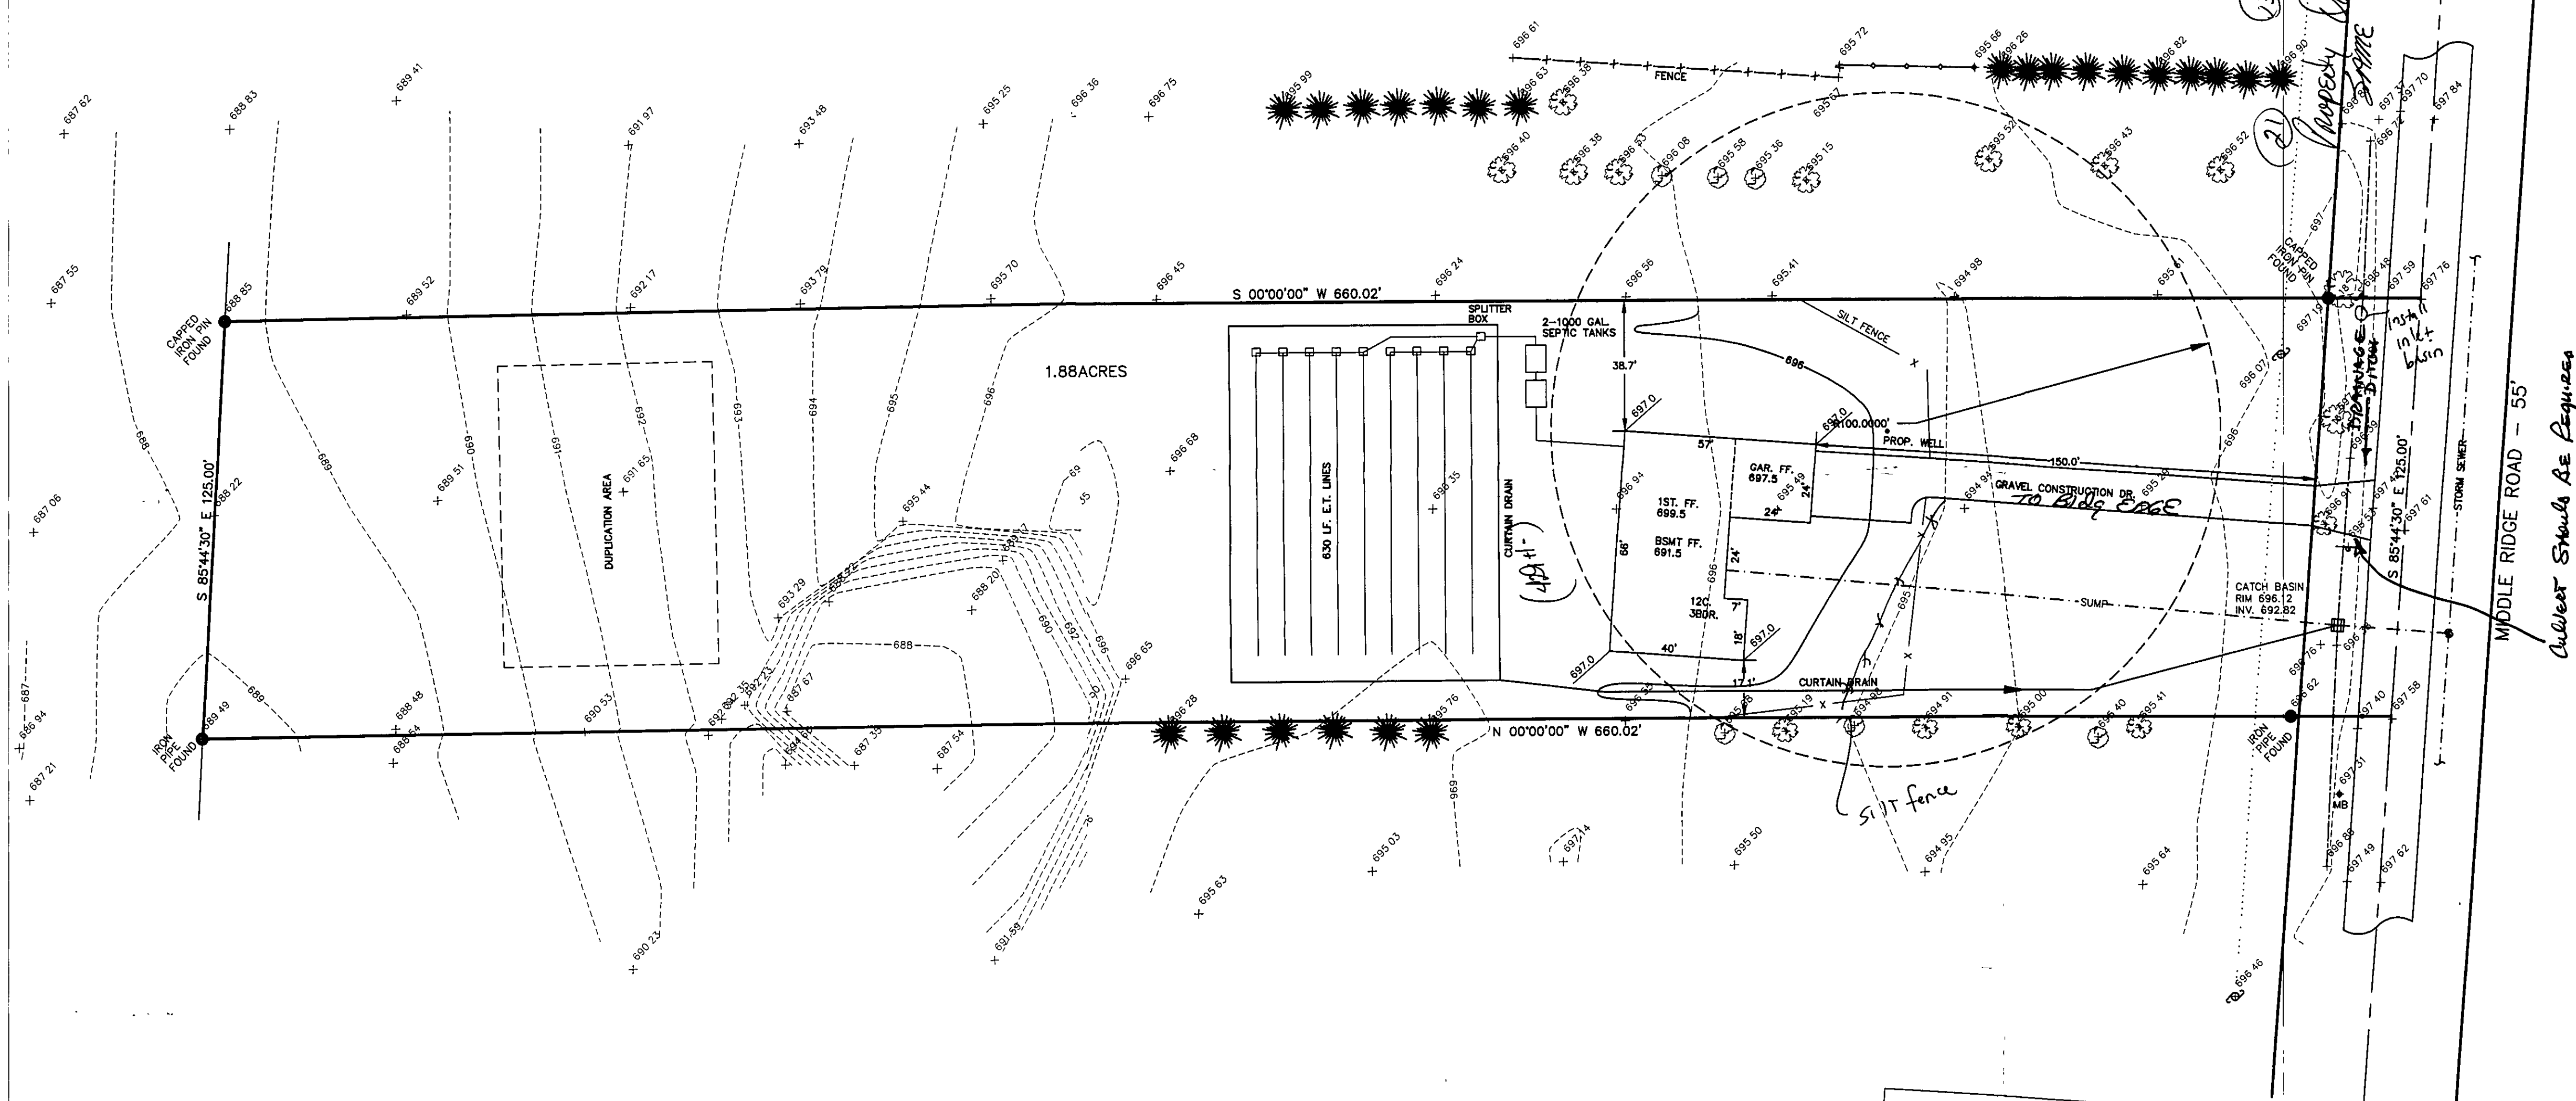

MIDDLE RIDGE ROAD - 55'

Adverse Should Be Requested

* 11 04 Sensors & Elevation controls apply
* Station where plan not recovered


B33 Middle Ridge Road

Stormwater Management Plan
Approved as shown and/or noted
JAMES R. GILL, P.E.
County Drainage Engineer
By 6/11/04 Date 10/29/03
Install silt fence and catch
basin as shown

ROOF DRAINS
SHALL DISCHARGE
TO SPLASH BLOCKS.


ALL DISTURBED AREAS TO
BE TEMPORARY SEEDING.

GRAPHIC SCALE

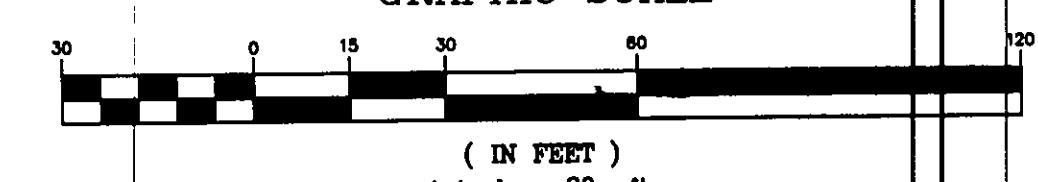

"I, undersigned hereby certify that
this topography indicated by 6", 1", or 2"
conts. and elevations shown hereon
reprint an actual field survey made by
me the 02 day of 10, 2003
and the elevations were taken at
appropriate intervals and that as of that
date existed as indicated hereon."

Na Reg. No. 47774

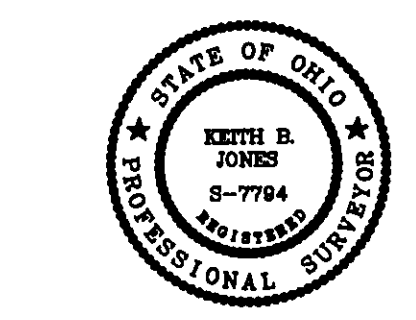

KEITH B. JONES
REGISTERED LAND SURVEYOR #7794
AAA LAND SURVEYING, INC.
100 CENTER STREET, SUITE 150
CHARDON, OH 44024
(440) 286-2393

