

SITE PLAN

for
ROBERT & MARY CHANDLER
Part of Lot 1, Tract 1
Madison Twp.
Lake Co.
State of Ohio
Nov. 1985
1"=30'

1A-76-16






Bernard D. Westfall, P.S.
A TERRA SURVEY CO.
Jefferson, Ohio

"As Built Certification"
I, hereby certify that the circled grades are existing
finished grades checked in field on
19 by surveying and are correct to the best of
my knowledge and belief.

Grading Plan Approved
as shown and/or noted
THOMAS P. GILLES, P.E.
Lake County Engineer
Date 11-7-85

NOTE: Reference - Lot perimeter taken from Survey by Debevec - Solo &
Associates, Inc., March 1983 (Jan. 1985)

Existing Grades
Proposed Grades

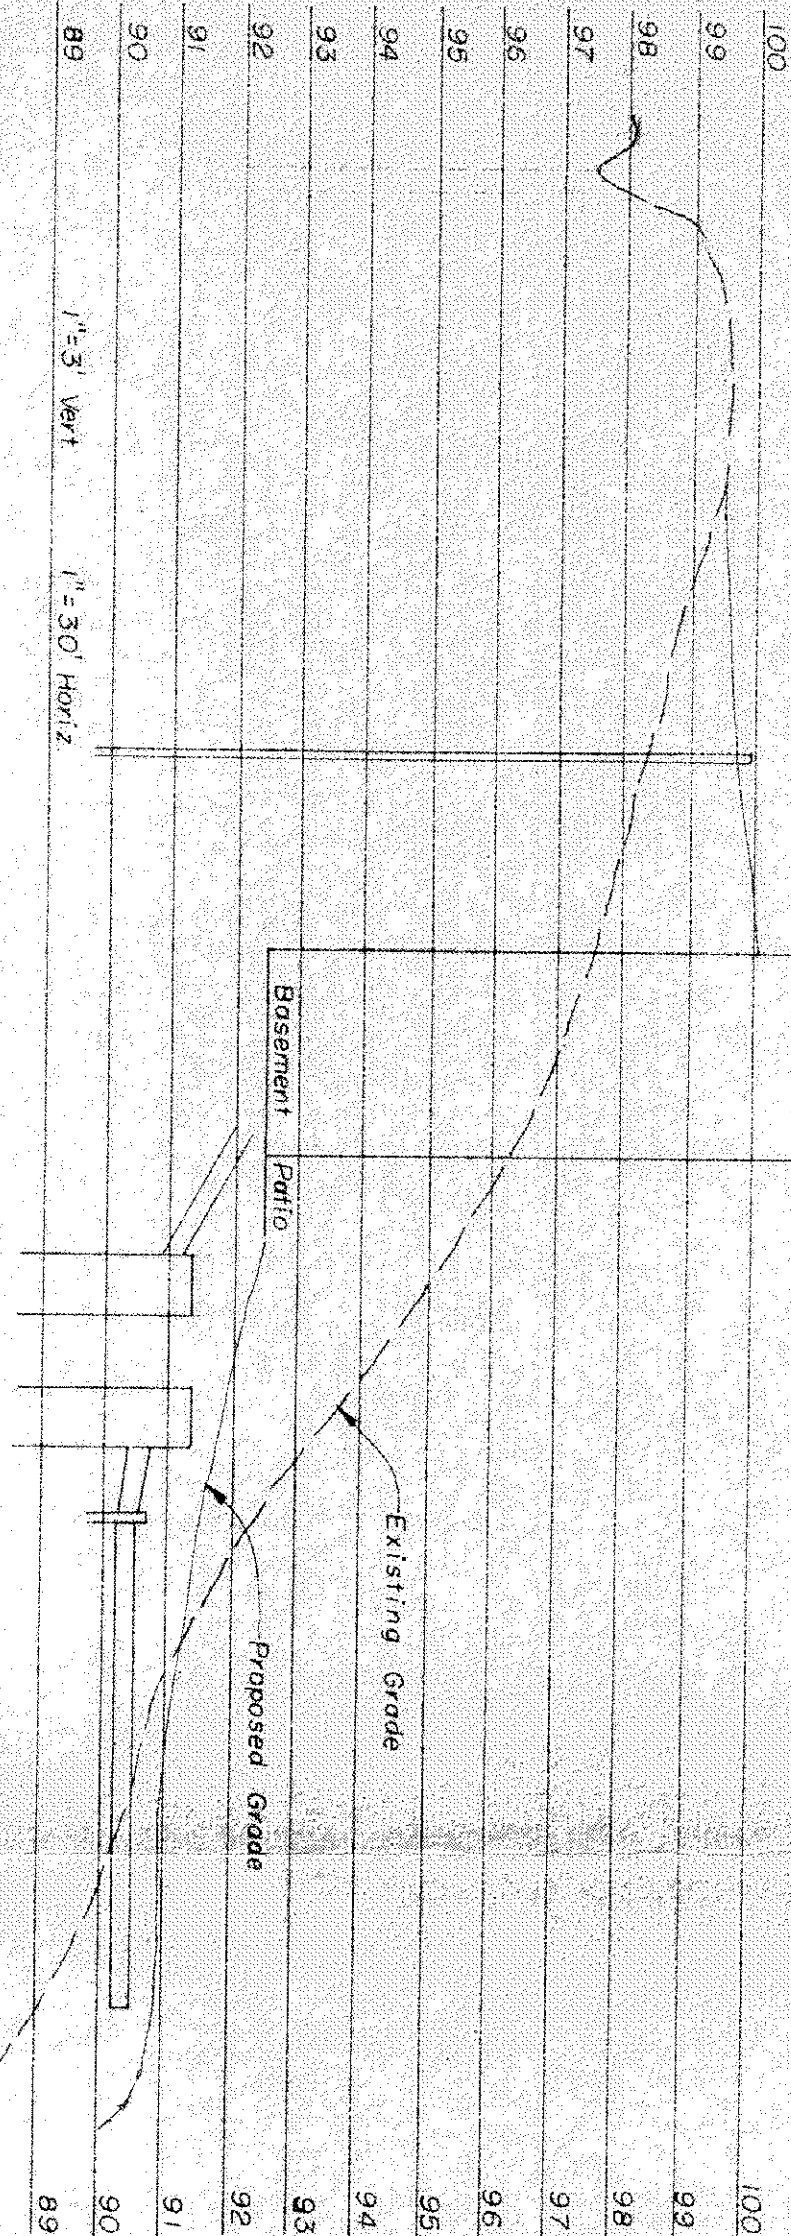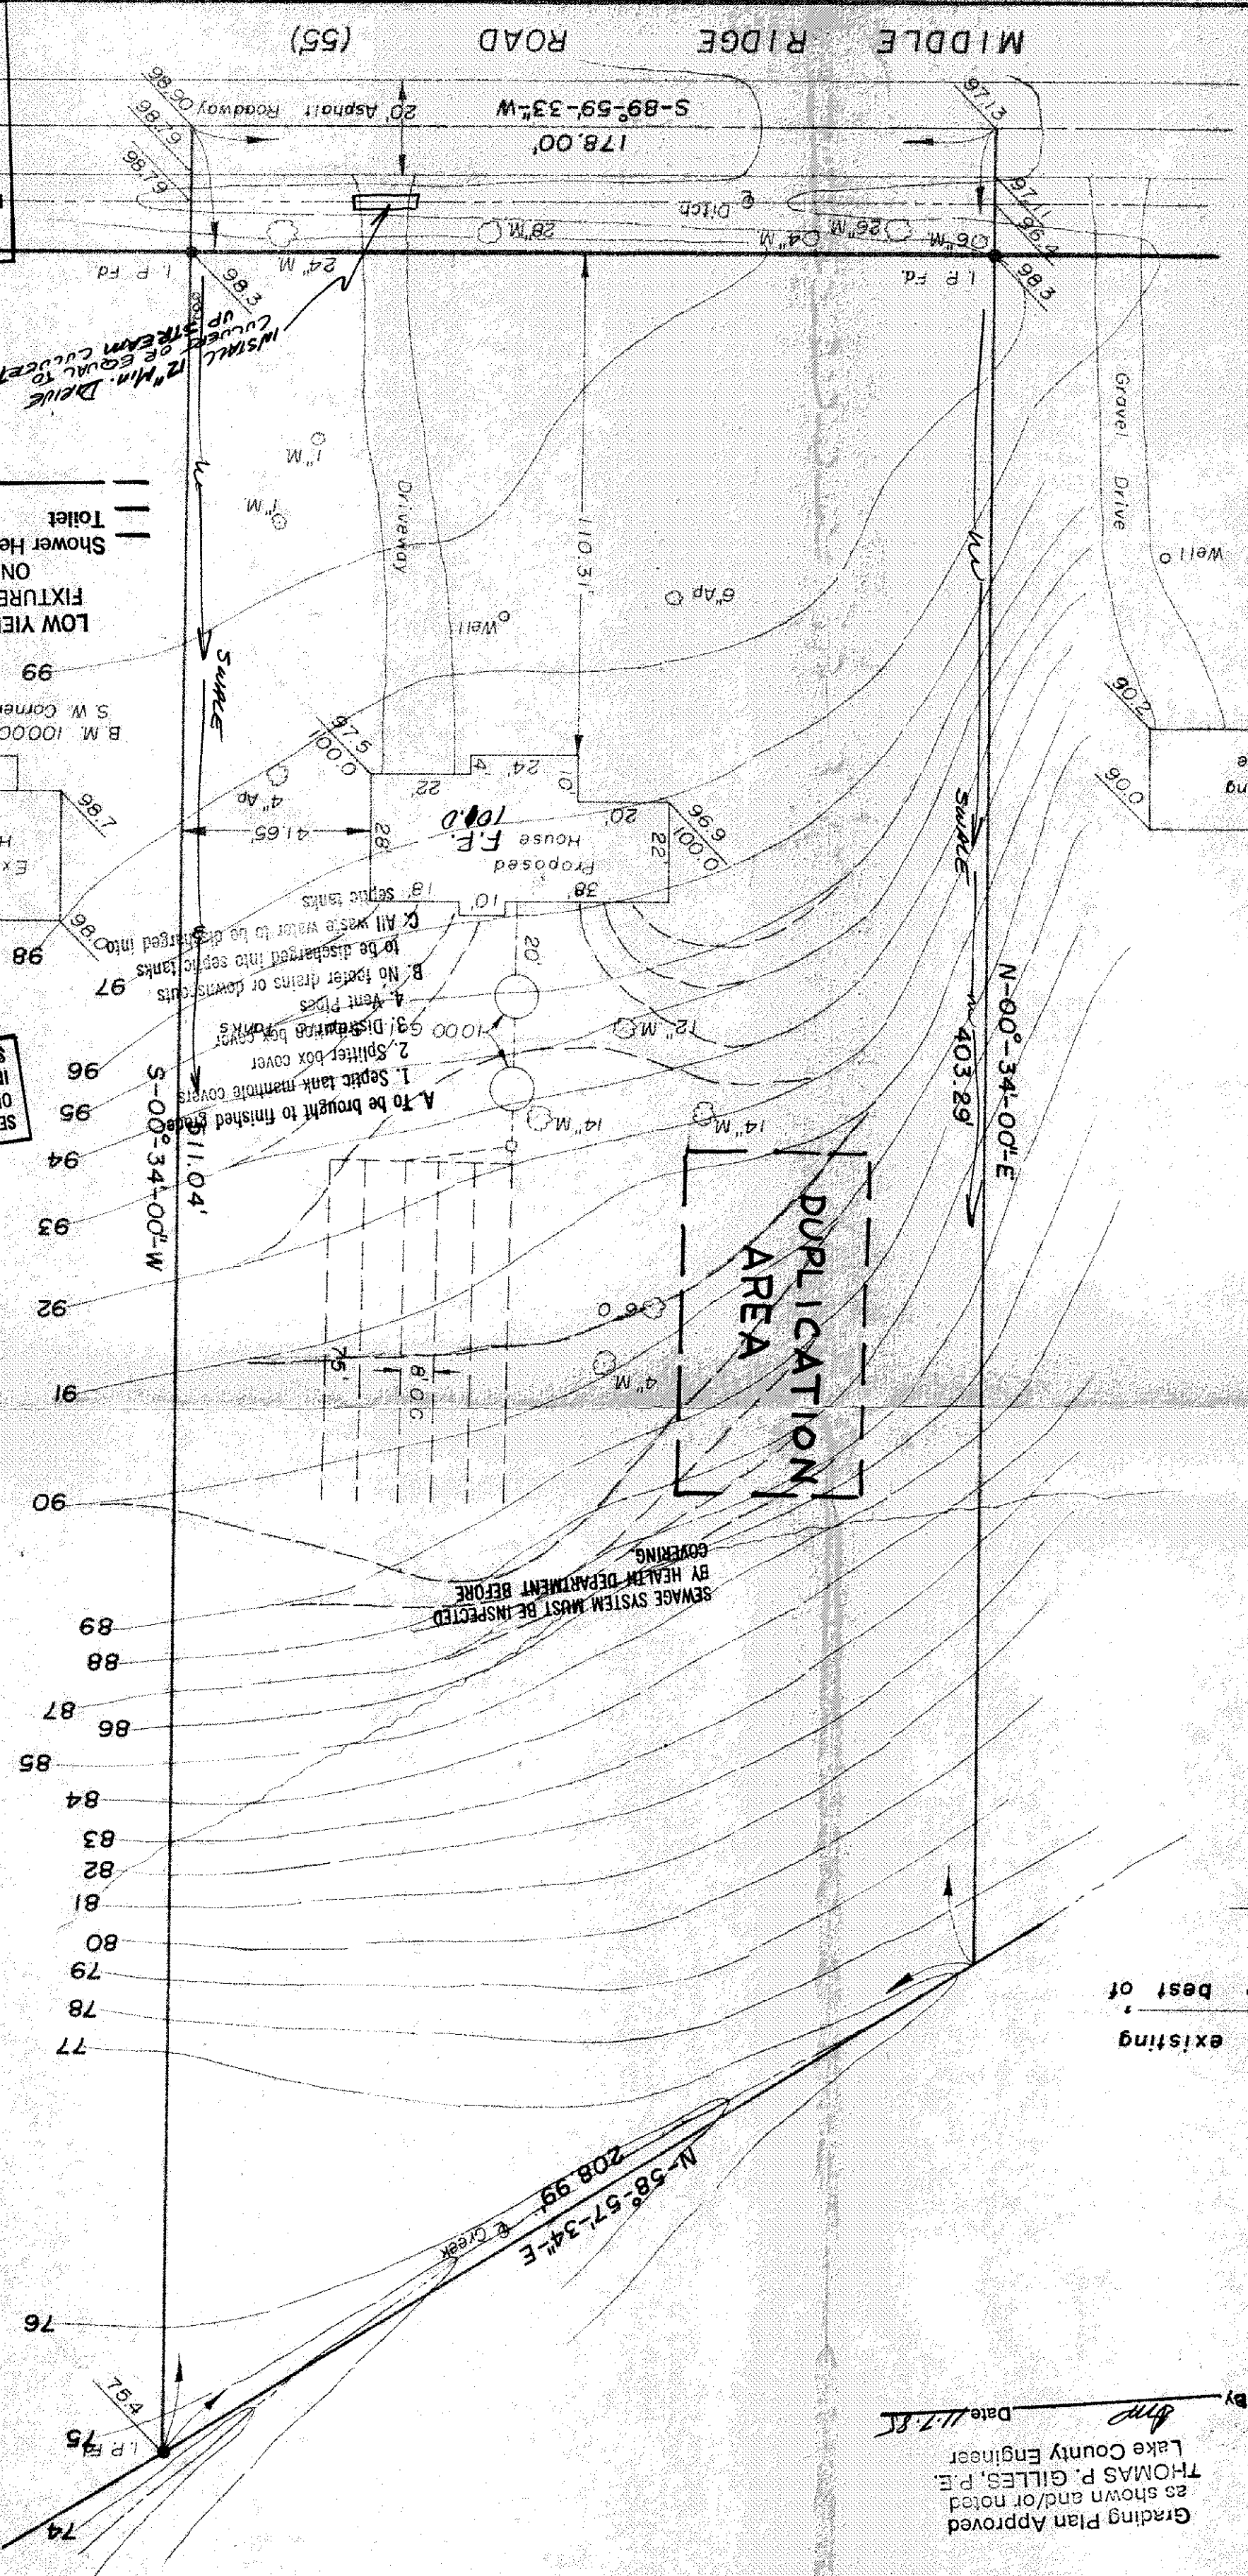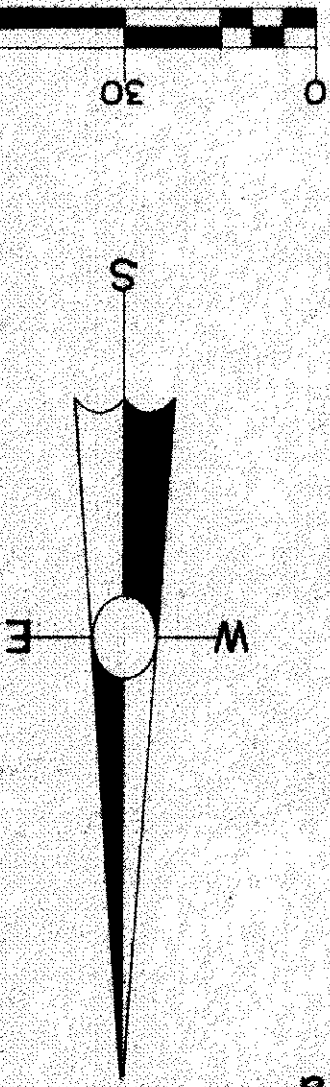

Reviewed and Accepted
Date 11/5/85
JOEL LUCIA, R. S., M. P., H.
Health Commissioner
BY [Signature]
LAKE COUNTY GENERAL HEALTH DISTRICT

APPROVED
MADISON TWP. ZONING
Permit 11712
Zoning Inspector [Signature]