
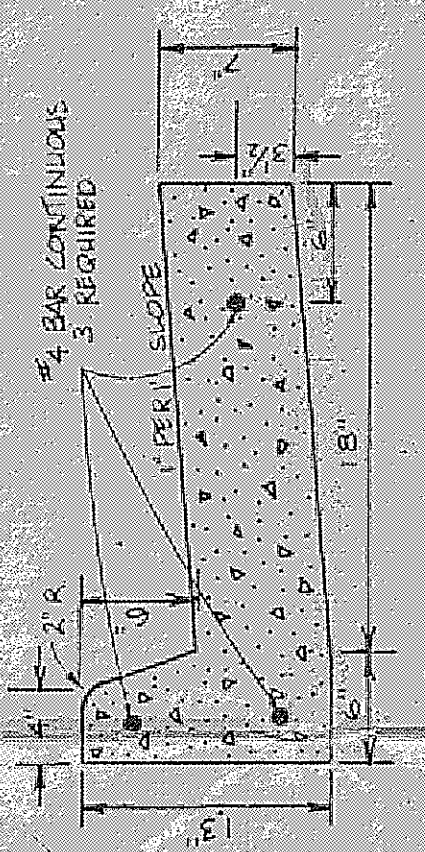
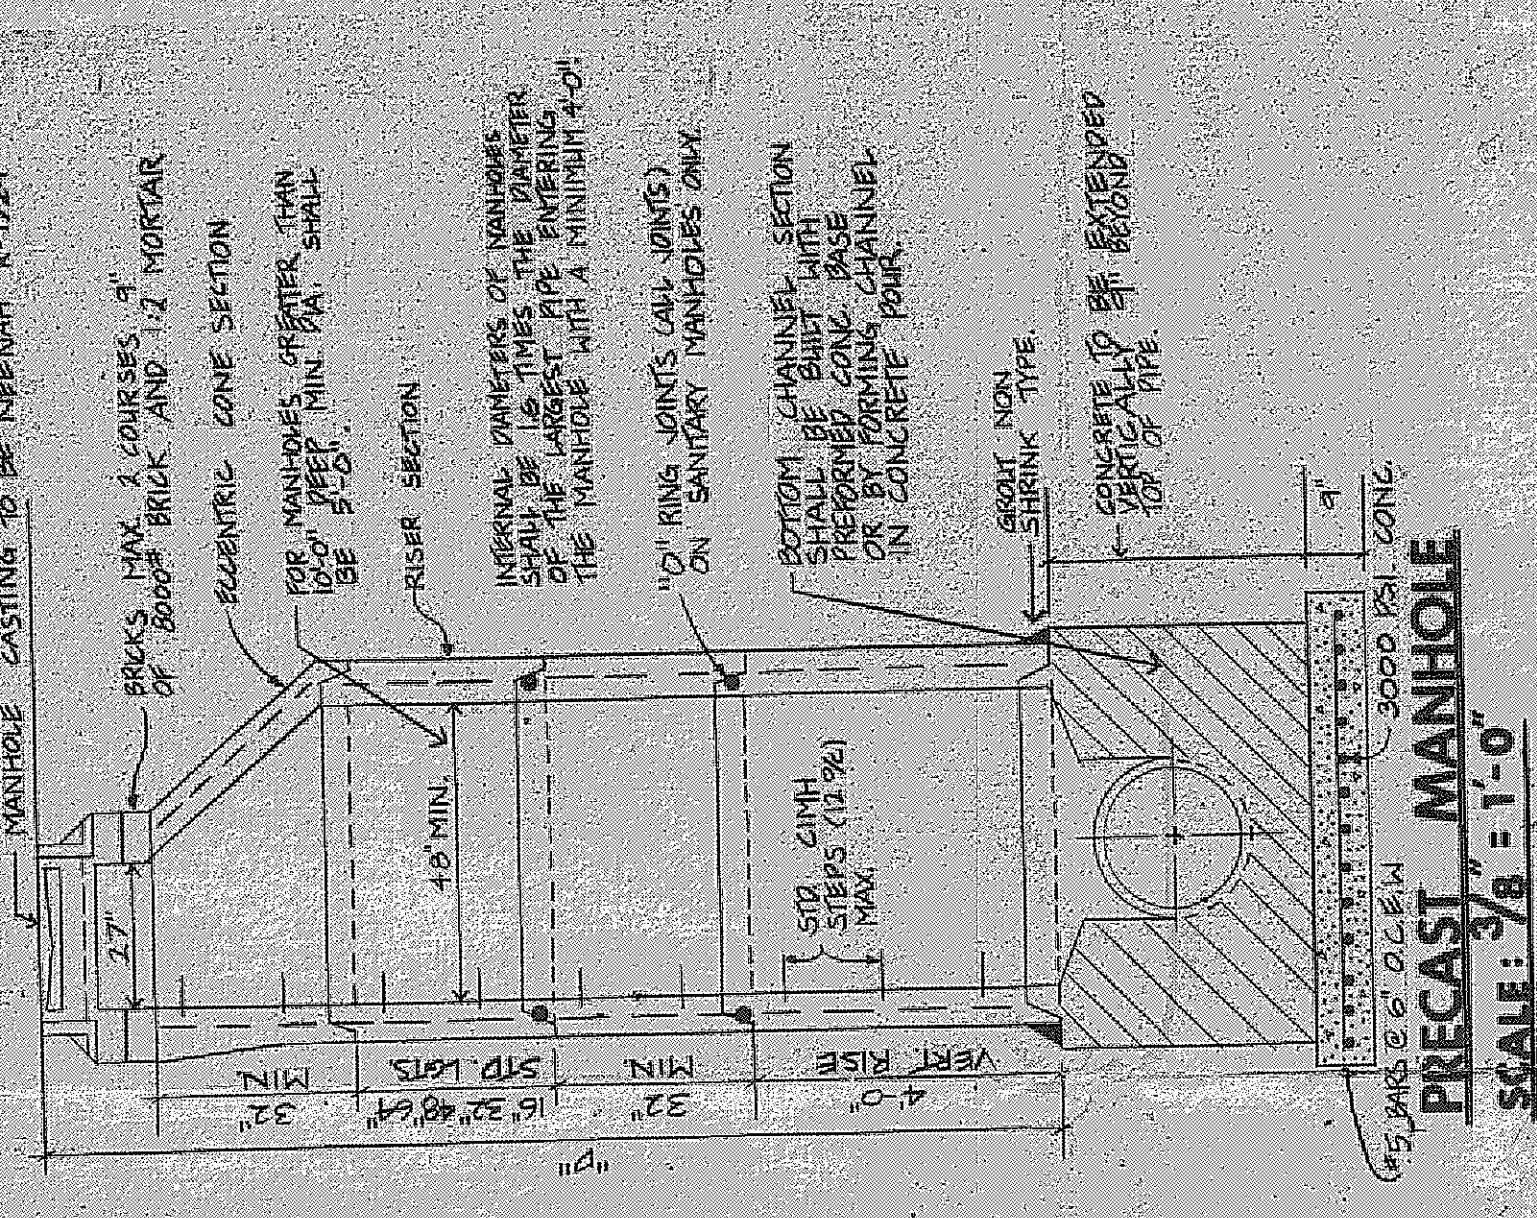
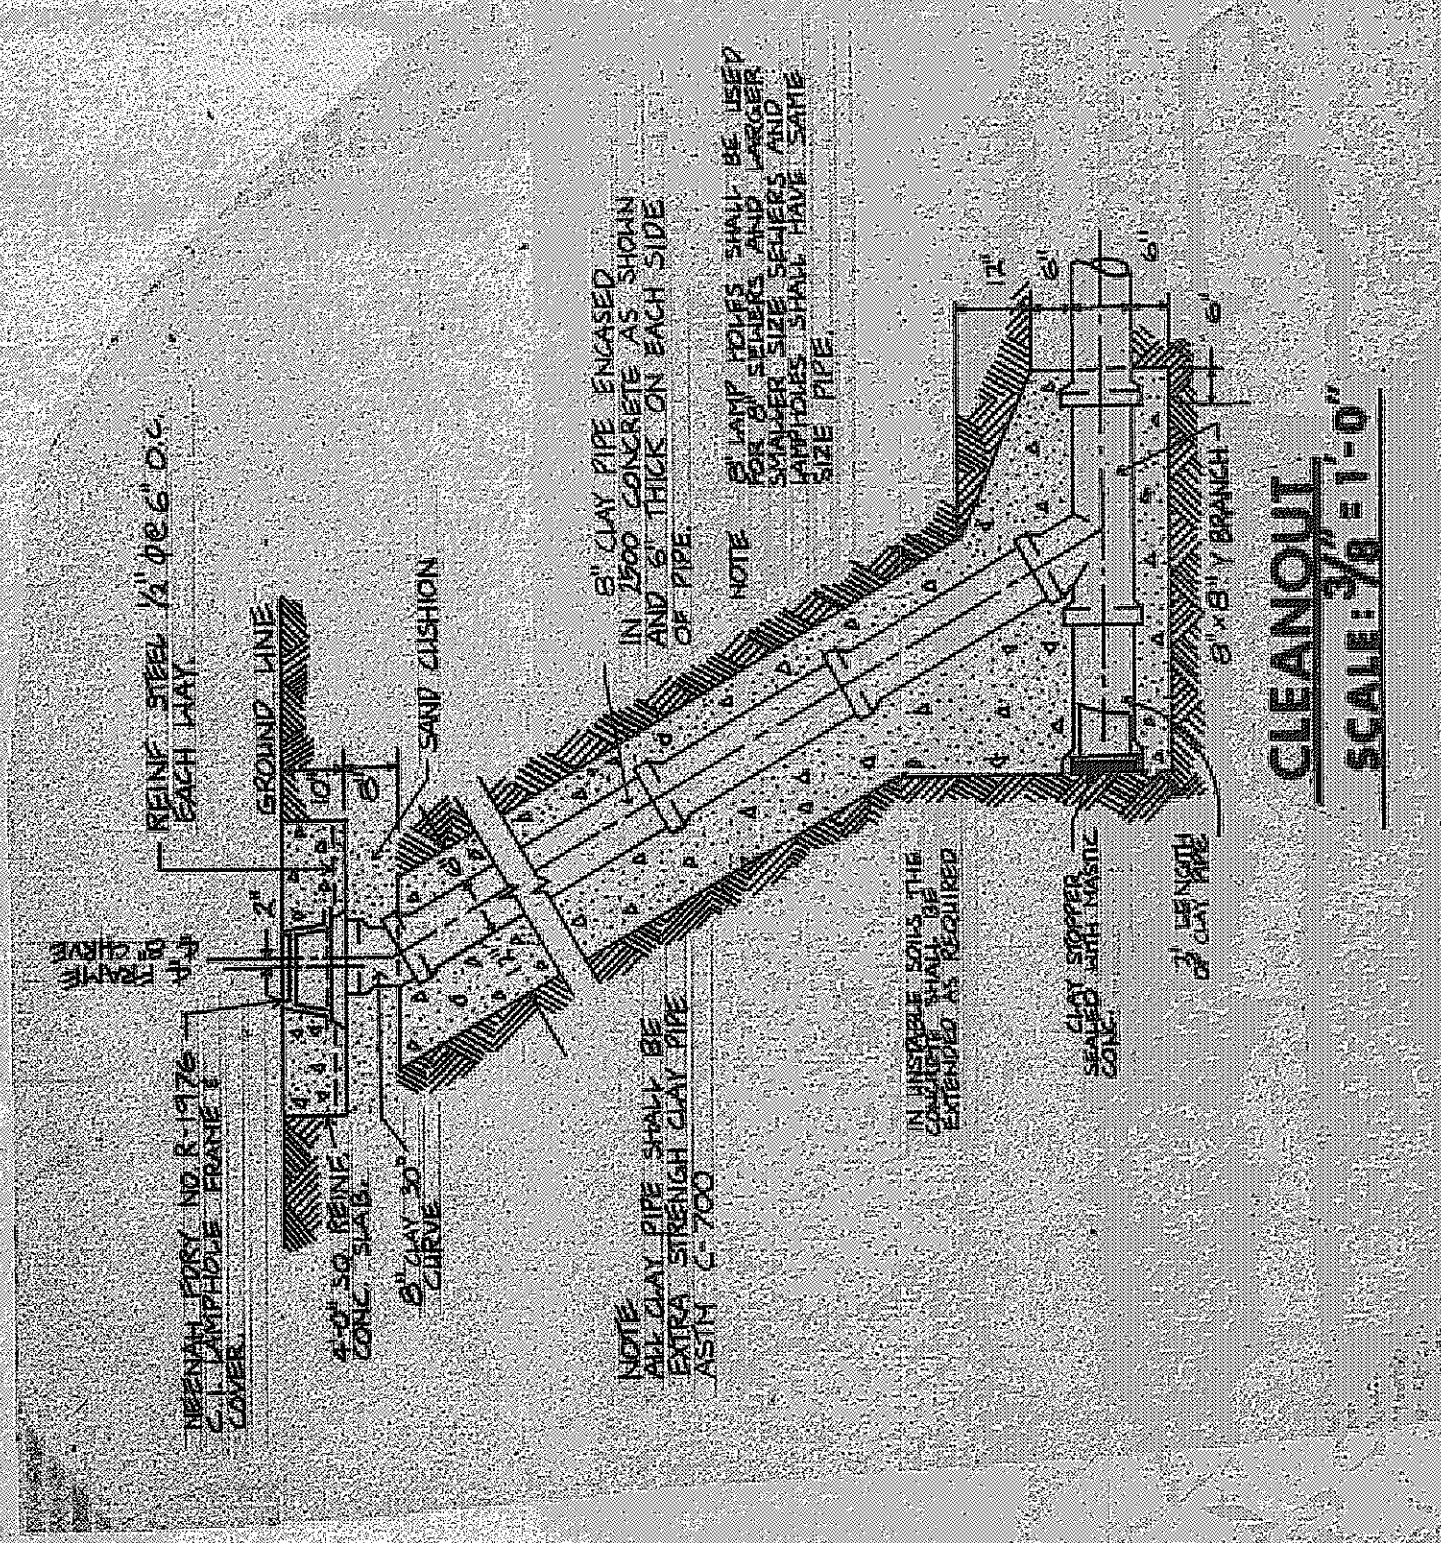


[illegible]

- 1) CUT CONCRETE TO BE 3000 PSI 28 DAY AGE TRAINED PERSON PLUMBED WITH ASHO
- 2) APPROVED WOOD MEMBRANE SEAL
- 3) MINIMUM SLOPE ALONG CURB 0.50%
- 4) MAXIMUM SLOPE ALONG CURB 5.00%
- 5) 1/2" THICK GUTTER (ASTM W-8) DRAINAGE
- 6) PROVIDE 3/4" BARS CONTINUOUS EXCEPT AT EXPANSION JOINTS
- 7) PROVIDE 4" BARS THROUGH DOWEL JOINTS
- 8) PROVIDE 1/2" LONGER
- 9) AT EXPANSION JOINTS PROVIDE #4 BARS AND PROVIDE 1" DIA. 1/2" LONG DOWEL BARS EITHER WITH EXPANSION CAPS OR EPOXY FILLS
- 10) PROVIDE 2" MINIMUM COATING

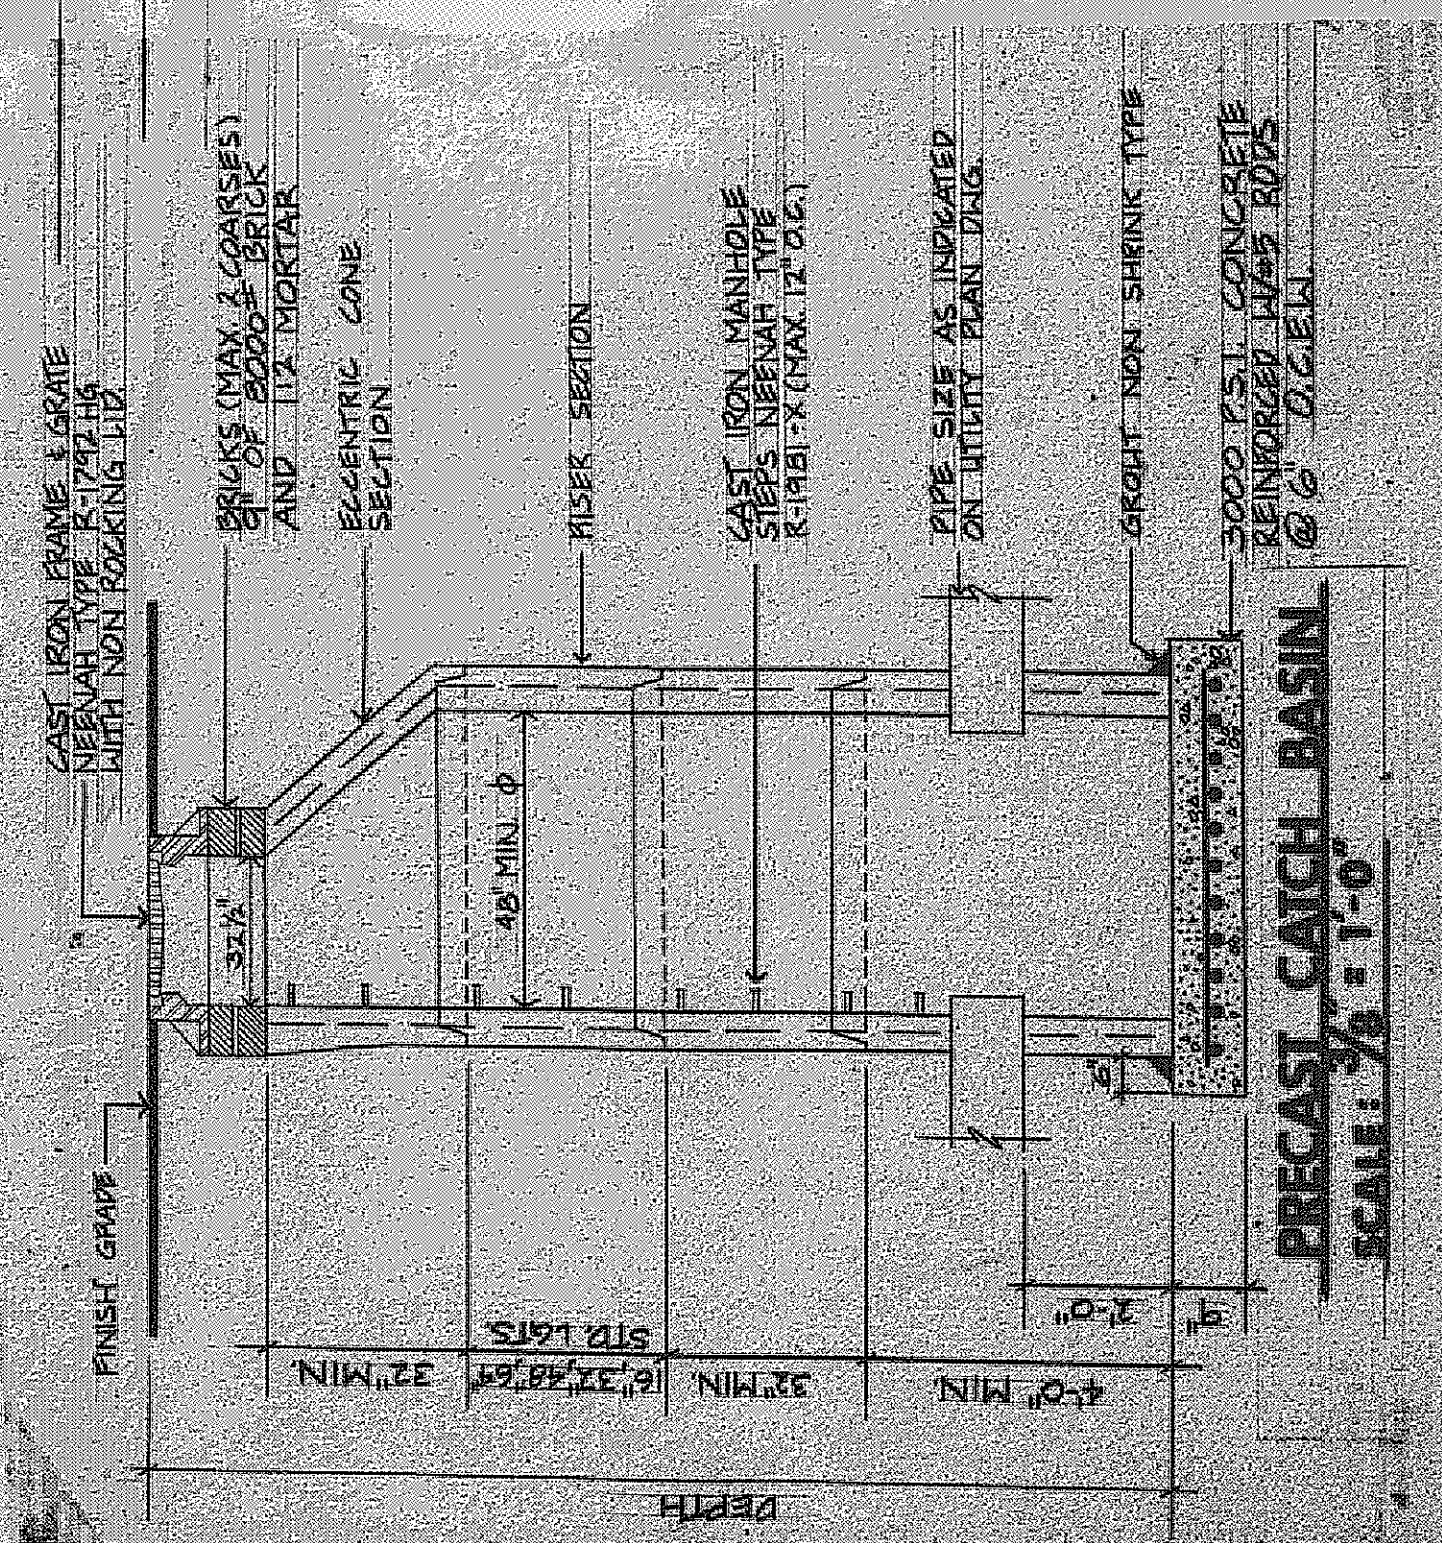

2017.11.11 星期六 晴
 今天去参加了在老舍纪念馆举行的老舍先生诞辰120周年纪念活动。上午九时，我们准时到达纪念馆，那里已经聚集了许多市民。纪念馆内，老舍先生的生平事迹被详细地展示出来，从他的早年生活到他的文学创作，再到他的革命经历，无不让人感叹。下午，我们观看了老舍先生的生平事迹展览，展览通过大量的文字、图片和实物，生动地再现了老舍先生的生平。最后，我们还参加了老舍先生的追思会，会上，大家共同缅怀了老舍先生的伟大贡献。

By Ans Date 5-5-80
Grading Plan Approved
as shown and/or noted
THOMAS P. GILLES, P.E.
Luke County Engineer

THIS PLAN PREPARED BY:
 RICHARD E. BOHLEN & ASSOC. INC.
 13124 SHAKER SQUARE, CLEVELAND, OHIO
 R.E.B. 02/01 1-28-80

SCALE: 1"=50'

ISSUED FOR PERMIT ONLY 2/27/80

STATE OF OHIO
RICHARD KEEBER
REGISTERED PROFESSIONAL ENGINEER

R. J. Keeber

9703

GRADING
PLAN

DATE

NORTH MAP 601
BY H. R. P. 200 1/2" = 100' 0"

OHIO
DEPT. OF HIGHWAY

DRAWING
NUMBER

C-1