



Grading Plan Approved
as shown and/or noted
THOMAS P. GILLES, P.E.
Lake County Engineer

2046 PERMIT # 1917

SITE PLAN: QUALITY BUICK
OF A PARCEL ON NORTH RIDGE ROAD, MADISON, ALA.

DATE: 11-20-1986
DATE: APRIL 1986


APPROVED BY
DRAWN BY

TRACT 1 OF ORIGINAL MADISON TWP. LOTS 1 & 2 IN TRACT 1 & PART OF LOTS 1 & 2 IN TRACT 2
THIS IS TO BE ABOLISHED

EASE ILLO.
855.000

SUBSEQUENT TO BEYOND
ADJACENT

DRAINING NUMBERS
855.000

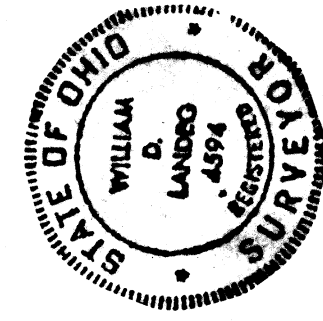

PLAT OF TOTAL PARCEL