


APPROVED
MADISON TOWNSHIP ZONING
DATE 9/21/98
BY JH 15977

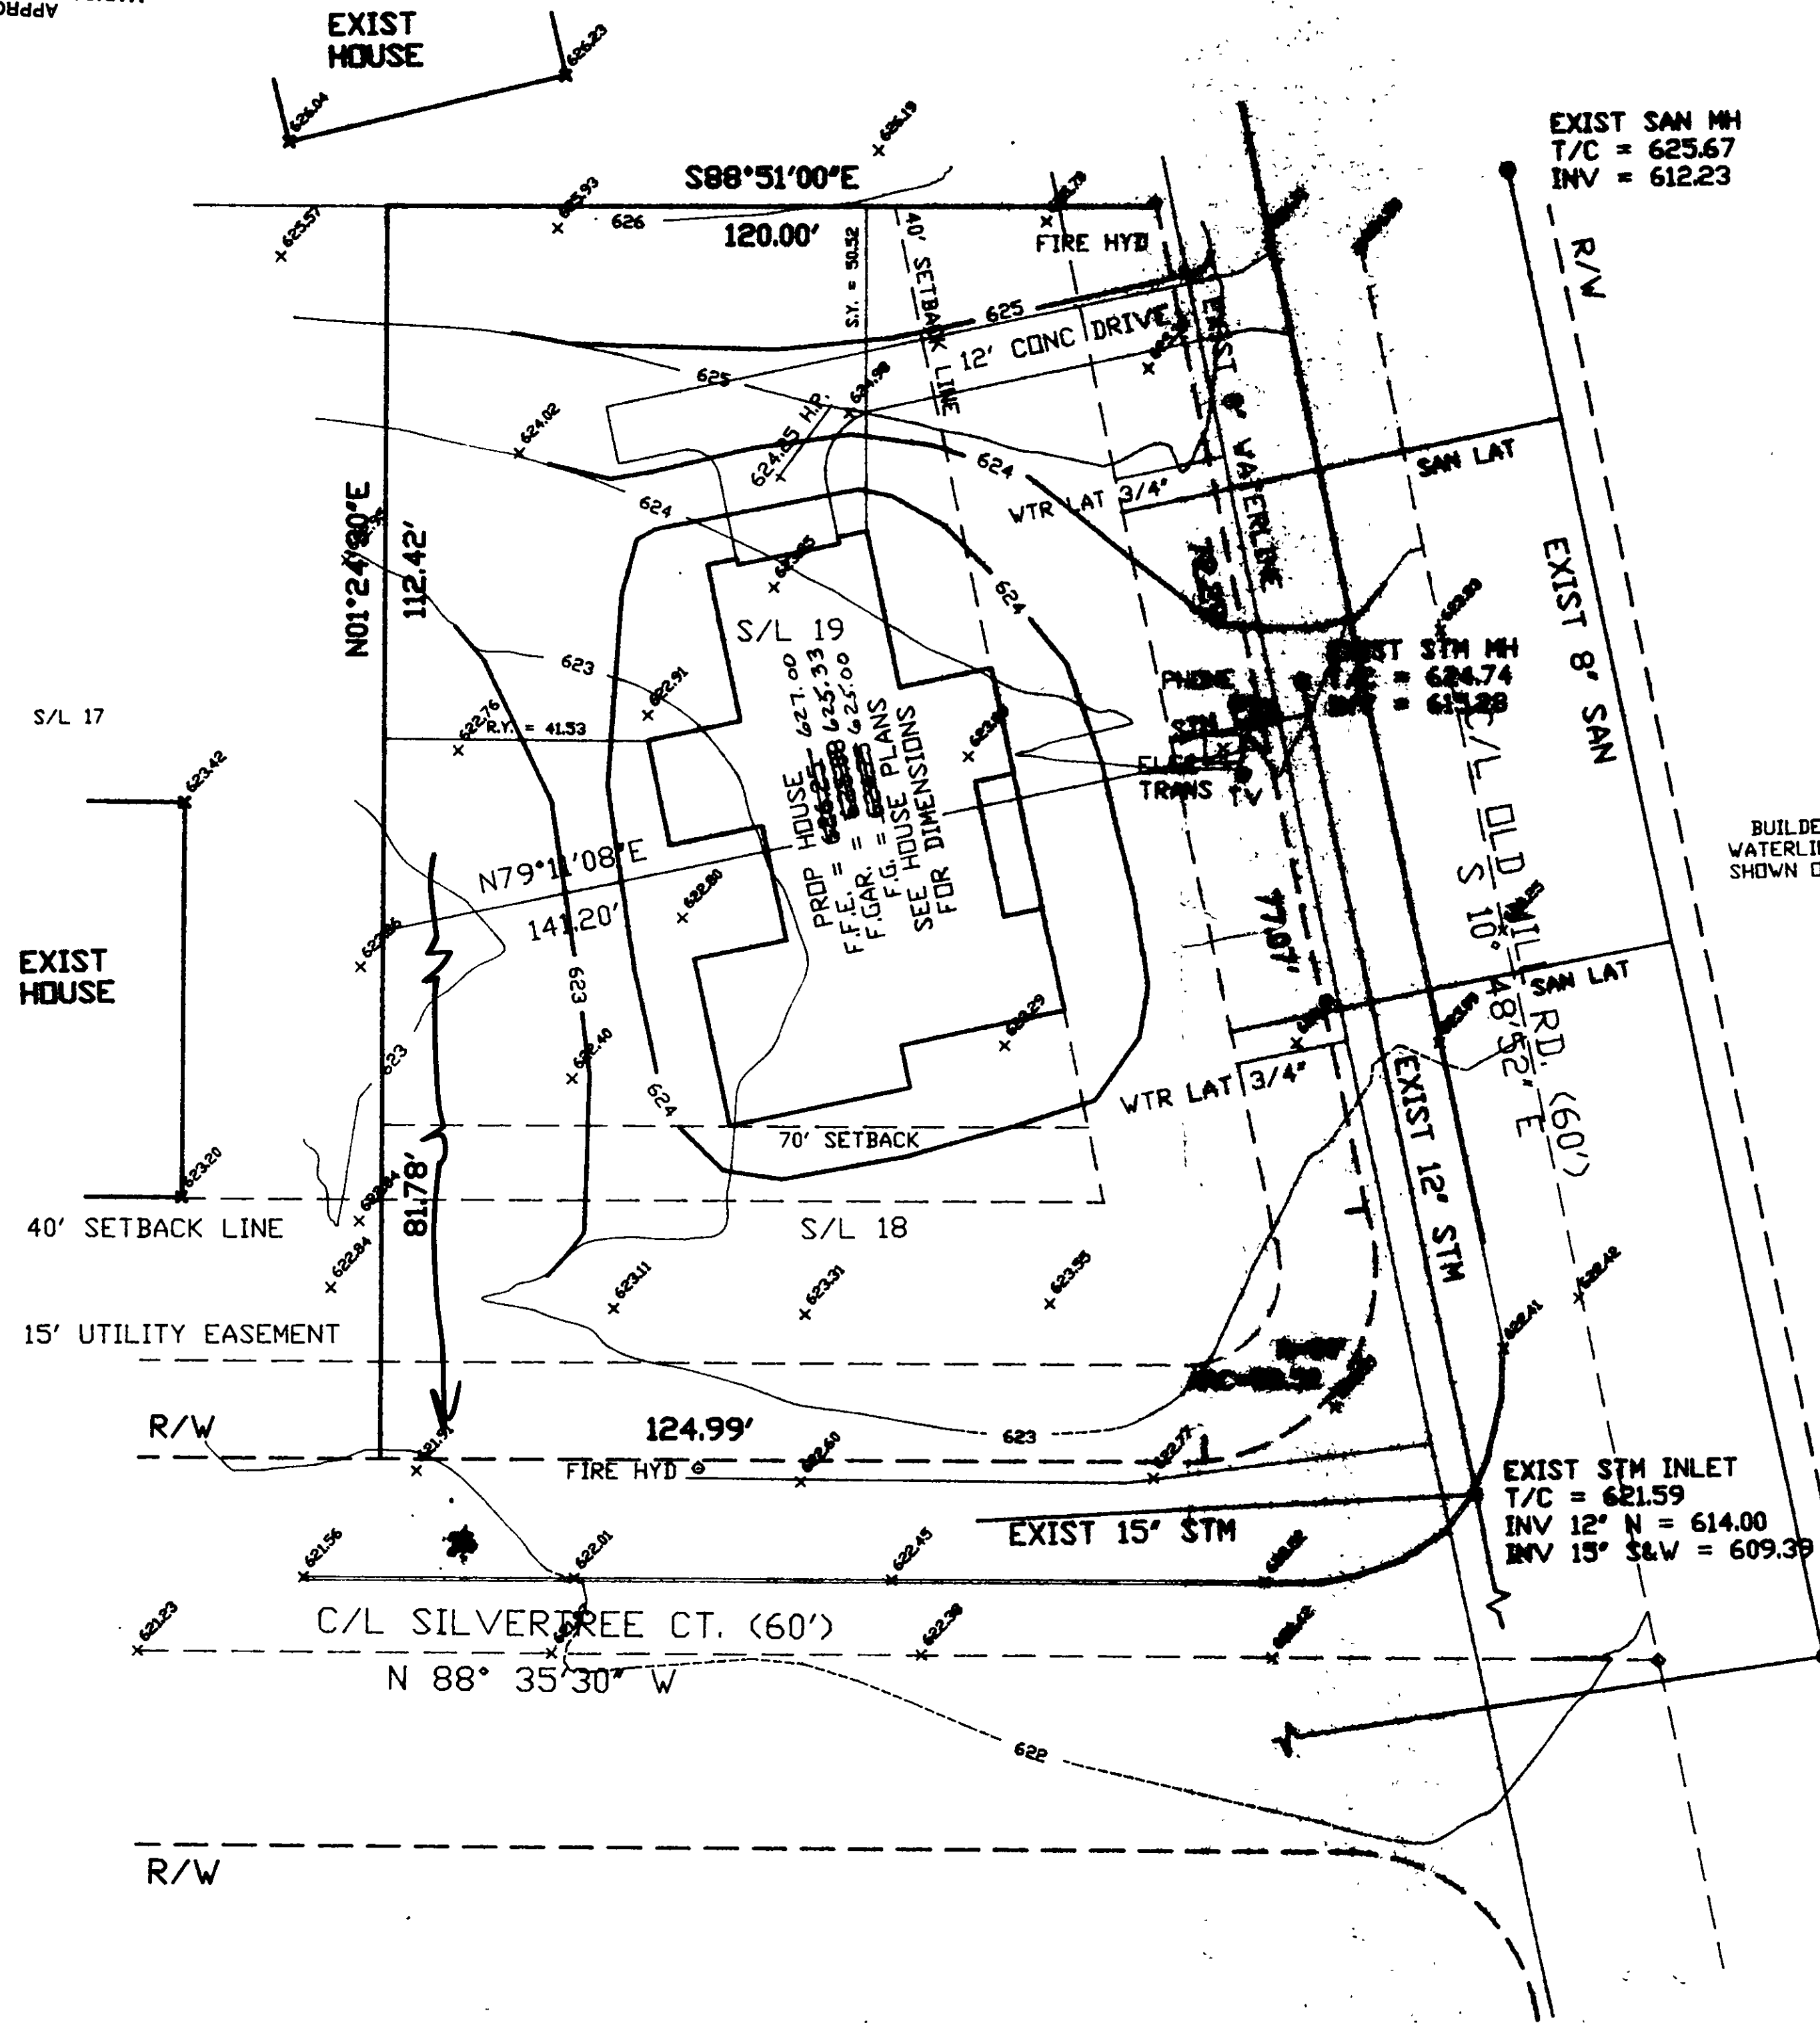

North
SCALE 1" = 20'

BUILDER TO CONNECT TO SANITARY SEWER, WATERLINE, AND STORM SEWER THRU LATERALS SHOWN ON EITHER SUBLOT OF WHICH HOUSE IS LOCATED.

Grading Plan Approved
as shown and/or noted
THOMAS P. GILLES, P.E.
Lake County Engineer

By GJH Date 9.22.98
Scale as Shown



WILLIAM R. GRAY ASSOCIATES, INC.
7519 MENTOR AVE. MENTOR, OHIO 44060
(440) 946-1616

TITLE: SITE PLAN - WORTHY RESIDENCE
S/L 18 & 19 - SILVERWOOD SUBDIVISION
MADISON TWP., COUNTY OF LAKE, STATE OF OHIO

DATE: 9-18-98 DRAWN BY: DUG CHECKED BY: TGG SCALE: 1" = 20'

SHEET NO. JACK AUSTEN

DWG. NO. 2LD9.DWG