SITE PLAN FOR **GLEN GNAGY**

KNOWN AS BEING SUBLOTS 986 & 987 OF THE MADISON GOLF LAKELANDS SUBDIVISION AS RECORDED IN VOLUME E. PAGE 68 OF THE LAKE COUNTY PLAT RECORDS

TOWNSHIP OF MADISON

COUNTY OF LAKE - STATE OF OHIO

NOTES: SEWER AND WATER CONNECTIONS ARE TO BE VERIFIED AT TIME OF CONSTRUCTION.

d.s. = DOWNSPOUTS WITH SPLASHBLOCKS.

TEMPORARY STONE TO BE INSTALLED

AT DRIVEWY ENTRANCE.

AVERAGE SETBACK OF HOUSES IN BLOCK = 33'

"I. THE UNDERSIGNED, HEREBY CERTIFY THAT THE TOPOGRAPHY SHOWN HEREON, INDICATED BY SPOT **ELEVATIONS AND ONE FOOT CONTOURS, REPRESENTS** AN ACTUAL FIELD SURVEY MADE BY ME ON THE 12th DAY OF JULY, 2004 AND THAT THE ELEVATIONS WERE TAKEN AT APPROPRIATE INTERVALS AND THAT AS OF THAT DATE THEY EXISTED AS INDICATED HEREON

JAMES A. ZIEMBA, PROFESSIONAL SURVEYOR #70 JAMES A. ZIEMBA 7094

Curve	Delta Angle

3°29'02" 2 89°27'23" 15.00

47.63 APPROVED

95.22

S 87°15'32"W S 44°16'22"W

SCALE 1" = 30' This project is exempt from

SILT FENCING

41'SETBACK

PROPOSED

DRIVE

33%SETBACK

IRON PIN

IN CONC.

IRON PIN

BASIN

50'

Õ

Ř

ORKNE

SEWER

SANITARY

0°27'20"E

ഗ

1 601.82

CATCH

SPLIT LEVEL

FRAME HOUSE

26.2

15.0

SETBACK


GAR. FLOOR GAR. FLOOR O. ELEV = 610.67

34.0

PROPO<mark>SED HOUSE</mark> FIN. FLÓOR = 611.0

ESC Plan Review Date 7-19-04

BENCHMARK SURVEY COMPANY 5964 SOUTH RIDGE ROAD MADISON, OHIO JULY 12, 2004 1-440 12 13 2004 1-440 12 13 2004 Management Plan as shown and/or noted TO D. GILLS, RE.

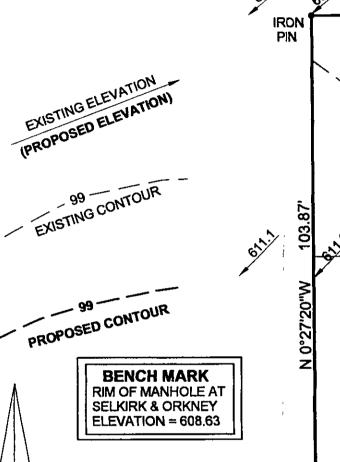

SETBACK OF HOUSE ON SELKIRK = 25.5'

IRON

PIN

95.23 Stormwater Management Pian Approved as shown and/of noted

d.s.

610.5

SUBLOT 986

1B-112A-12-12

JAMES R. GILLS. 7 County Drainago Fag

> 6717 SELKIRK DRIVE 50'

Chord Bearing

u 13 30 60

1566.19

95.23 23.42

21.11 MADISON TOWNSHIP ZONING

Lake SWCD

Tangent Chord

N 89°32'40"E

110.00

35' SETBACK

SUBLOT 987

1B-112A-12-11

35' SETBACK