


Revised 8/3/93
 APPROVED
 MADISON TWP. ZONING
 13872
 Permit
 Impervious
 AUG 04 1993

S/B
 35'
 35'
 33.5'
 39'

Address
 1374
 1380
 1386
 1398

SITE PLAN
 FOR
 HOLIDAY CONSTRUCTION
 BEING S/L 1244 & THE NORTHERLY 20 FEET
 OF S/L 1243, IN THE CLIKINGS BEACH PARK SUBD.
 IN THE TOWNSHIP OF MADISON, LAKE COUNTY, OHIO.

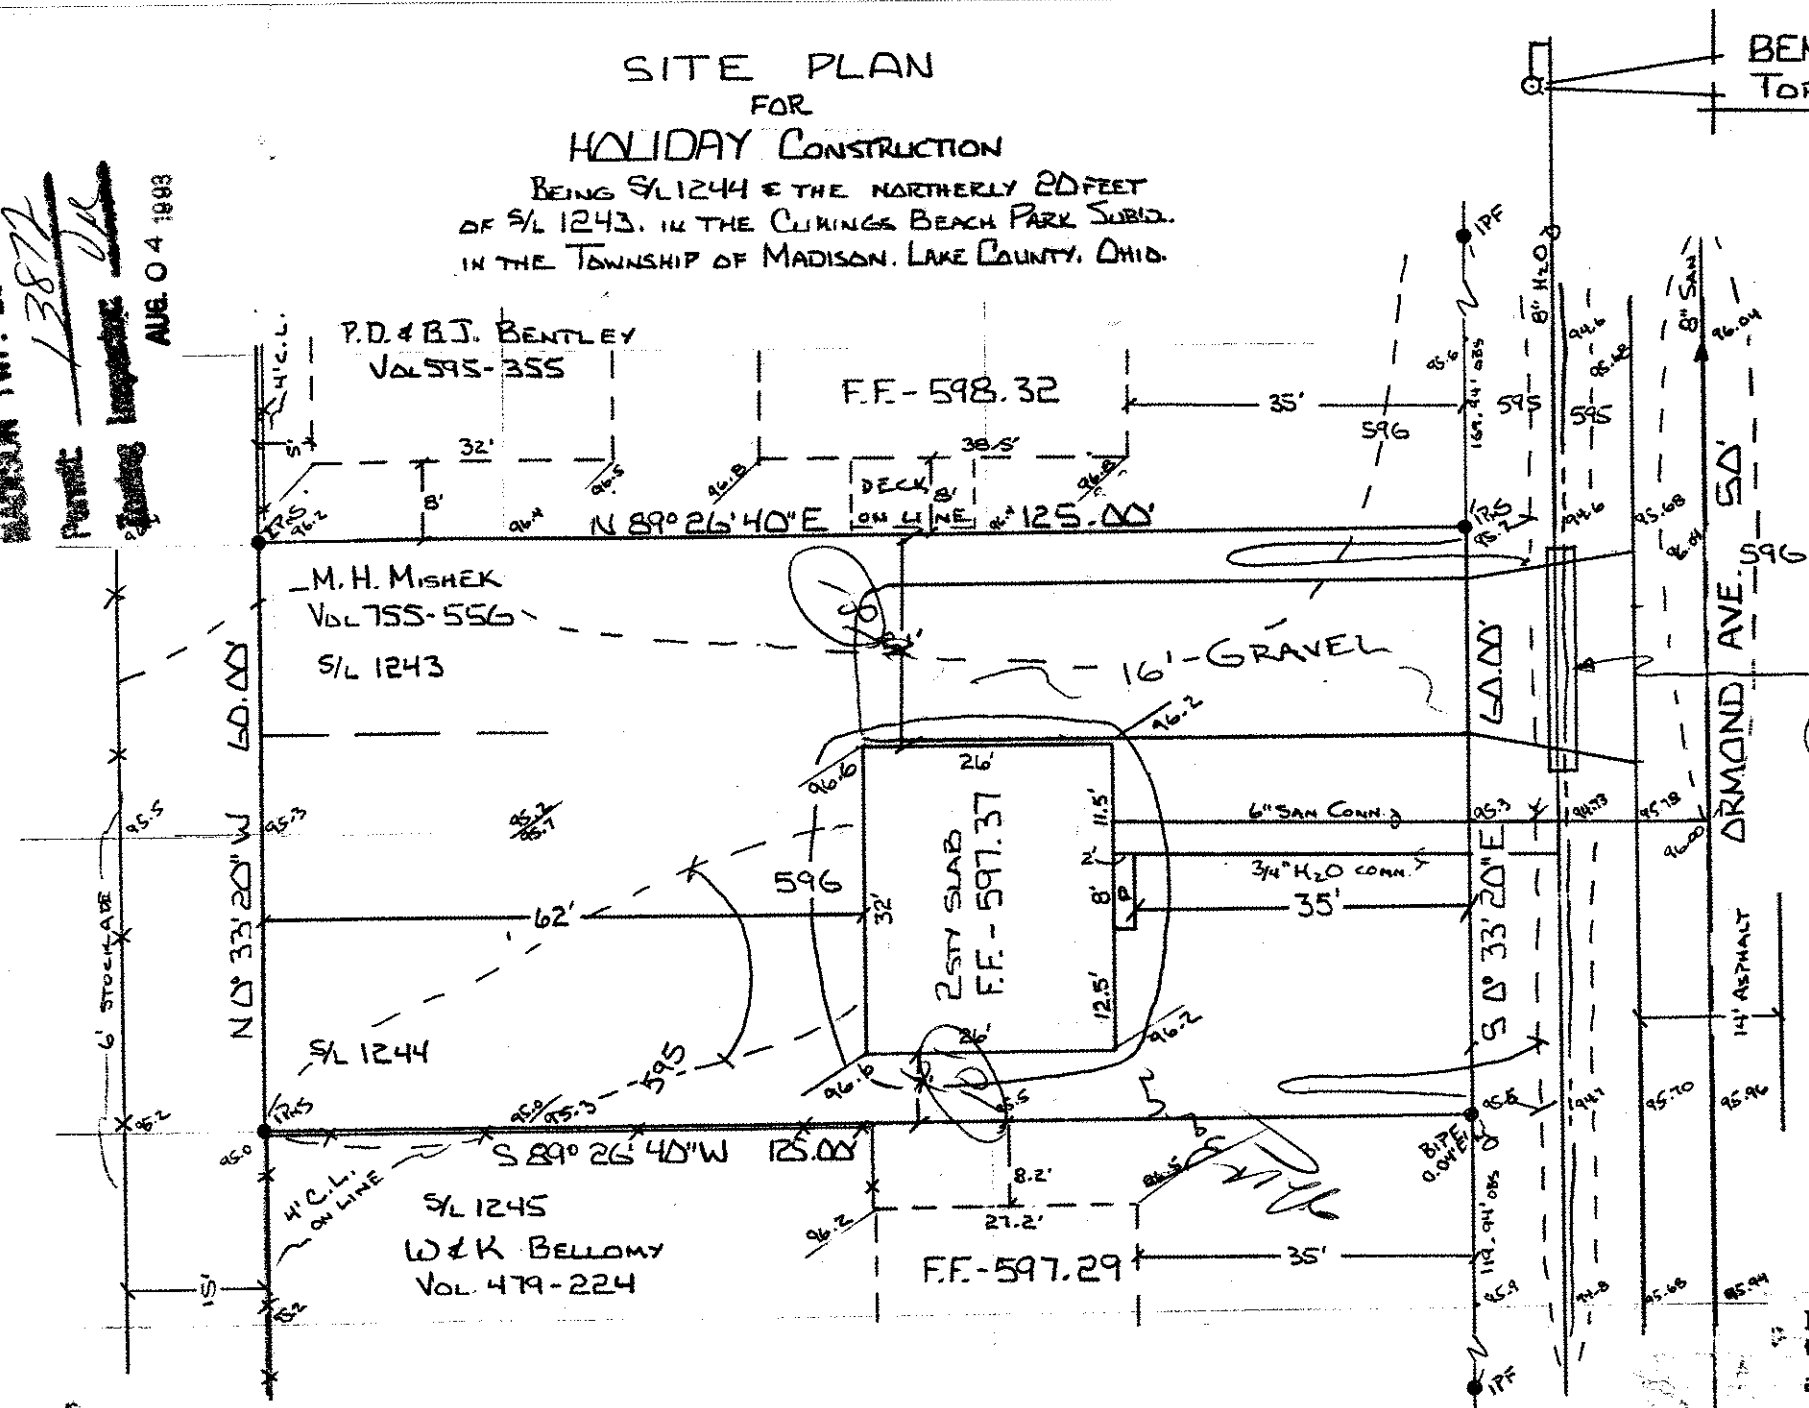


BENCHMARK - 598.15
 TOP BOLT HYDRANT

1" = 20'
 N
 EXIST
 PROP

Grading Plan Approved
 as shown and/or noted
 THOMAS P. GILLES, P.E.
 Lake County Engineer

12" BENCH MARK? 6" H
 BURY 6" H
 MADISON TWP.
 APPROVAL
 Date 8.6.93

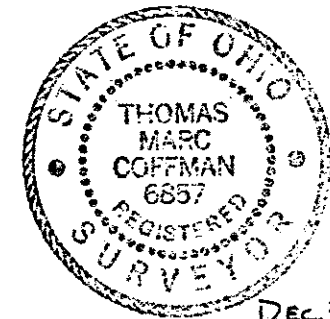

DEC. 3, 1992
 REV 7-30-93 (HOUSE)

I, the undersigned hereby certify that
 this topography, indicated by 1' contours,
 and elevations shown hereon represent an
 actual field survey made by me on Nov 20, 1992
 and that the elevations were taken at
 appropriate intervals and that as of that

T.M. Coffman P.S.
 No 6857

VILLAGE SURVEYING Co.
 202 THIRD ST., FAIRPORT HBR., OH 44107
 (216) 357-1359