


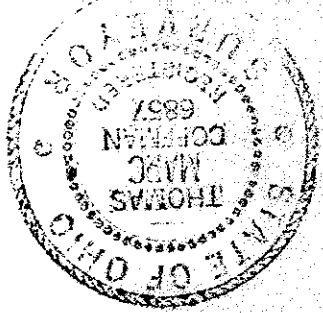

MARCH 5, 1994

BENCHMARK- 592.47
N.R.M.S.A.U. M.H. INC. 584.67

Sublot	Block B	RVE.
83	85	38.1'
85	34.6	
90	40.0'	
91	37.5'	
92	42.3'	
92	25.4'	
92	39.3'	
SETBACK		

SITE PLAN
FOR
BILL BARBIS
SUBD IN MADISON TOWNSHIP, LAKE
COUNTY, OHIO.

I, the undersigned hereby certify that this topography, indicated by 1' contours, and elevations shown hereon represent an actual field survey made by me on Nov. 2, 1993 and that the elevations were taken at appropriate intervals and that as of that date they existed as indicated hereon.

J. M. C. [Signature]
Professional Engineer

SCALE: 1"=20'



APPROVED
MADISON TWP. ZONING

Permit: [Signature]

Inspected Inspector: [Signature]

MAR. 08 1994

DISCHARGE
F DRAINS
as shown and/or noted
THOMAS P. GILLES, P.E.
Lake County Engineer
By 6/11/94
Date 3/11/94
CHANGE NORTH F.G.S TO 91.0
AS SHOWN
DIRECT RUNOFF TO ROADSIDE
DITCH

VILLAGE SURVEYING CO.
FAIRPORT HARBOR, OHIO 44077
<216> 357-1359

