



APPROVED
MADISON TWP. ZONING

Permit: 44165
Issued: June 13 1994

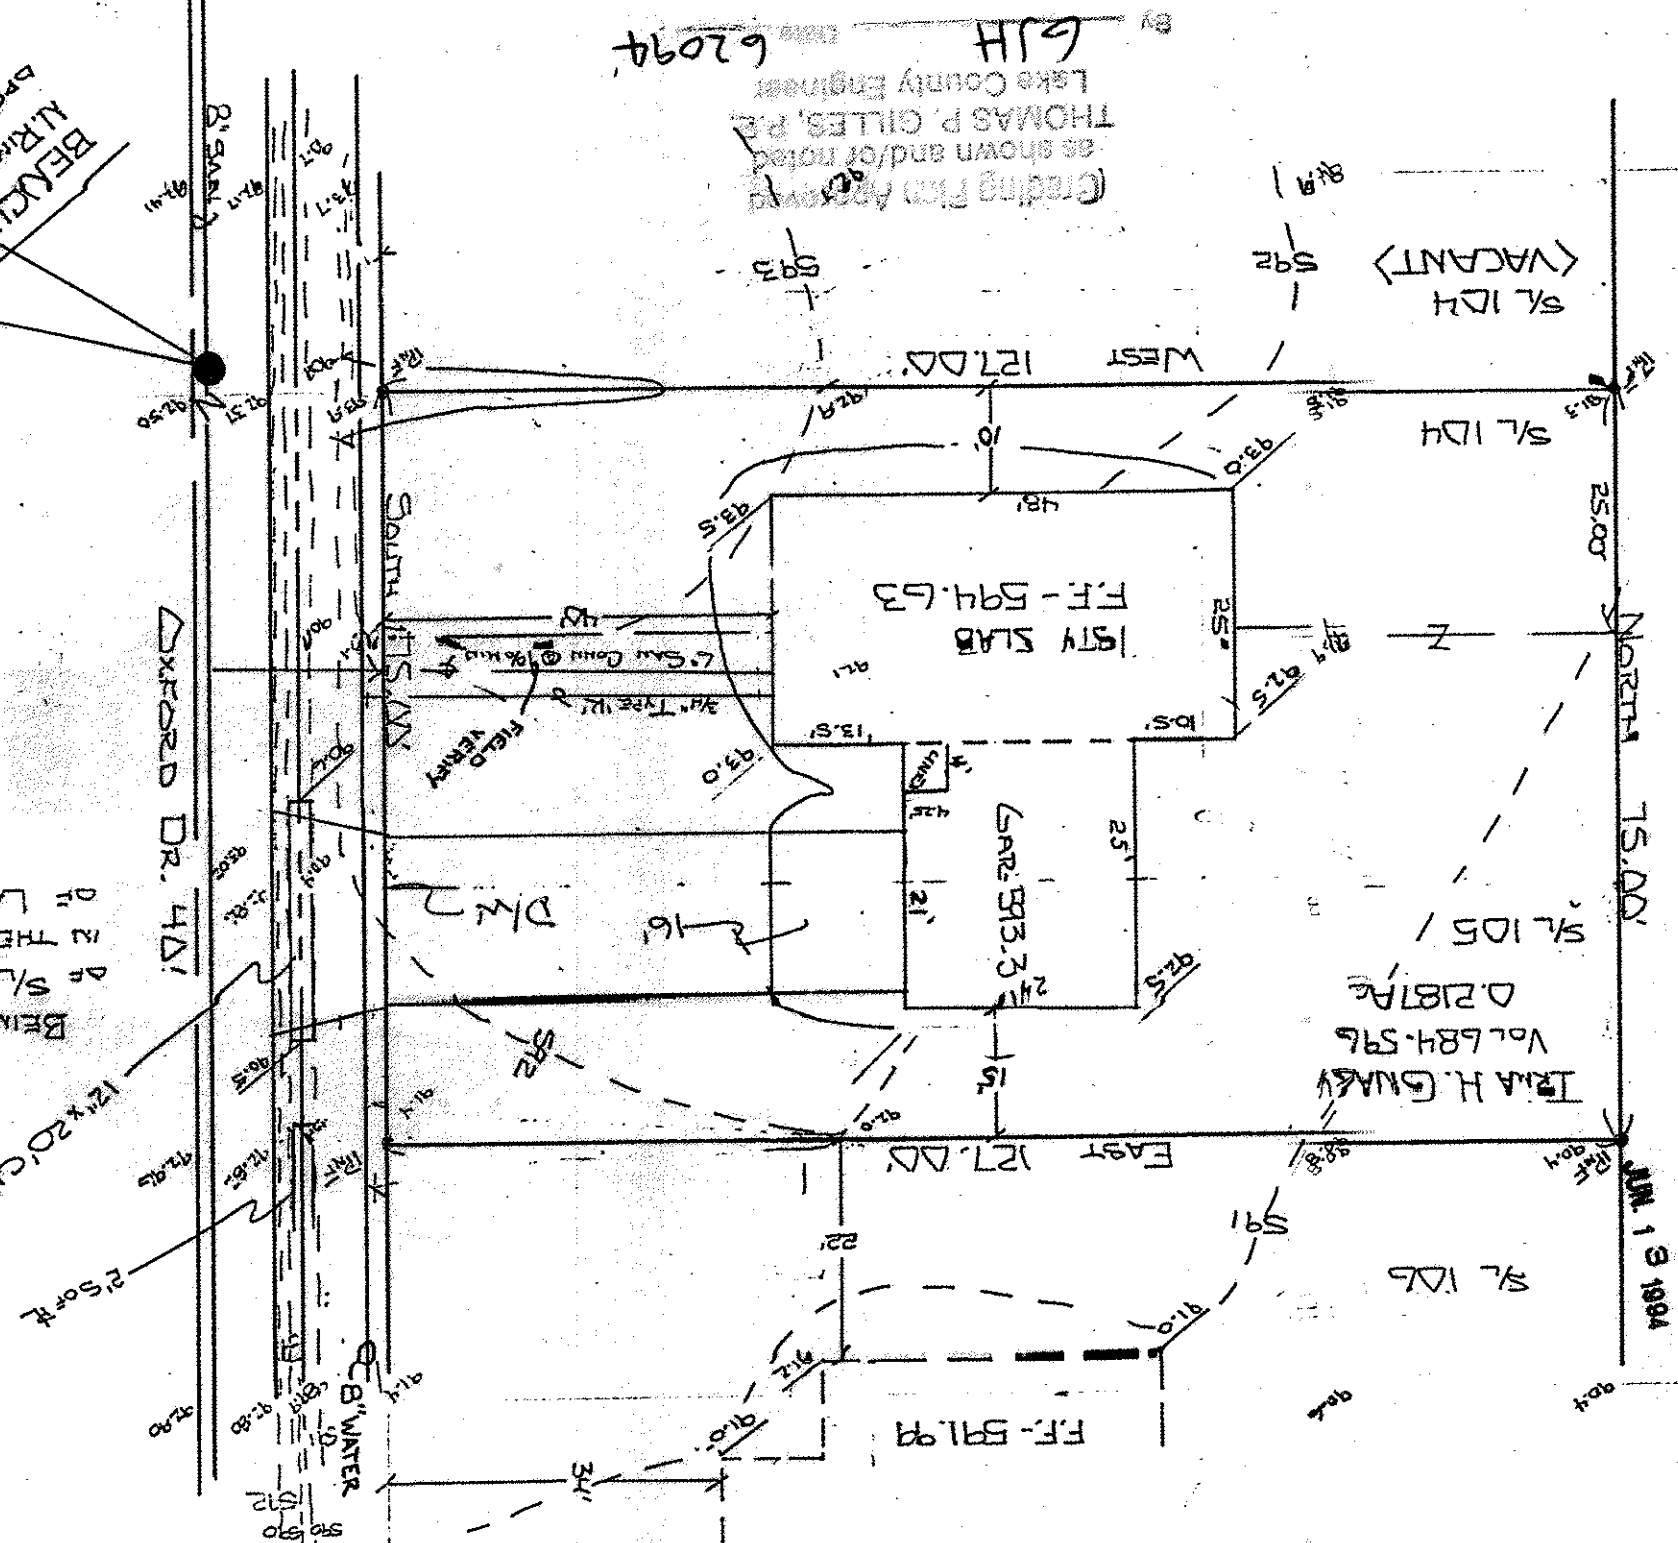

By 6JH
Lake County Engineer
THOMAS P. GILES, P.E.
(Grading Plan Approved
as shown and/or noted
62094)

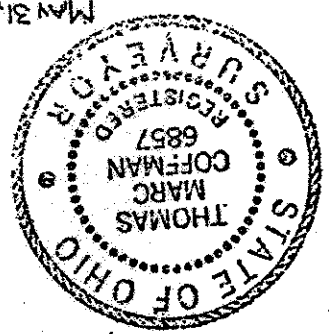

I, the undersigned hereby certify that
this topography, indicated by 1" contour,
and elevations shown hereon represent an
actual field survey made by me on March 9, 1994,
and that the elevations were taken at
appropriate intervals and that as of that
date they existed as indicated hereon.

SITE PLAN
FOR
GLEN CANAL
BEING S/L 105 & THE NORTHERLY 25 FEET
OF S/L 104 IN THE MADISON BEACH SUBD.
IN THE TOWNSHIP OF MADISON, COUNTY
OF LAKE, STATE OF OHIO.

