



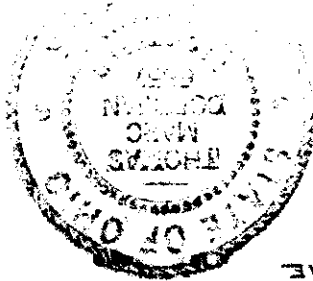

SCALE: 1"=20'

EXIST
PROP

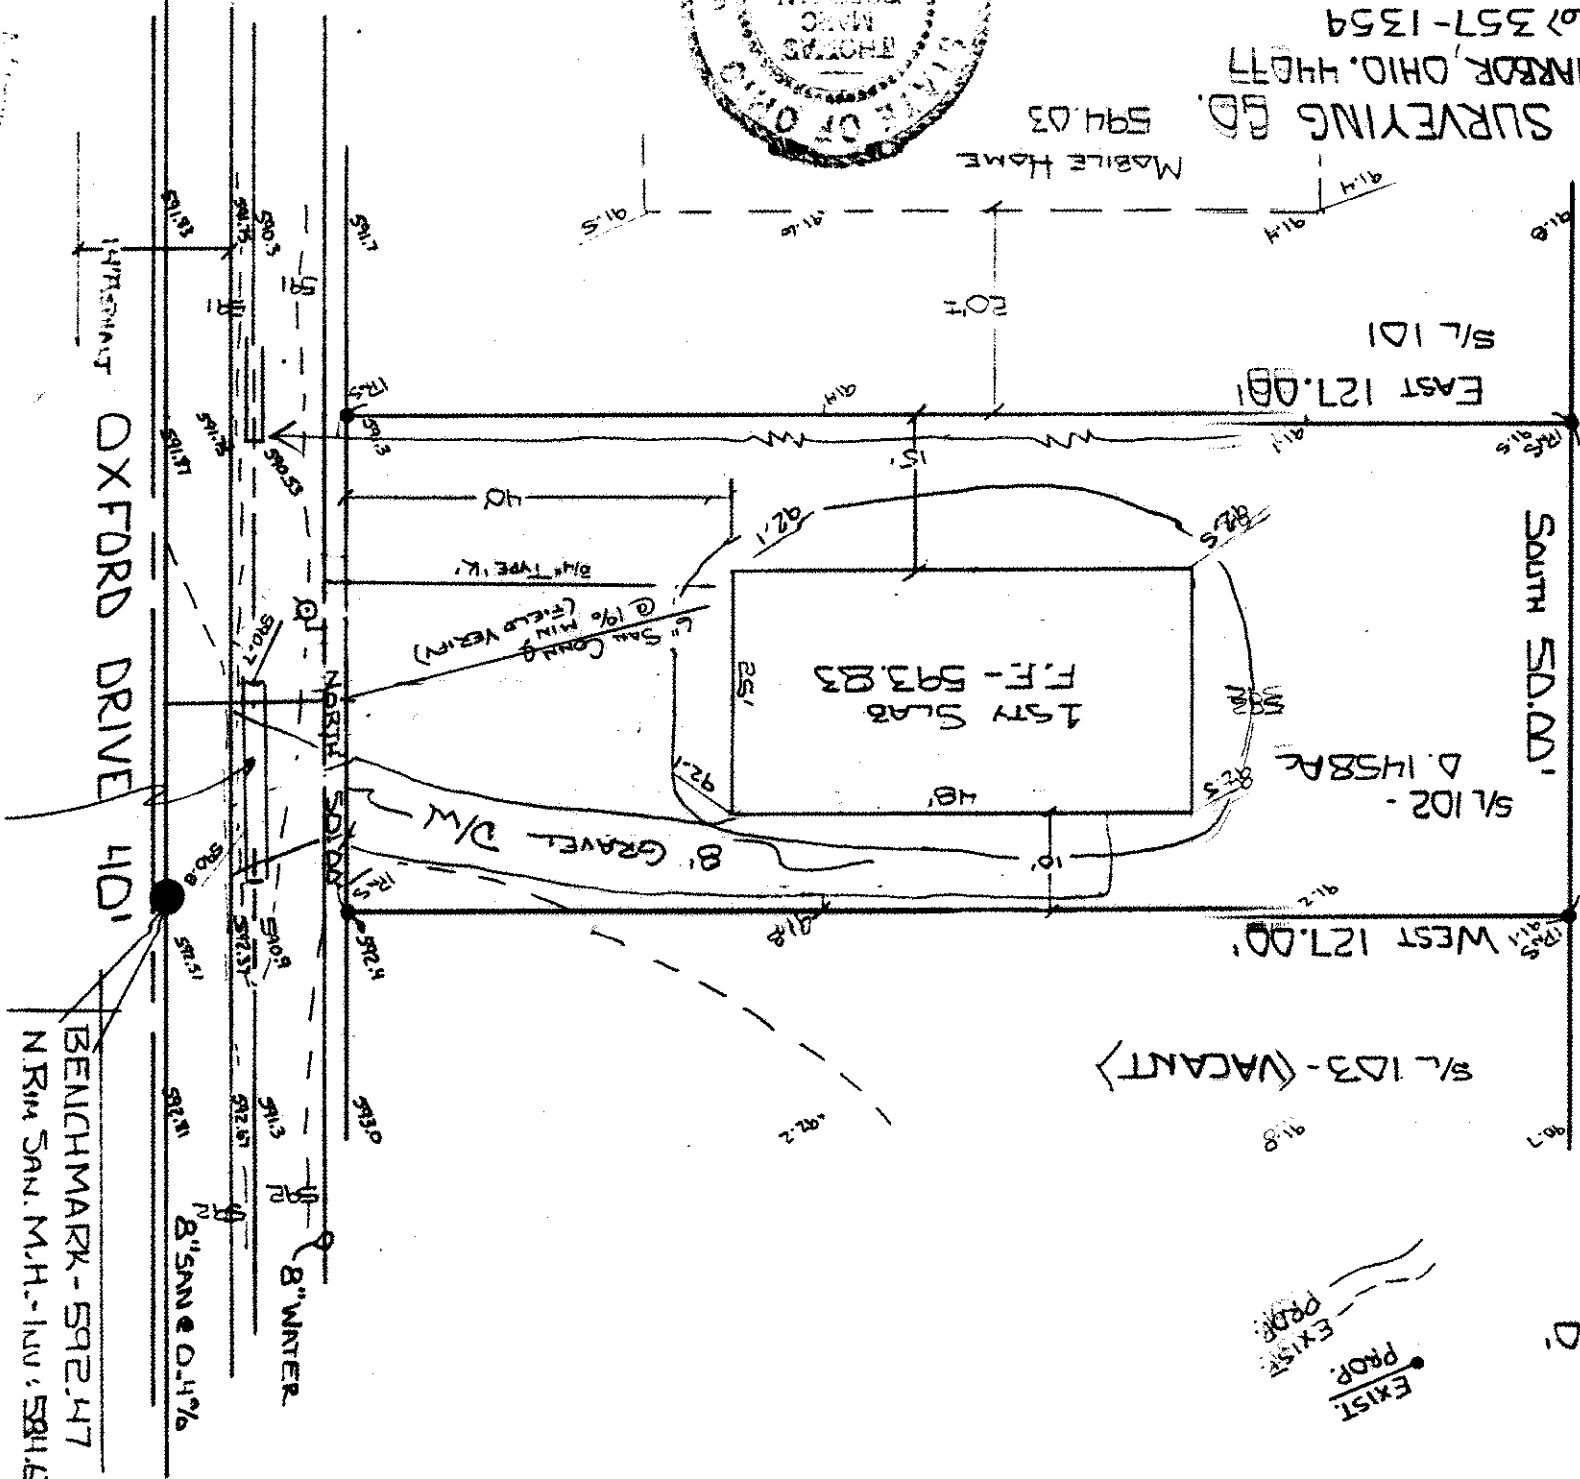

VILLAGE SURVEYING CO. 594.03
FAIRPORT HARBOR, OHIO 44077
(216) 357-1354

MARCH 16, 1994
REV S-6-94 (REV. HSE) REV S-17-94 - KEY HSE S-27-94

Approved
THOMAS P. GILLES, P.E.
Lake County Engineer
Date 6/9/94
BY SWALE AS SHOWN

SITE PLAN
FOR
BARBIS & BARBIS
BEING S/L 102 IN THE MADISON BEACH
SUBD. IN MADISON TOWNSHIP, LAKE
COUNTY, OHIO.

APPROVED
MAY 1994
14/129
MAY 13 1994

I, the undersigned hereby certify that
this topography, indicated by 1' contours,
and elevations shown herein represent an
actual field survey made by me on March 9, 1994
and that the elevations were taken at
appropriate intervals and that as of that
date they existed as indicated herein.
No. 6857