


Sew. Manhole
Rim: 591.6 - Inv. = 585.33

Q Lake Rd. 60'

OXFORD DRIVE 40'

N0°12'30"E 80.00'

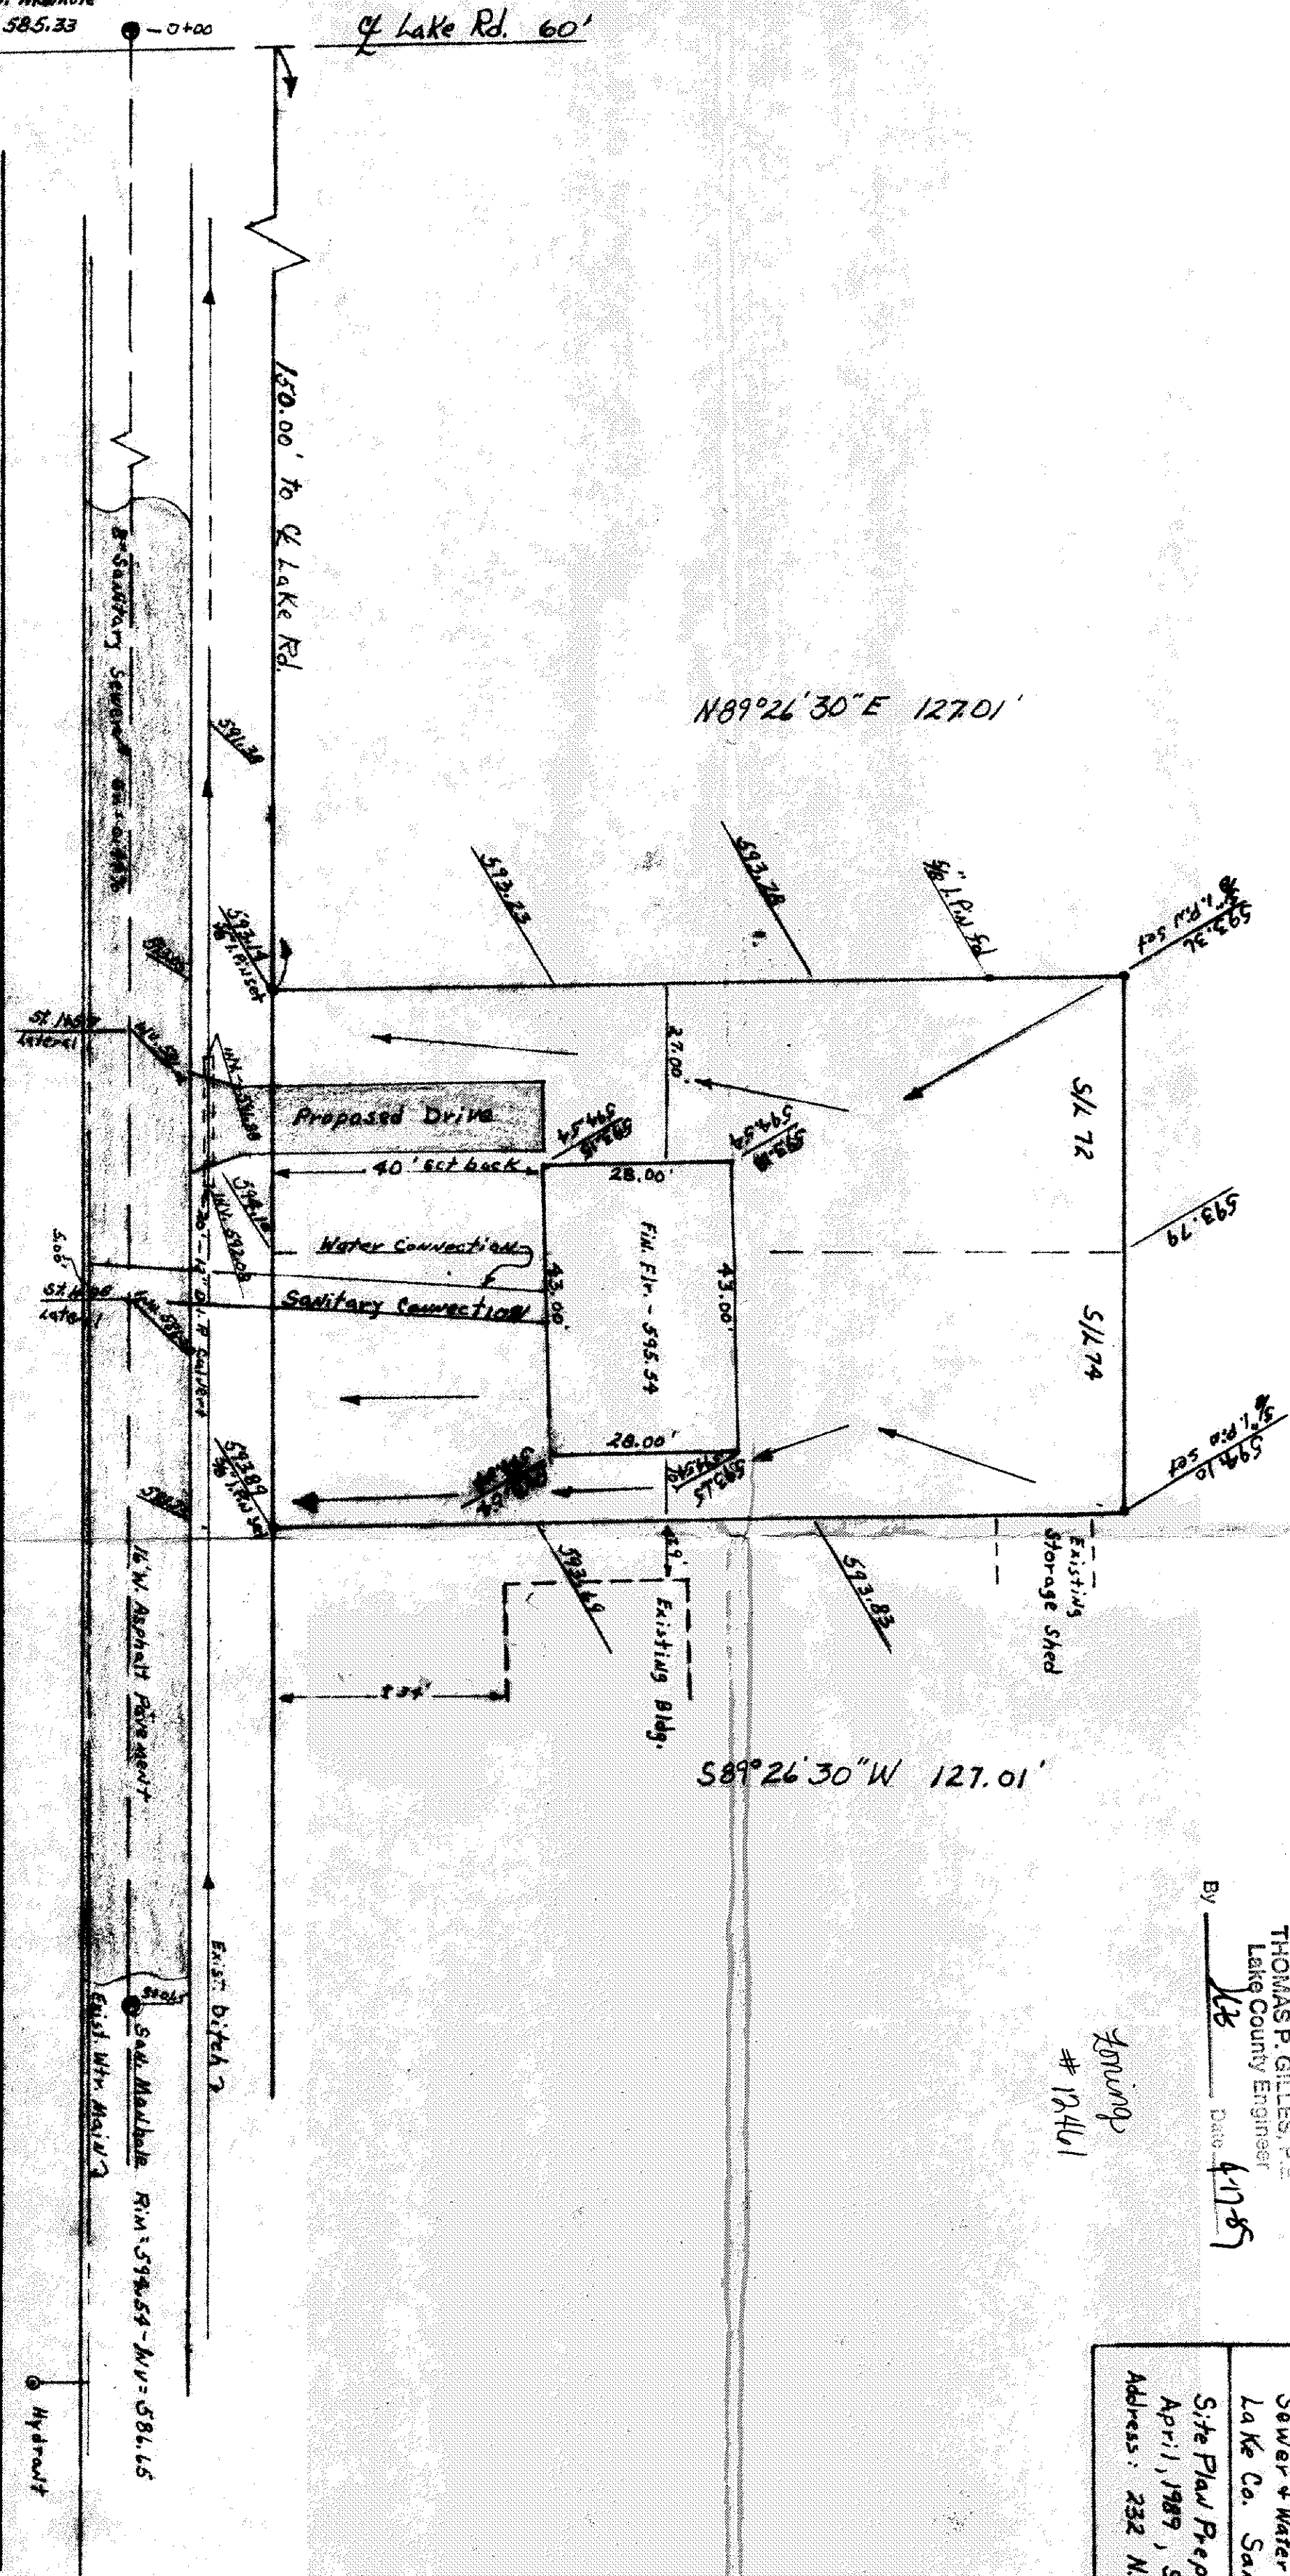


N89°26'30"E 127.01'

S0°12'30"W 80.00'

S89°26'30"W 127.01'

Scale 1" = 20'

James P. Russell

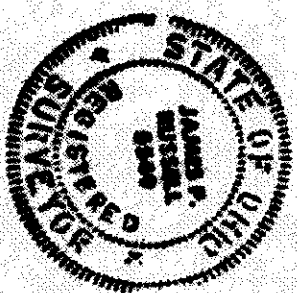

Grading Plan Approved
as shown and/or noted
THOMAS P. GILLES, P.E.
Lake County Engineer
By: JK Date: 4/17/87

Young
12441

SITE PLAN	
MADISON TWP. LAKE CO., OHIO For DON JACOBSON 5725 S. MADISON ROAD MADISON, OHIO 44057	
Vol. 384 p. 702	In the Easterly Lot, Tr. No. 2
Madison Beach Estates S/L 72+74 Oxford St.	Madison Twp., Lake Co., Ohio
LEGEND	
● = Sanitary Manhole	Exist. Elev. - Prop. El.
○ = Hydrant	Direction of Surface Drainage
B.M. = Rim San. M.H. Sta. 340.5	
NOTES	
Boundary Information Obtained From Plat Sewer & Water Line Information Obtained From Lake Co. Sanitary Engineer	
Site Plan Prepared By: James P. Russell, P.E. #3549 April, 1987, Scale 1" = 20', Phone No. 246-2831 Address: 232 N. Hamden St., Chardon, Ohio 44024	