

SITE PLAN

MADISON TOWNSHIP, LAKE COUNTY, OHIO

for: DALE WOLFE
CLIENT OWNER

ADDRESS STREET CITY ZIP

MADISON GOLF LAKELANDS
SUBDIVISION E-72 NAME TRACT
259 1/2 260 VOL-PG. PERTH ROAD LOT 1B-112A-5-1
SUBLOT NO. STREET VOL-PG. PERM. PARCEL NO.

LEGEND

SANITARY MANHOLE --- EXIST. ELEV. 100.0 PROP. ELEV. 100.0
STORM MANHOLE ---
INLET OR CATCH BASIN ---
HYDRANT ---
EXISTING CONTOURS ---
PROPOSED CONTOURS ---
AS BUILT ELEVATION
INDICATES DIRECTION OF SURFACE DRAINAGE

REMARKS

ALL BOUNDARY DATA SHOWN WAS OBTAINED FROM (DEEDS, RECORDED SUBDIVISION PLAT OR OTHER PUBLIC RECORDS)
LOCATIONS AS SHOWN OF ADJACENT WELLS AND SEPTIC TANKS OBTAINED FROM LAKE COUNTY HEALTH DEPARTMENT

DESIGN CERTIFICATION

THIS PLAT WAS PREPARED BY ME, AND IS CORRECT TO THE BEST OF MY KNOWLEDGE AND BELIEF.

NAME Harry S. Jones, Jr. SURVEYOR REGISTRATION NO. 6543

CHECK LIST

NO. OF BEDROOMS
DIMENSIONS
BEARINGS
TIE TO NEAREST STREET
SUBLOT NO. PARCEL NO.
SURROUNDING OWNERS
BLDG. DIMENSIONS FIN GR.
BLDG. TIES FL'R. GRADES
APRON TYPE WIDTH THICKNESS
SIDEWALK TYPE WIDTH THICKNESS
CULVERT TYPE DIA., LENGTH
ROCK OUTCROPPINGS
WATER MAIN SIZE, LOCATION
SAN. SEWER SIZE % GR. LOC.
SAN. MH. CAST. ELEV. INV. ELEV.
SAN. CONN. SIZE, LOC. DEPTH
STORM SEWER SIZE % GR. LOC.
STORM MH. CAST. ELEV. INV. ELEV.
PAV'T TYPE GRADE CURBS
GAS LINE LOC. SIZE PRESSURE
SEPTIC TANK LOCATION & DUPLICATION AREA
WELL LOCATION
ISOLATION RADIUS FROM WELL

REVISIONS


NO.	DATE	BY	PLAN PREPARED BY:
1	4/27/10	HJ	BABCOCK JONES & ASSOCIATES, INC.
2			PAINESVILLE, OHIO
3			DRAWN BY B.P. SCALE 1"=20' PHONE NO. 440-357-1811
4			CHK'D. H.J. DATE 1/14/10 DRAWING NO. 10-001
5			CREW CHIEF W.B. APP'D H.J.

"AS BUILT" CERTIFICATION
I, HEREBY CERTIFY THAT THE CIRCLED GRADES ARE EXISTING
FINISH GRADES CHECKED IN THE FIELD ON 5/11/10, 20____
AND ARE CORRECT TO THE BEST OF MY KNOWLEDGE AND BELIEF.



REGISTERED SURVEYOR REG. NO.

TBM - SANITARY MANHOLE
ELEV - 633.49

GRAPHIC SCALE

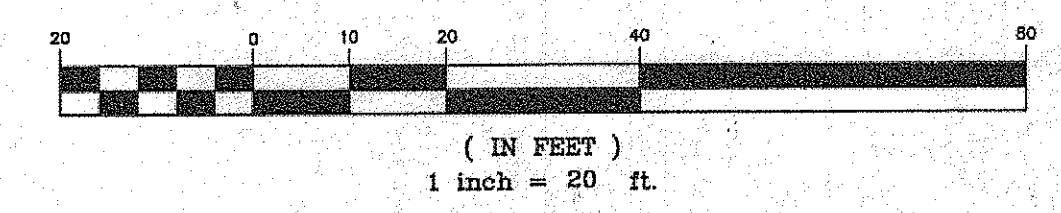

EXISTING UTILITIES NOTE:
THE SIZE AND LOCATION, BOTH HORIZONTAL AND VERTICAL
OF THE UNDERGROUND UTILITIES SHOWN HEREON, HAVE BEEN
OBTAINED BY A SEARCH OF AVAILABLE RECORDS.
VERIFICATION BY FIELD OBSERVATION HAS BEEN CONDUCTED
WHERE PRACTICAL, HOWEVER, BABCOCK, JONES AND ASSOCIATES
INC. DOES NOT GUARANTEE THE COMPLETENESS NOR ACCURACY
THEREOF.

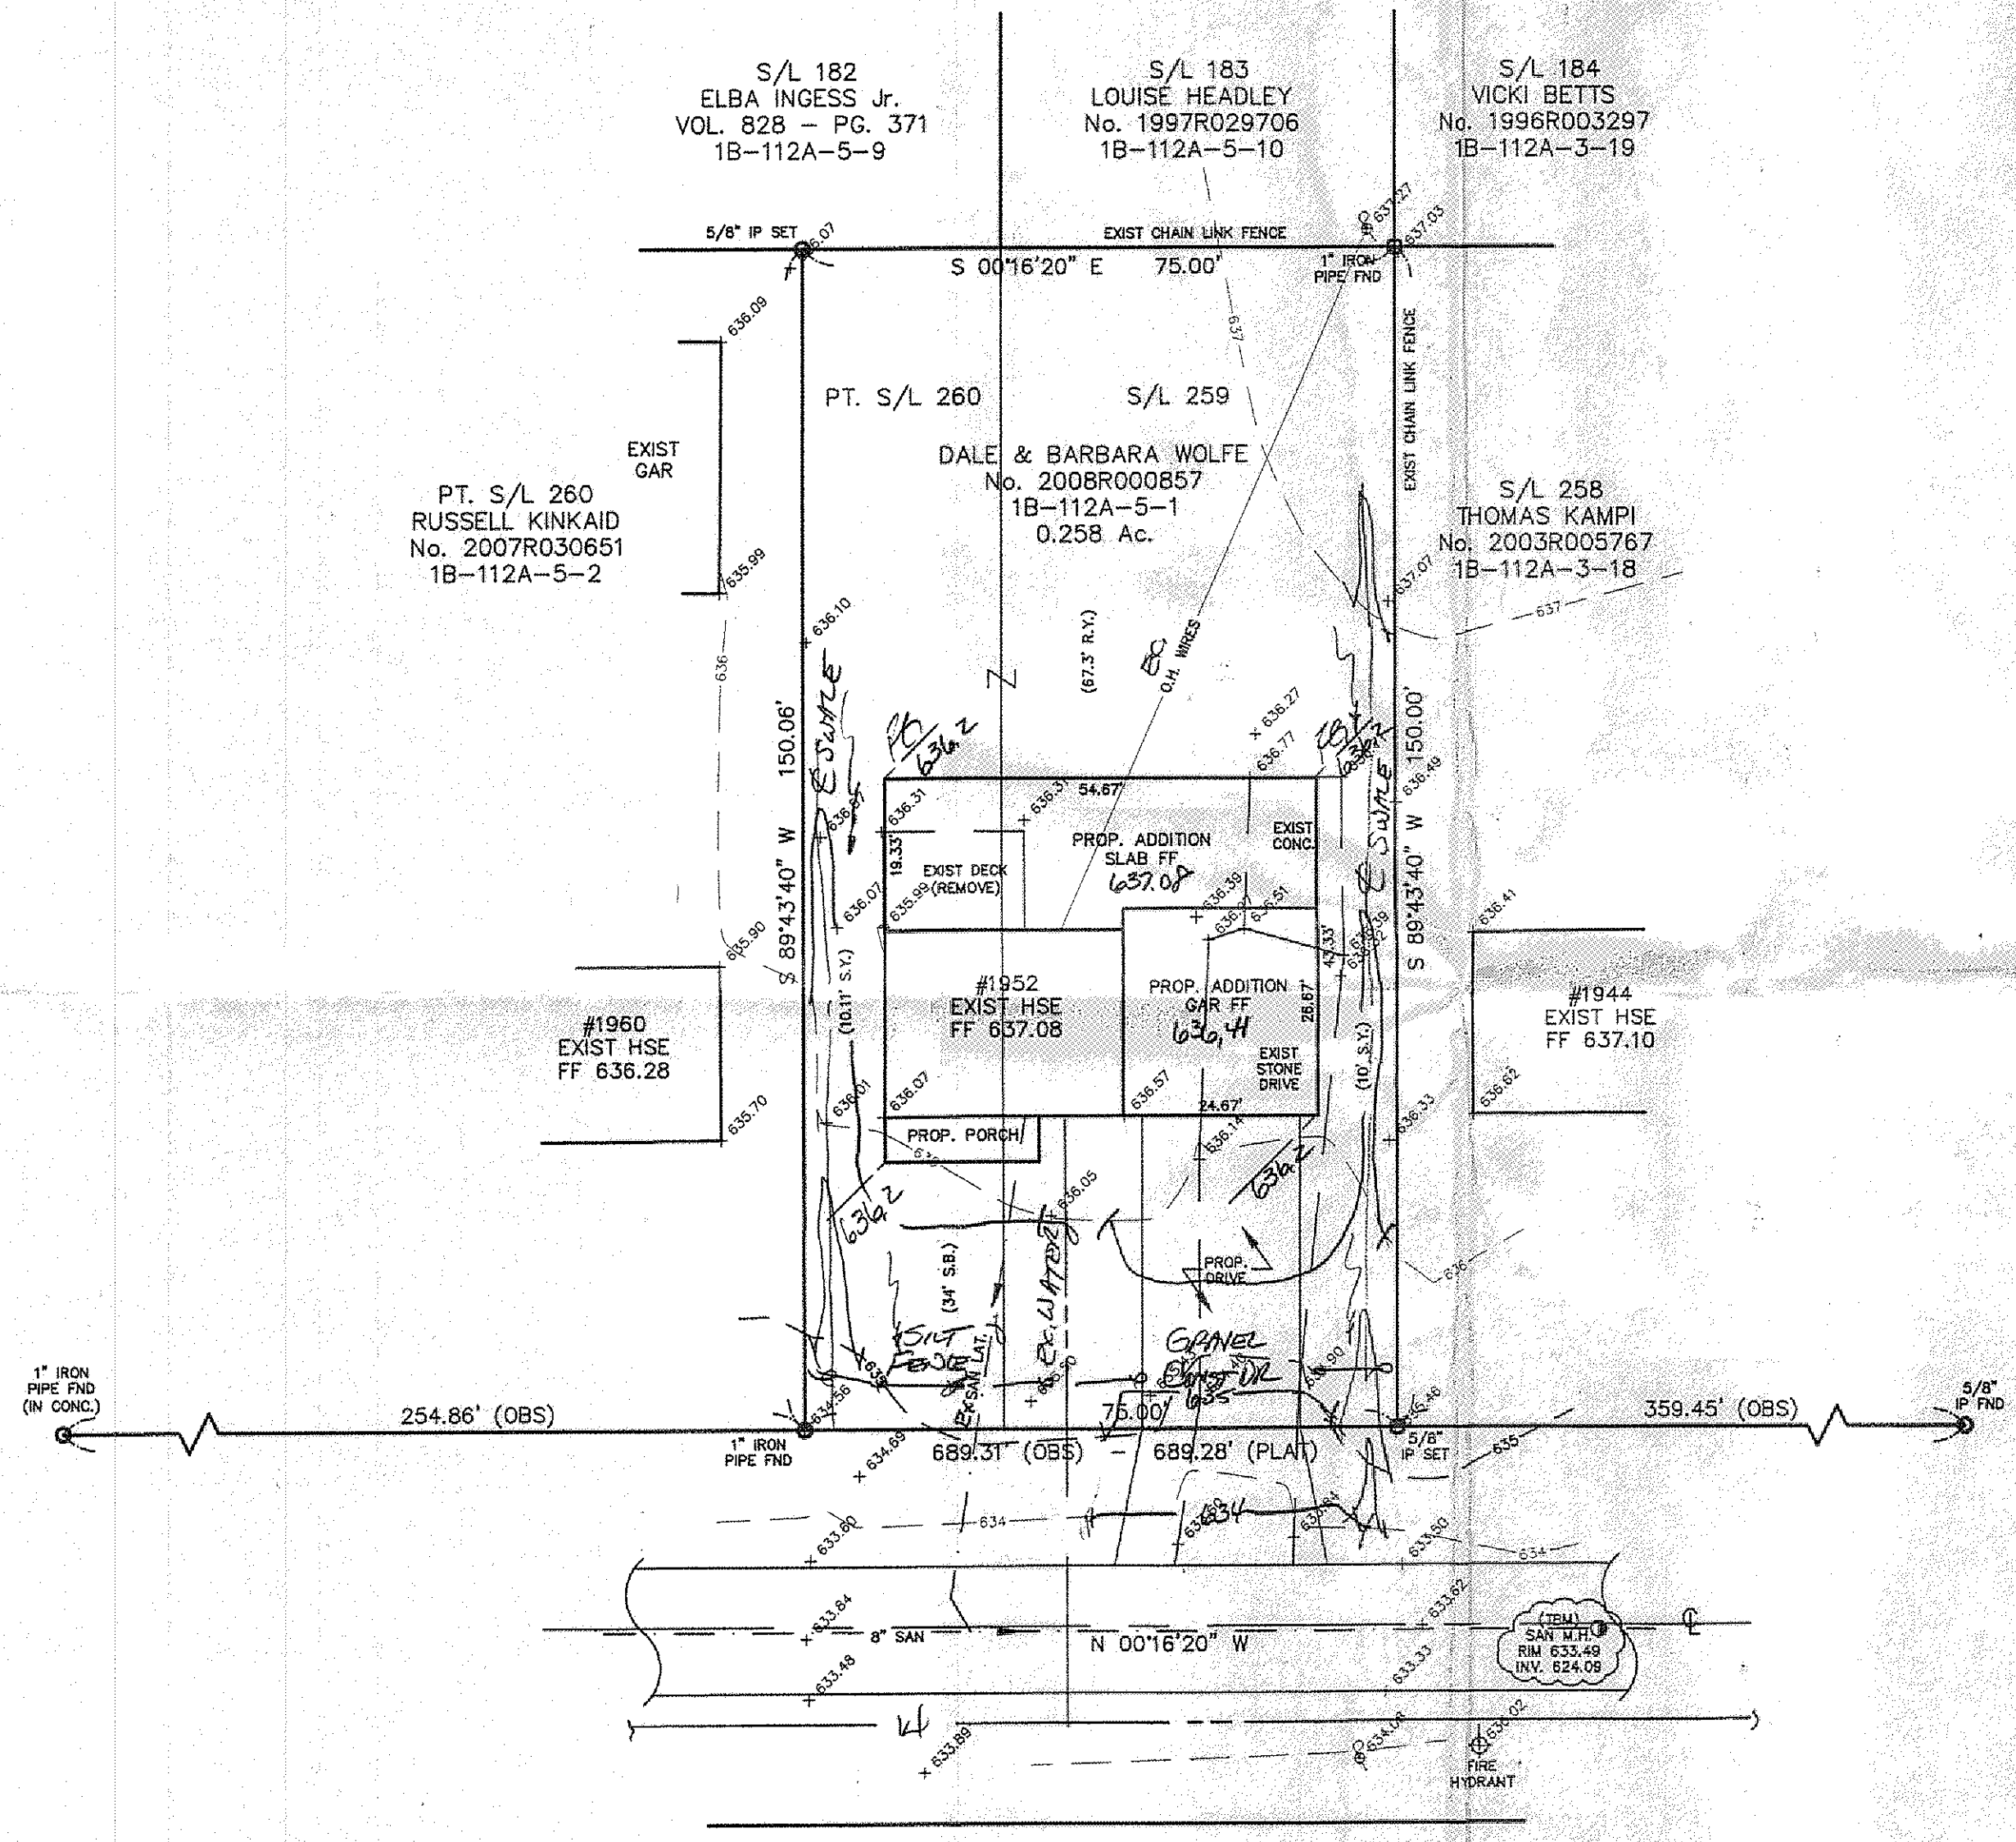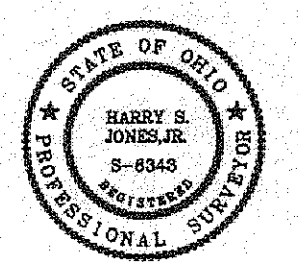

NOTE: ALL IRON PINS SET ARE
5/8" X 30" AND ARE CAPPED
BABCOCK, JONES & ASSOC.

APPROVED
MADISON TOWNSHIP ZONING
DATE 5/11/10
BY JFE Z-3588