


DWG 950802

APPROVED
MADISON TOWNSHIP ZONING
AUG 24 1995
PERMIT # 14708
ZONING INSPECTOR

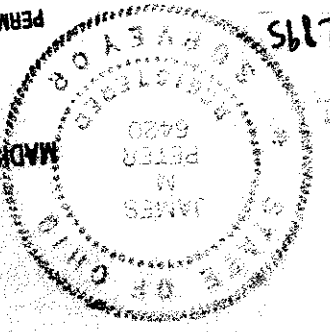

82195
6114
Existing Plan Approved
as shown and/or noted
T. J. GILLES, P.E.
Professional Engineer
No. 10777, Exp. 12/31/95


Jim Peter Land Survey
4759 CROSBY-COOK RD.
ROME, OHIO 44085

22 August 1995

SCALE 1" = 20 ft

LOTS 39, 40, & 41 OF
MADISON - LAKELAND SUBDIVISION,
MADISON TOWNSHIP,
LAKE COUNTY, OHIO

SITE PLAN
FOR
DAVE FISHER

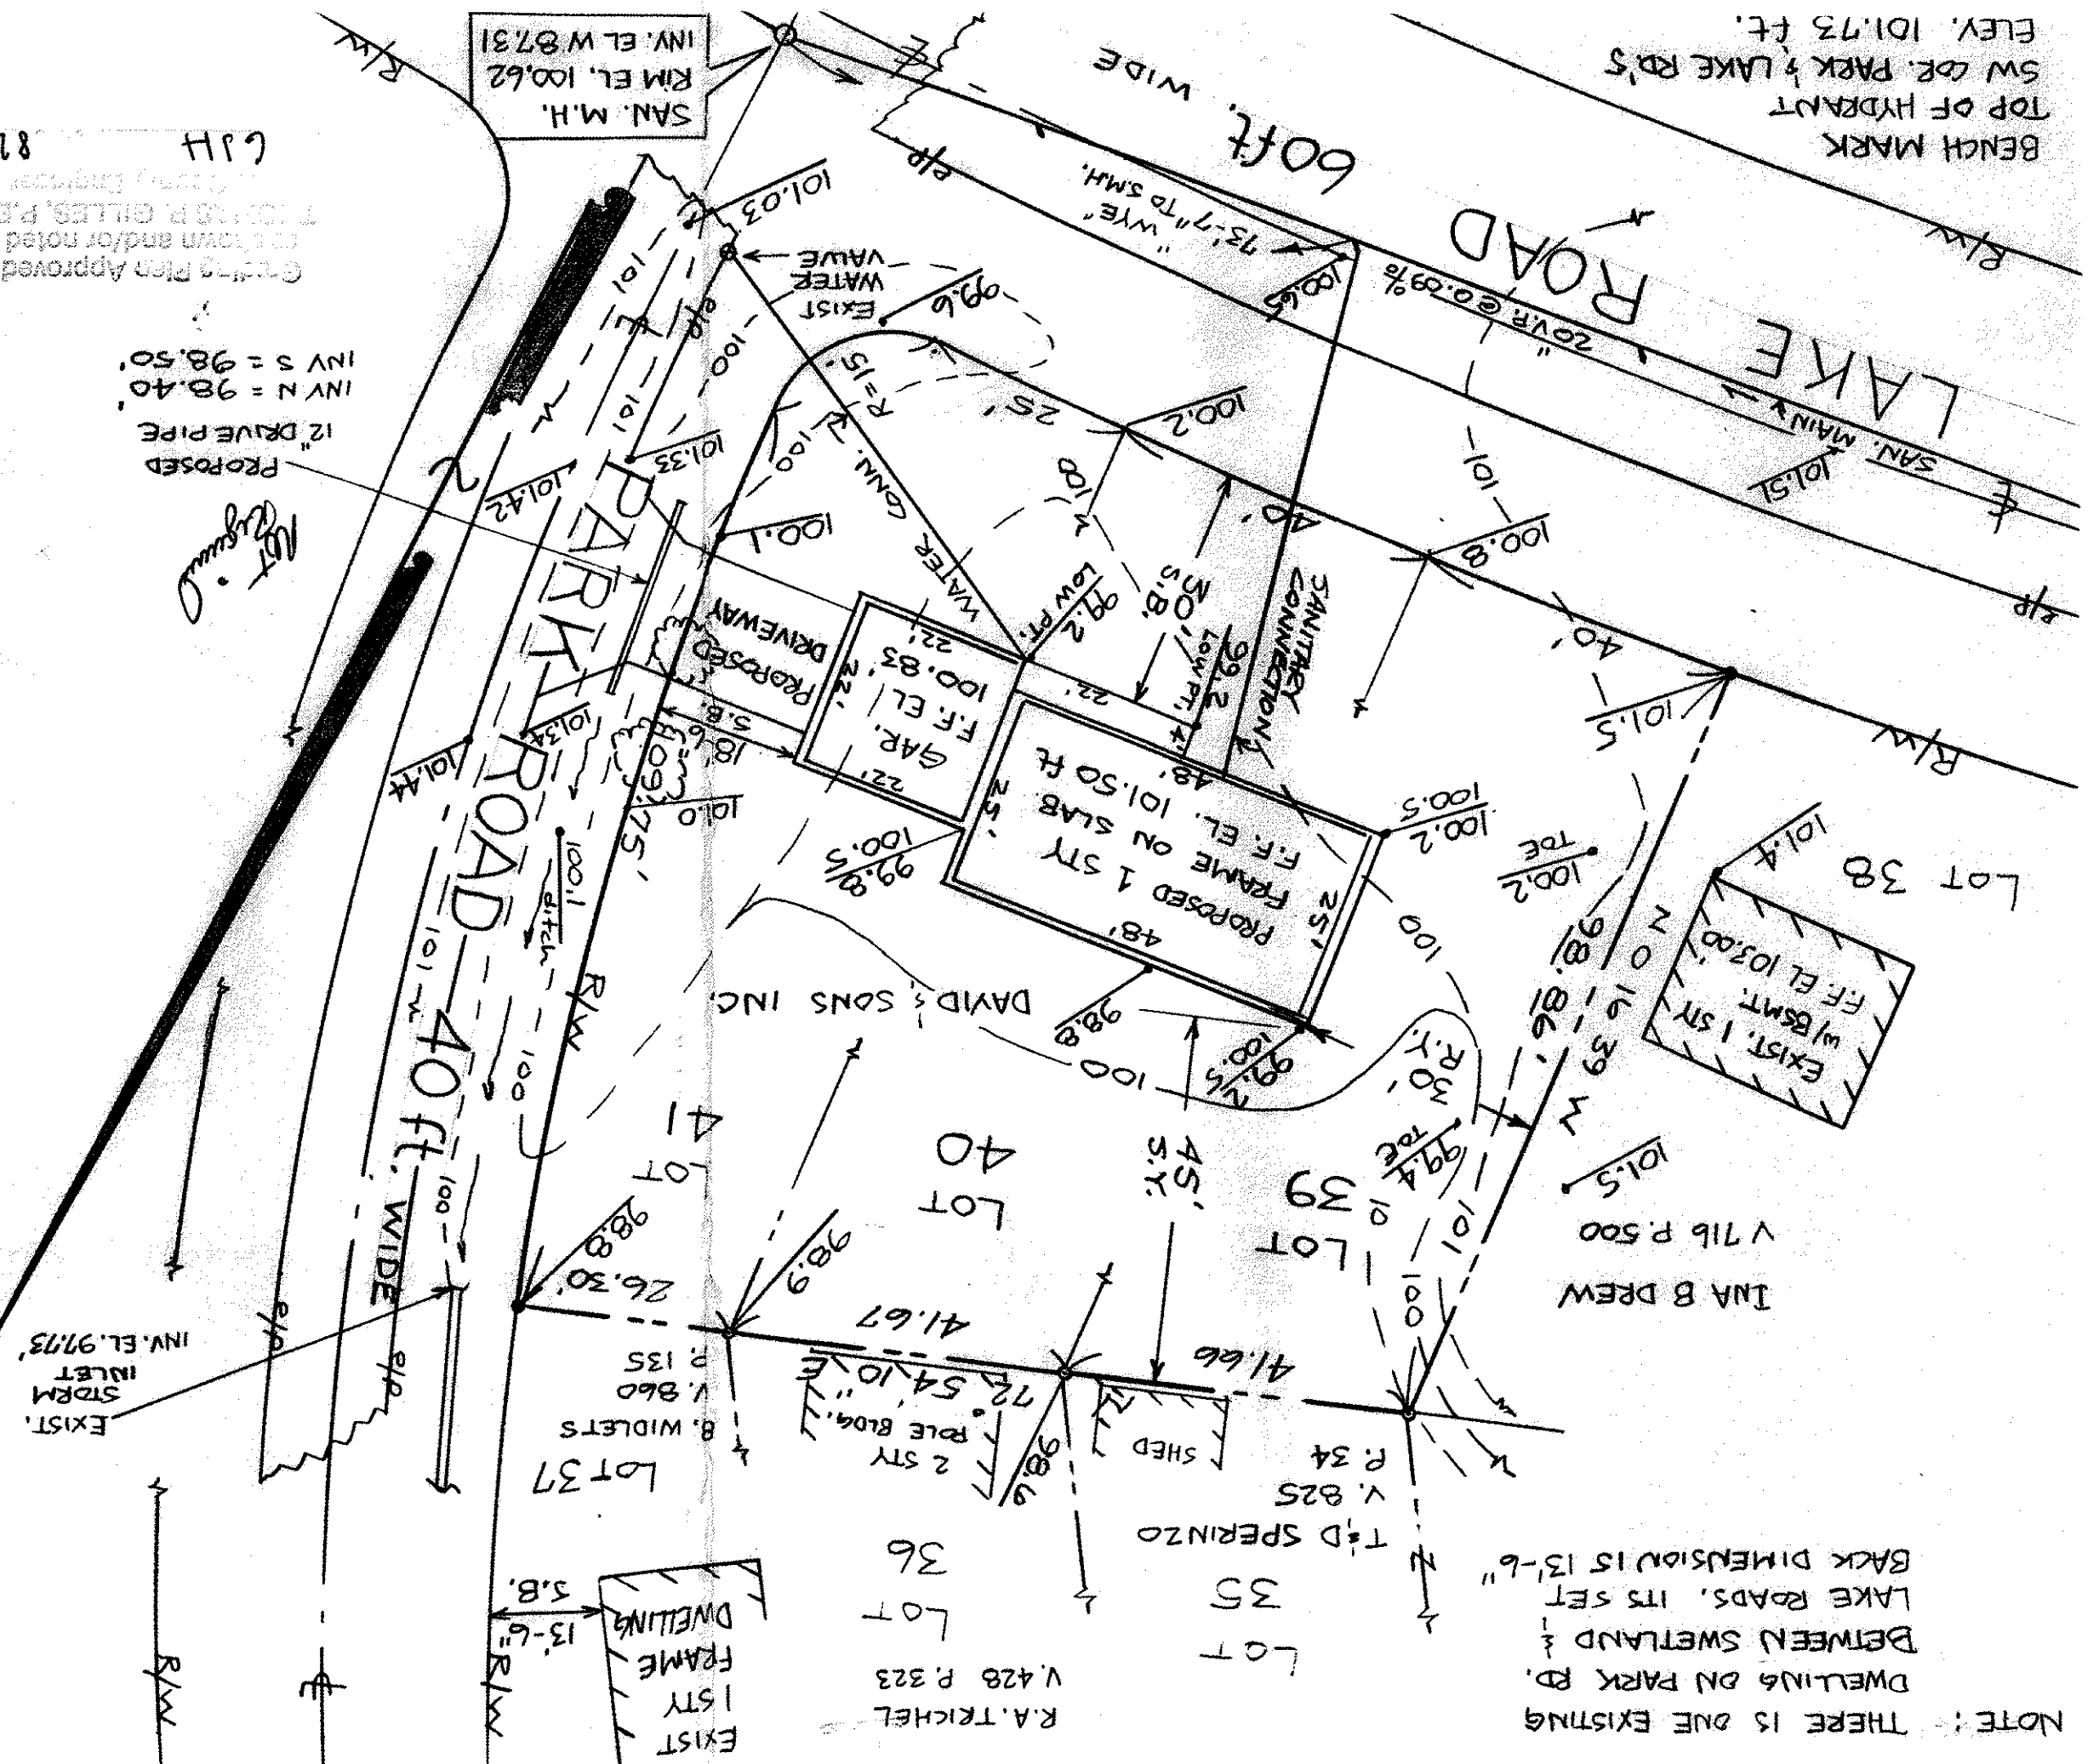

NOTE: THERE IS ONE EXISTING
DWELLING ON PARK RD.
BETWEEN SWETLAND &
LAKE ROADS. ITS SET
BACK DIMENSION IS 13'-6"

INA B DREW
V 716 P.500

T&D SPERINZO
V. 825
P. 34

R.A. TRICHEL
V. 428 P. 323

LOT 37
B. WIDETS
V. 860
P. 135

SAN. M.H.
RIM EL. 100.62
INV. EL. W 87.31

PROPOSED
12" DRIVE PIPE
INV N = 98.40
INV S = 98.50