


Jim Peter Land Survey
4759 Crosby-Cook Road
Rome, Ohio 44085
(216) 294-2187

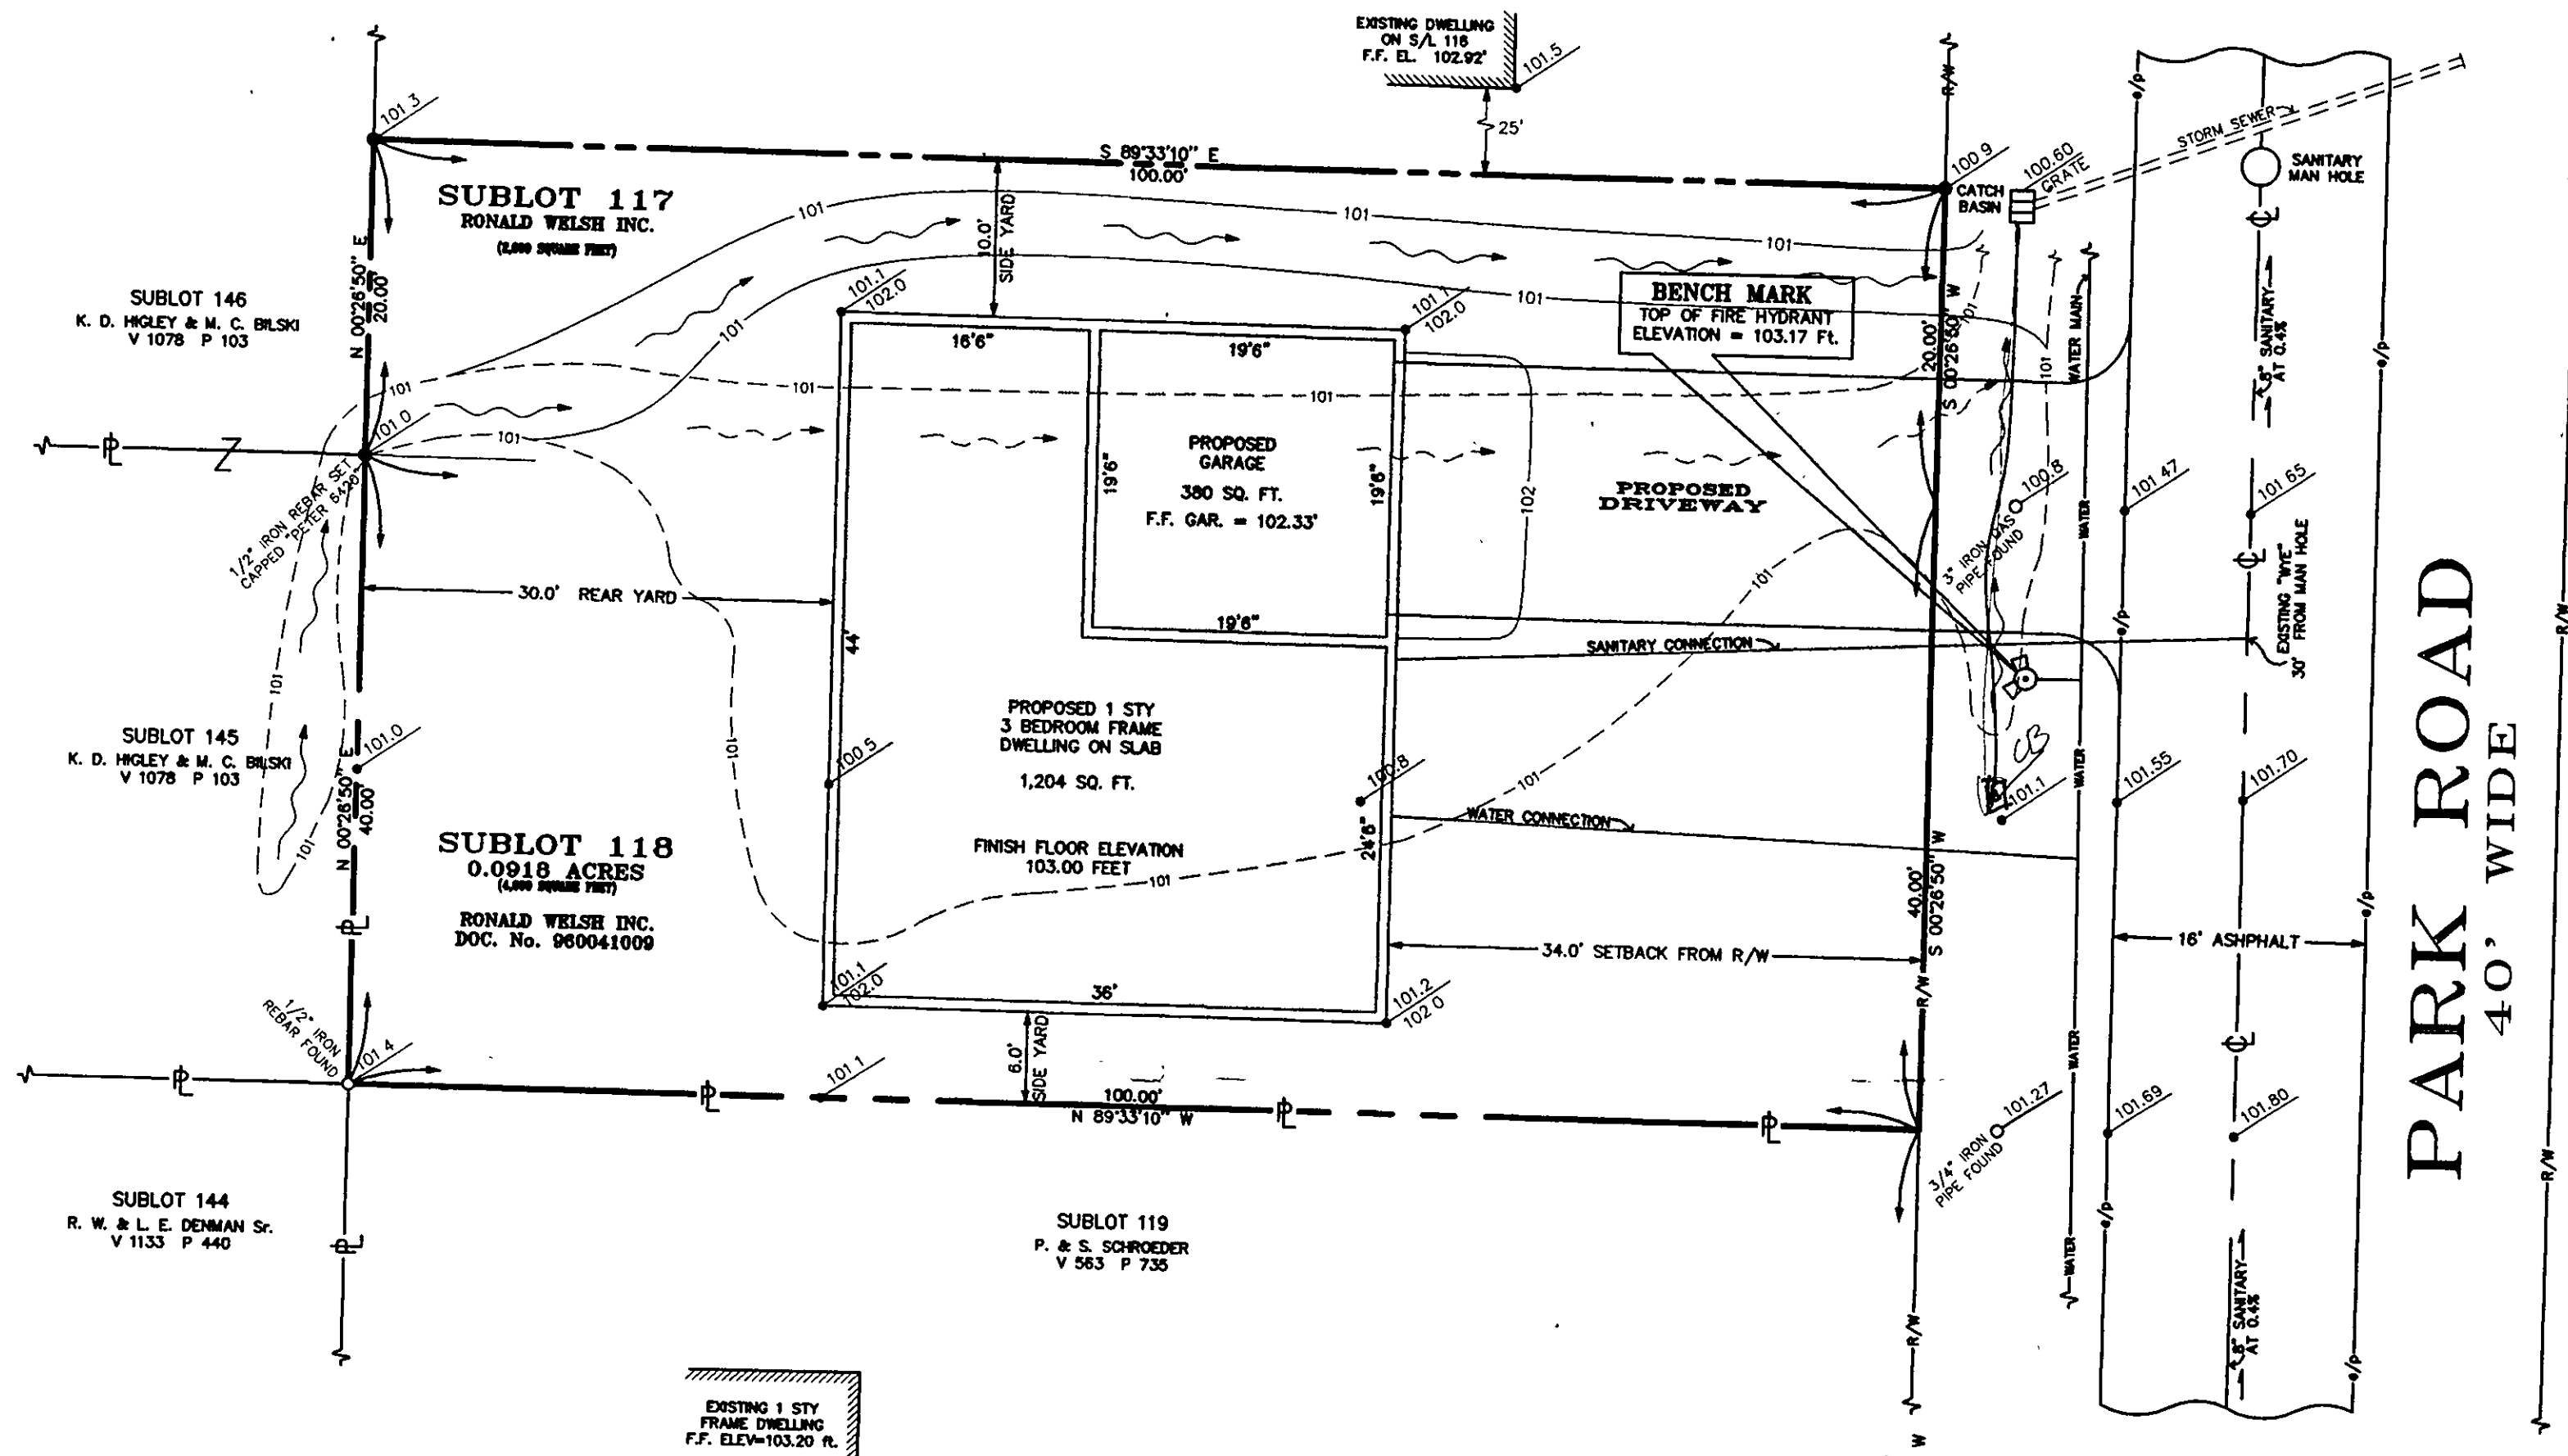


SITE DEVELOPMENT PLAN FOR RON WELSH

THE PROPERTY OF RONALD WELSH INC.
DOCUMENT 960041009, PP# 1B-115C-28

SUBLOT 118 OF MADISON LAKELAND
SUBDIVISION NUMBER 1
PLAT BOOK "D", PAGE 27

PART OF ORIGINAL LOTS 3 & 4 OF
TRACT No. 3, TOWNSHIP OF MADISON
COUNTY OF LAKE, STATE OF OHIO

REVISED 12 MAY 1998
18 MARCH 1997 SCALE 1 In. = 10 ft.

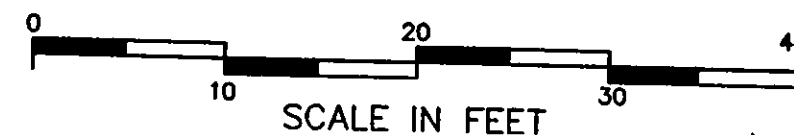

LEGEND	
	ROAD RIGHT OF WAY
	PROPERTY LINE
	CENTERLINE OF ROAD
	ROAD EDGE OF PAVEMENT
	IRON PIN FOUND
	FIRE HYDRANT
	EXISTING CONTOUR ELEVATION
	PROPOSED CONTOUR ELEVATION
	EXISTING ELEVATION
	PROPOSED ELEVATION

NOTES

ALL BEARINGS USED HEREON ARE TO AN ASSUMED MERIDIAN
AND ARE USED TO REPRESENT ANGULAR MEASUREMENT ONLY

I, THE UNDERSIGNED, DO HEREBY CERTIFY
THAT THE TOPOGRAPHY SHOWN HEREON,
INDICATED BY ONE FOOT CONTOURS,
REPRESENTS AN ACTUAL FIELD TOPO-
GRAPHIC SURVEY MADE BY ME, AND
THAT THE ELEVATIONS AS SHOWN HEREON
EXISTED ON THE 17th DAY OF MARCH
NINETEEN HUNDRED AND NINETY SEVEN.



James M. Peter
REGISTERED LAND SURVEYOR - 6420

Grading Plan Appr.
as shown and/or not
THOMAS P. GILLES, P.E.
Lake County Engineer

By 6/14 Date 5-20-98
Install CB as shown

APPROVED
MADISON TOWNSHIP ZONING
DATE 5/18/98
BY 15/63

DWG # 970303