

SITE PLAN

MADISON TOWNSHIP, LAKE COUNTY, OHIO
for: JERRY O'NEILL
CLIENT OWNER

ADDRESS STREET CITY ZIP
SUBDIVISION 41 NAME
VOLUME PERM. PARCEL NO. LOT TRACT
SUBLOT NO. STREET PAGE

LEGEND

SANITARY MANHOLE WATER VALVE (GAS)
STORM MANHOLE WATER METER (GAS)
INLET OR CATCH BASIN AS BUILT ELEVATION
HYDRANT
EXISTING CONTOURS
PROPOSED CONTOURS
EXIST. ELEV. 100.0 PROP. ELEV. 100.0
INDICATES DIRECTION OF SURFACE DRAINAGE

REMARKS

ALL BOUNDARY DATA SHOWN WAS OBTAINED FROM IDEEDS, RECORDED
SUBDIVISION PLAT OR OTHER PUBLIC RECORDS)
LOCATIONS AS SHOWN OF ADJACENT WELLS AND SEPTIC TANKS OBTAINED FROM
LAKE COUNTY HEALTH DEPARTMENT

DESIGN CERTIFICATION

THIS PLAT WAS PREPARED BY ME, AND IS CORRECT
TO THE BEST OF MY KNOWLEDGE AND BELIEF.

NAME SURVEYOR REGISTRATION NO.

CHECK LIST

NO. OF BEDROOMS
DIMENSIONS
TIE TO NEAREST STREET
SUBLOT NO. PARCEL NO.
SURROUNDING OWNERS
BLDG. DIMENSIONS FIN. GR.
BLDG. TIES F.L.R. GRADES
SIDEWALK TYPE WIDTH THICKNESS
CULVERT TYPE DIA. LENGTH
ROCK OUTCROPPINGS
WATER MAIN SIZE, LOCATION
SAN. SEWER SIZE % GR. LOC.
SAN. MH. CAST. ELEV. INV. ELEV.
SAN. CONN. SIZE LOC. DEPTH
STORM SEWER SIZE % GR. LOC.
STORM MH. CAST. ELEV. INV. ELEV.
PAV'T TYPE GRADE CURBS
GAS LINE LOC. SIZE PRESSURE
SEPTIC TANK LOCATION & DUPLICATION AREA
WELL LOCATION
ISOLATION RADIUS FROM WELL

PLAN PREPARED BY:

BABCOCK • JONES & ASSOCIATES, INC.

PAINESVILLE, OHIO

REVISIONS
NO. DATE BY
1
2
3
4
5
DRAWN BY SCALE 1" = 30'
CHK'D. DATE 7/1/85
CREW CHIEF APP'D. 7/1/85
PHONE NO. 357-1811
DRAWING NO. 83-058-41

"AS BUILT" CERTIFICATION

I, HEREBY CERTIFY THAT THE CIRCLED GRADES ARE EXISTING
FINISH GRADES CHECKED IN THE FIELD ON _____, 19____
AND ARE CORRECT TO THE BEST OF MY KNOWLEDGE AND BELIEF.

REGISTERED SURVEYOR

REG. NO.


TBM - E @ SE CORNER

OF PL 37

ELEV = 633.03



APPROVED
MADISON TWP. ZONING
Permit: 11595
Zoning Inspector: R. Jones

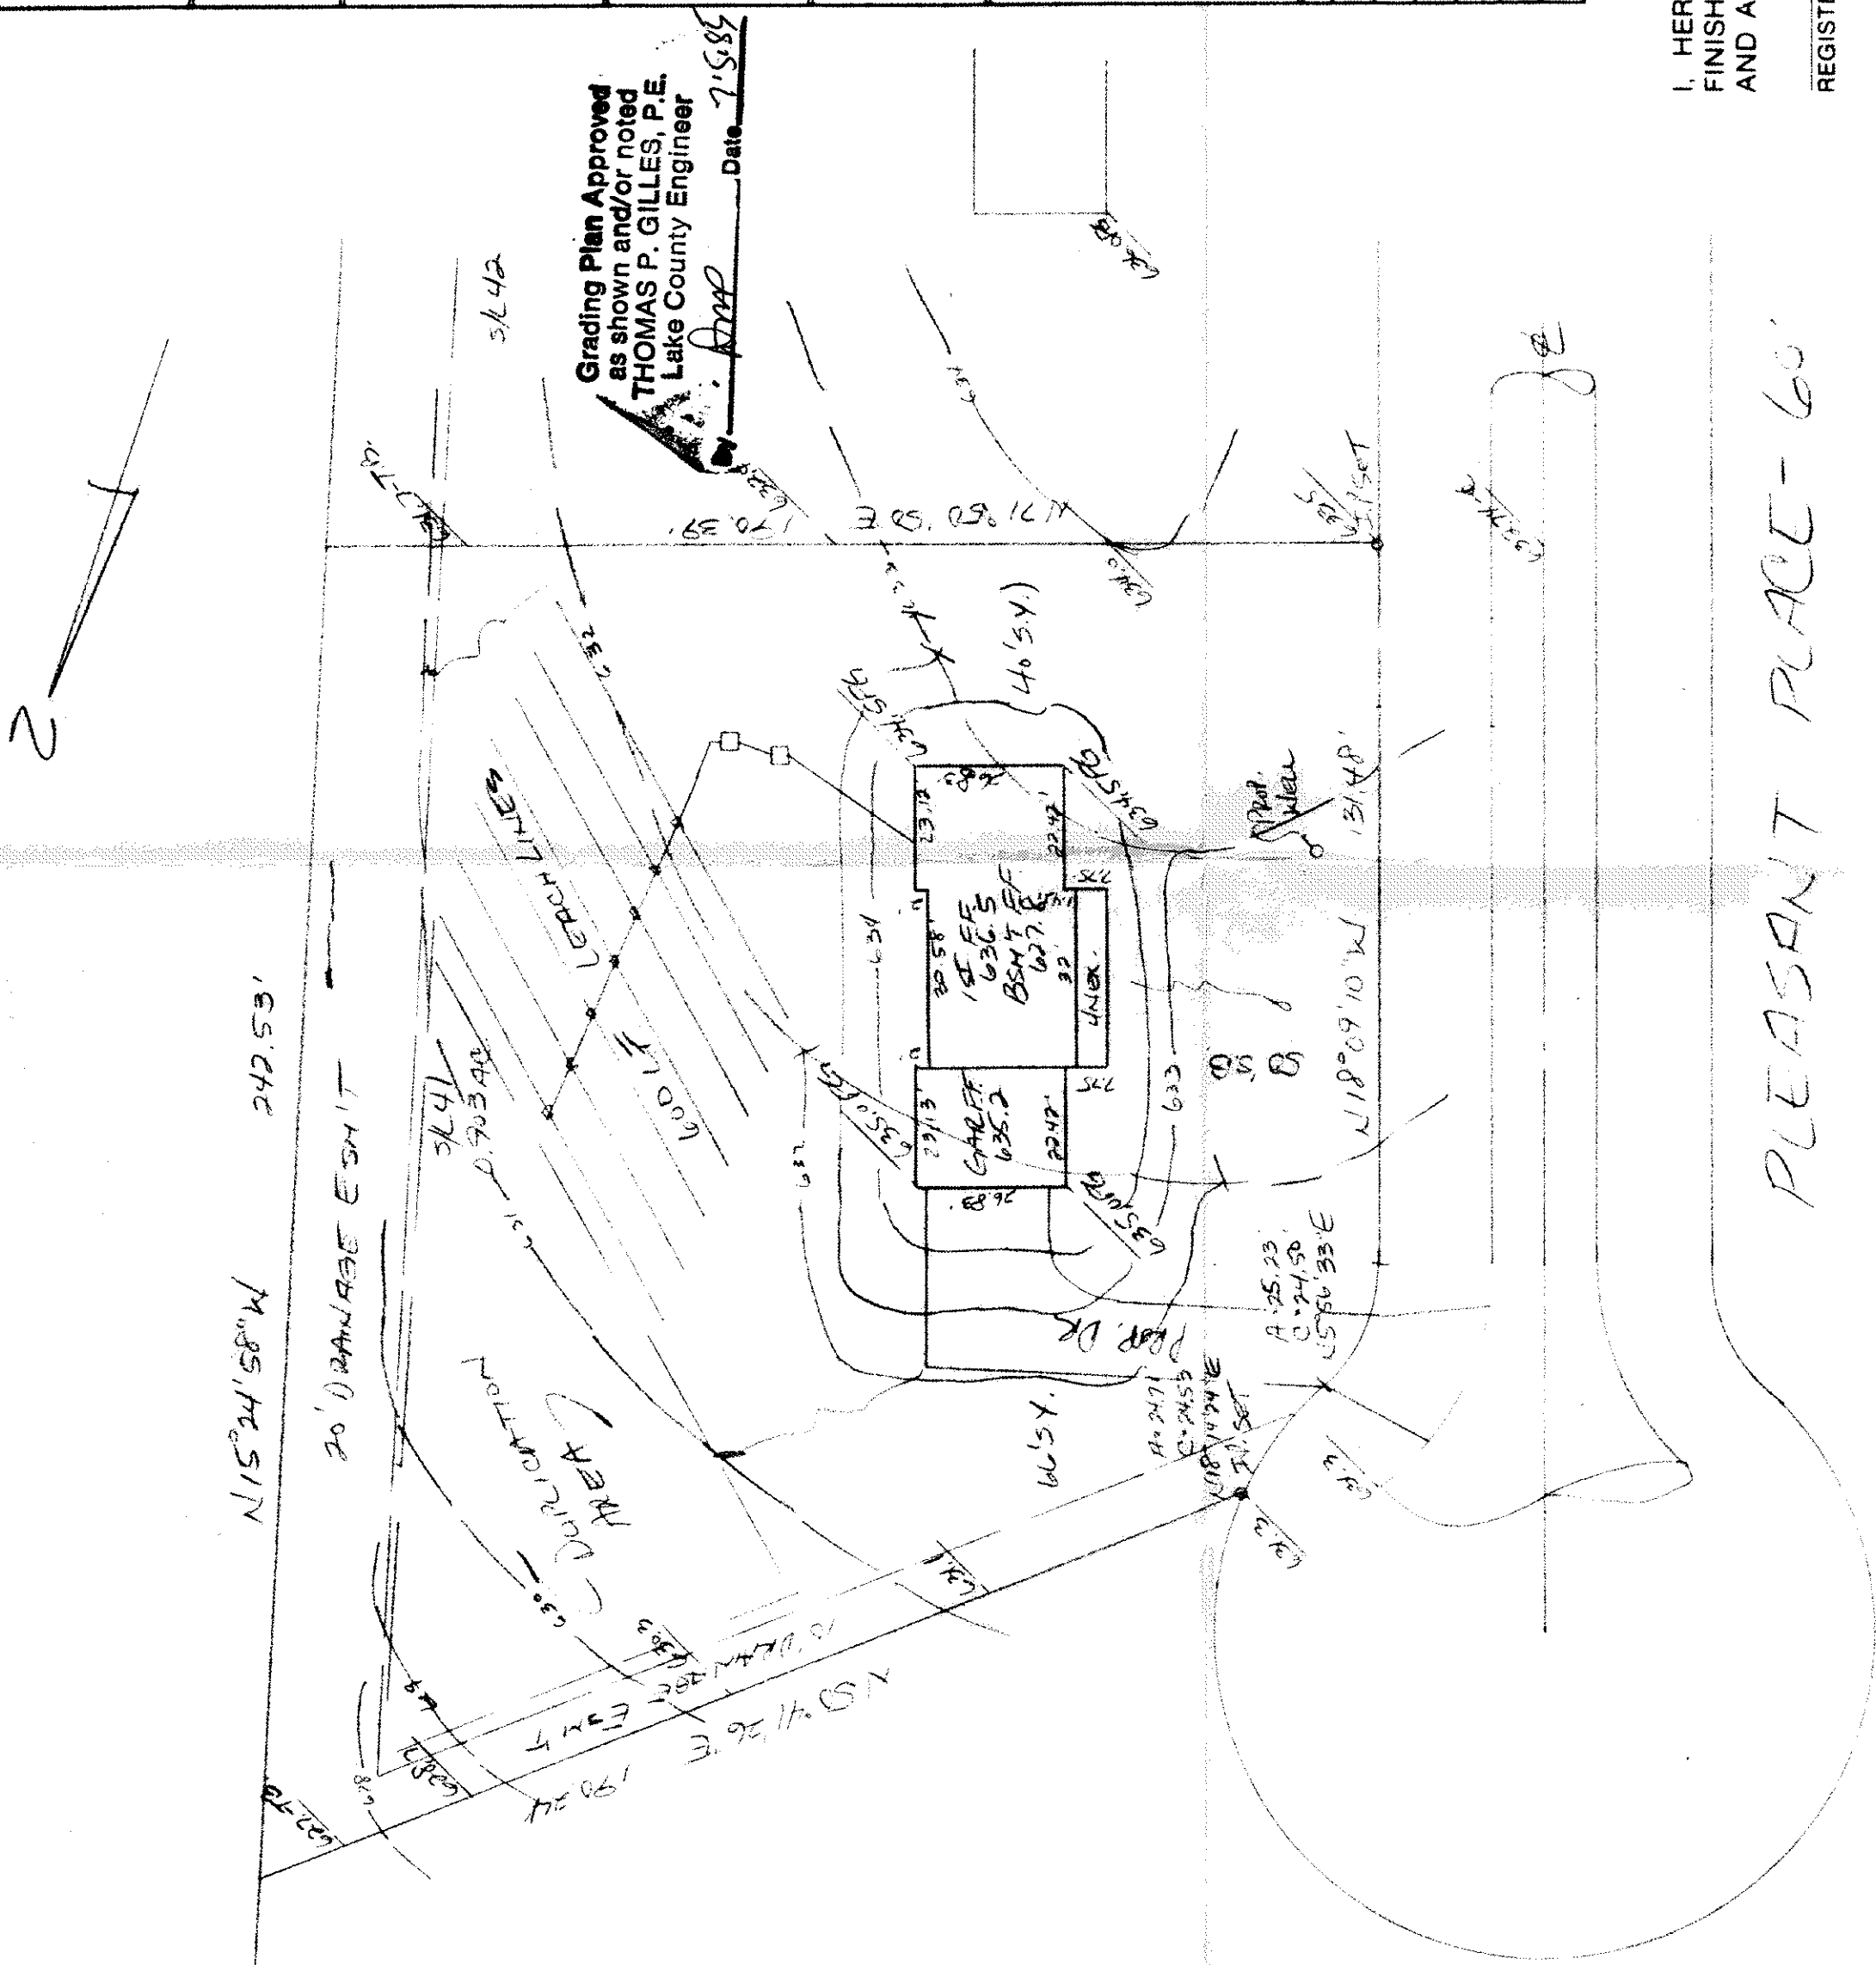

HYDRAULIC PROFILE

SCALE: 1/4" = 1' VERT. 1" = 5'

