

PROFILE
NO SCALE




618.42'

N. 0° 23' W.

618.42'

S. 0° 23' E

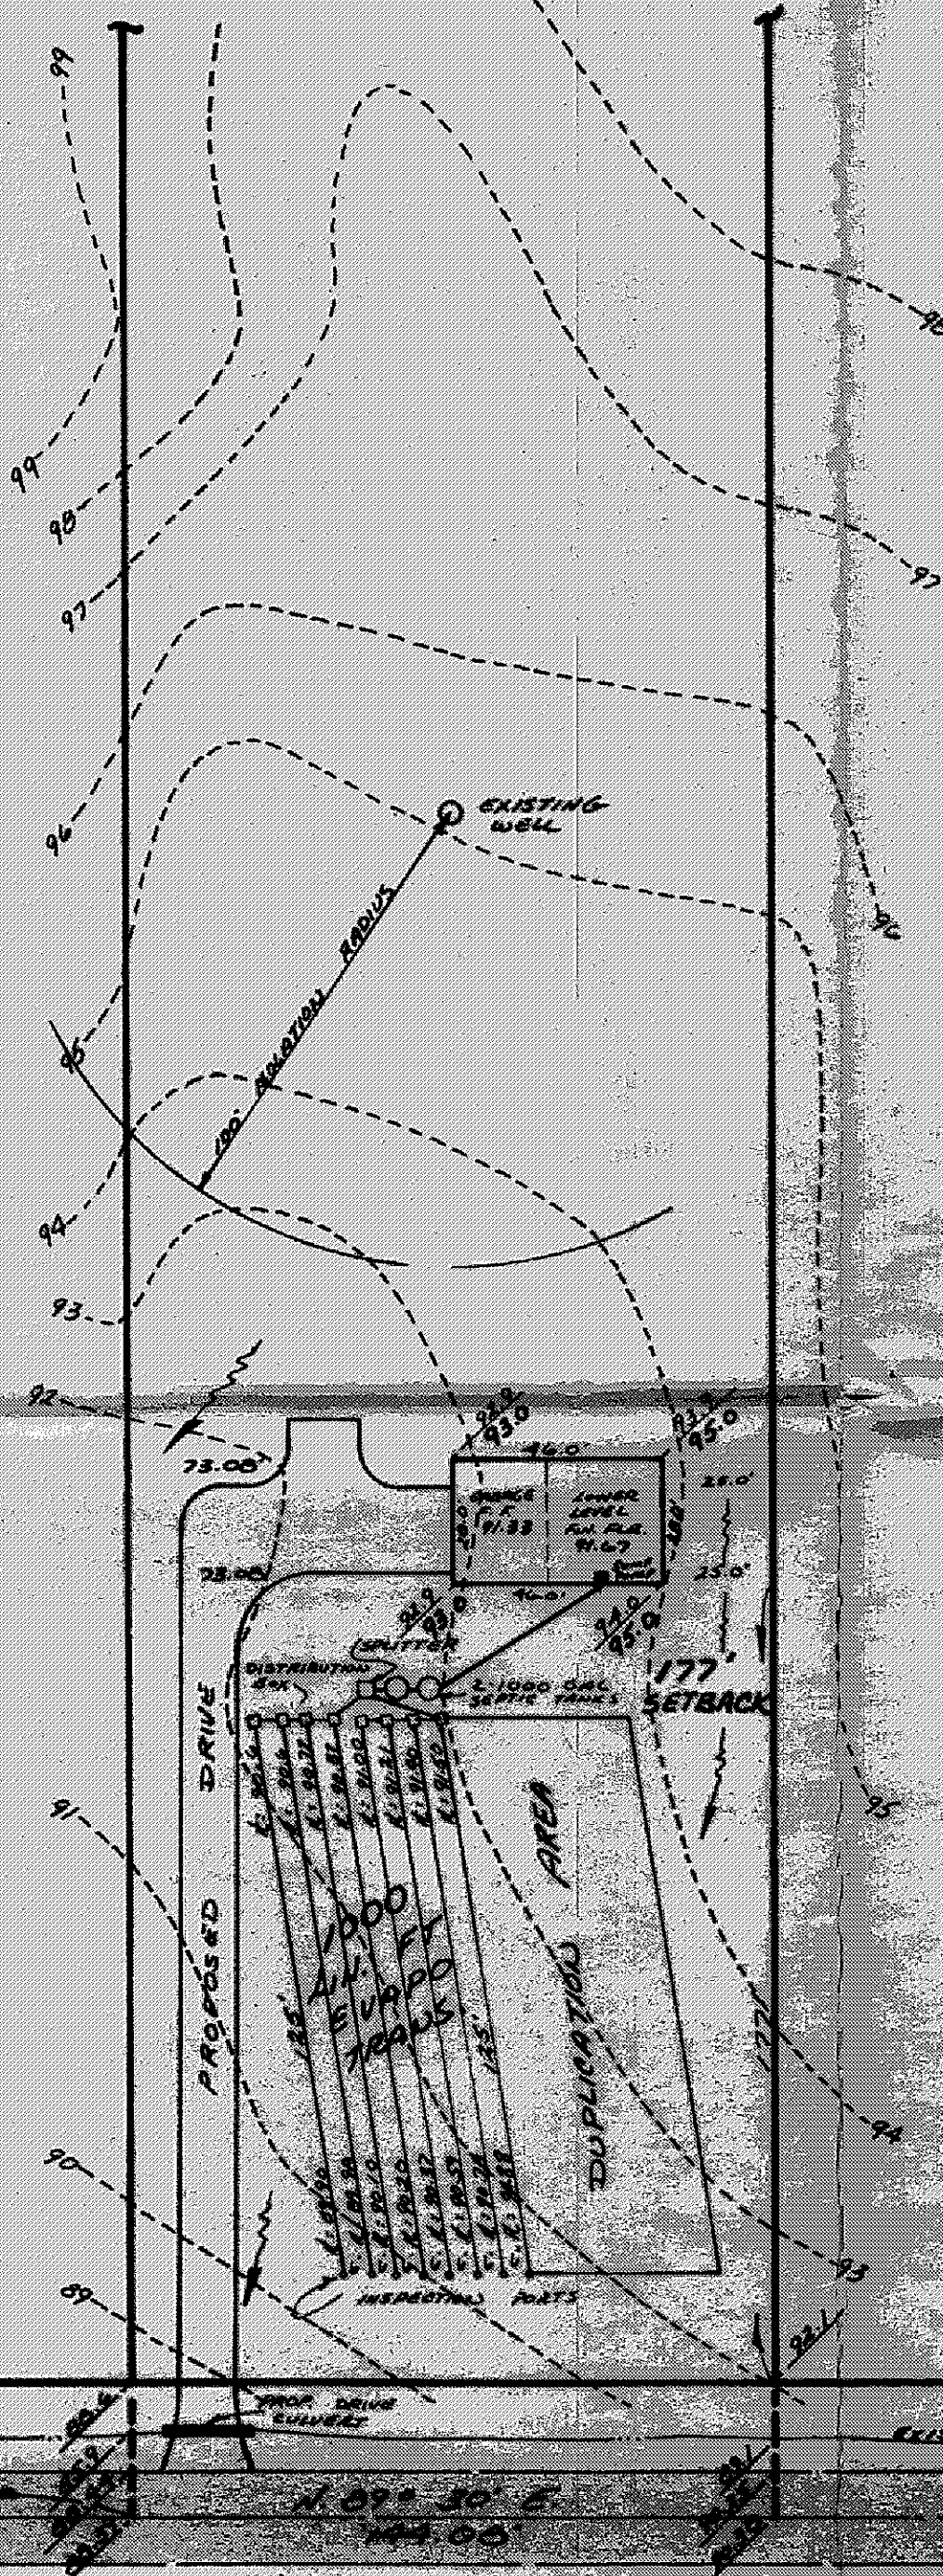

Reviewed and Accepted
LAKE COUNTY COMBINED GENERAL
DISTRICT DEPARTMENT OF HEALTH
Date 11.8.76
By FRED C. KLUTH, M.D.
Health Commissioner

SITE PLAN

MADISON TOWNSHIP LAKE COUNTY, OHIO
for: **NEFF-NAUGHTON & FAUVER**
CLIENT OWNER

ADDRESS	STREET	CITY	ZIP
SUBDIVISION	NAME	LOT 8	TRACT 8
VOL. - PG.		VOLUME	PAGE 5 OF 8
SUBLOT NO.	STREET	PERM. PARCEL NO.	STREET

LEGEND

SANITARY MANHOLE	---●---	WATER VALVE (GAS)	---●---
STORM MANHOLE	---●---	WATER METER (GAS)	---●---
INLET OR CATCH BASIN	---●---	AS BUILT ELEVATION	100.0
HYDRANT	---●---	INDICATES	
EXISTING CONTOURS	---	DIRECTION OF	
PROPOSED CONTOURS	---	SURFACE DRAINAGE	
EXIST. ELEV.	100.0		
	100.0		

REMARKS

ALL BOUNDARY DATA SHOWN WAS OBTAINED FROM (DEEDS, RECORDED SUBDIVISION PLAT OR OTHER PUBLIC RECORDS)
LOCATIONS AS SHOWN OF ADJACENT WELLS AND SEPTIC TANKS OBTAINED FROM LAKE COUNTY HEALTH DEPARTMENT

DESIGN CERTIFICATION

THIS PLAT WAS PREPARED BY ME, AND IS CORRECT TO THE BEST OF MY KNOWLEDGE AND BELIEF.
Richard J. Debevec PS#5244
NAME SURVEYOR REGISTRATION NO.

CHECK LIST


NO. OF BEDROOMS	WATER MAIN SIZE, LOCATION
DIMENSIONS	SAN. SEWER SIZE % GR. LOC.
BEARINGS	SAN. MH. CAST. ELEV. INV. ELEV.
TIE TO NEAREST STREET	SAN. CONN. SIZE, LOC. DEPTH
SUBLOT NO. PARCEL NO.	STORM SEWER SIZE % GR. LOC.
SURROUNDING OWNERS	STORM MH. CAST. ELEV. INV. ELEV.
BLDG. DIMENSIONS FIN. GR.	PAV'T TYPE GRADE CURBS
BLDG. TIES PLT. GRADES	GAS LINE LOC. SIZE PRESSURE
APRON TYPE WIDTH THICKNESS	SEPTIC TANK LOCATION & DUPLICATION AREA
SEWER TYPE WIDTH THICKNESS	WELL LOCATION
CULVERT TYPE DIA. LENGTH	ISOLATION RADIUS FROM WELL
ROCK OUTCROPPINGS	

NO.	DATE	BY	PLAN PREPARED BY:
1			DEBEVEC-SALO & ASSOCIATES, INC.
2			130 EAST JACKSON ST. PAINESVILLE, OHIO
3			DRAWN BY SCALE 1" = 40'
4			CHK'D DATE 1 NOV 76
5			CREW CHIEF APP'D. 3616-AA

"AS BUILT" CERTIFICATION

I, HEREBY CERTIFY THAT THE CIRCLED GRADES ARE EXISTING FINISH GRADES CHECKED IN FIELD ON 19 BY SURVEYING AND ARE CORRECT TO THE BEST OF MY KNOWLEDGE AND BELIEF.

REGISTERED SURVEYOR REG. NO.

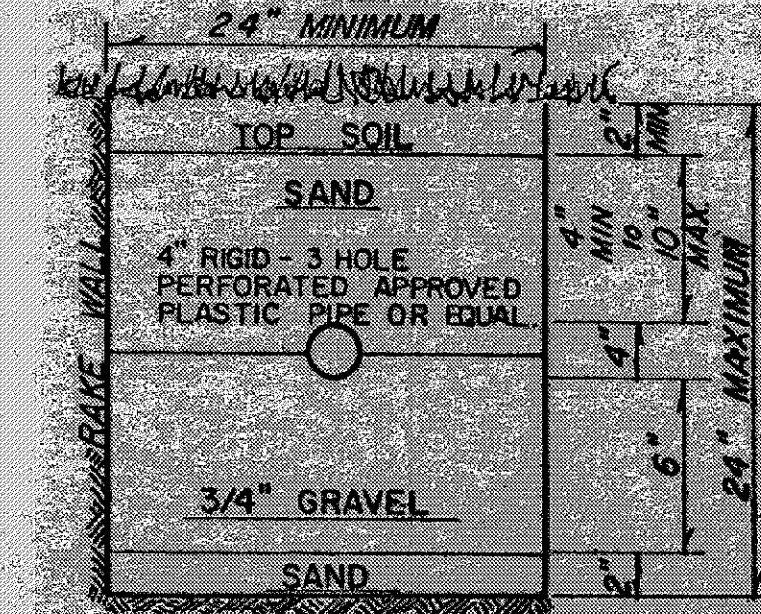

TRENCH CROSS SECTION

NO SCALE

3616-AA

682' TO DAYTON ROAD

Grading Plan Approved as shown and/or noted by THOMAS P. GILLES, P.E. Lake County Engineer Date 11-8-76

RIVER ROAD 60'