


Approved
Madison Township
Permit # 8345
Zoning Inf. OLB

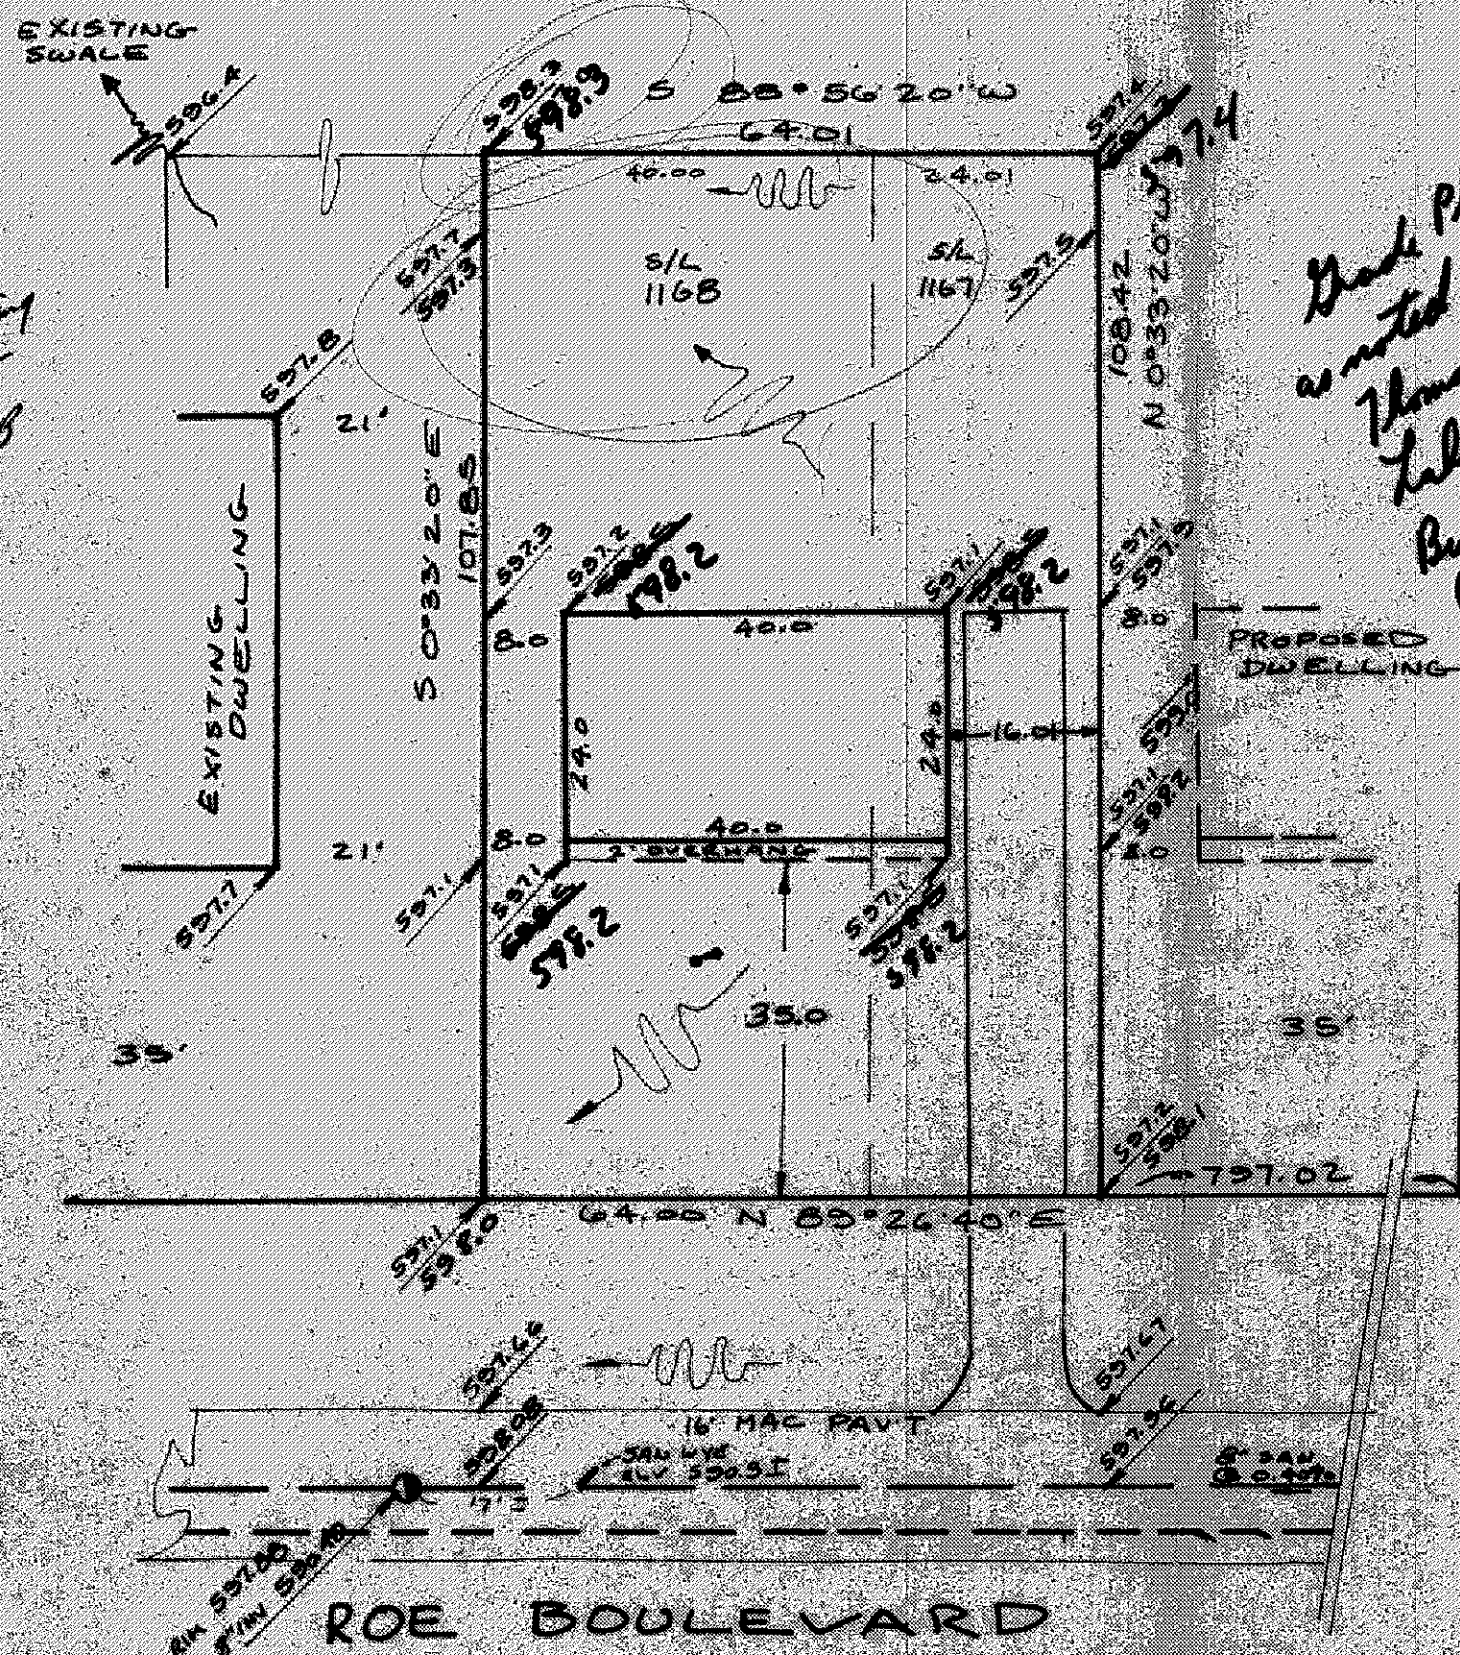

Grade Plan Approved
as noted
Thomas P. Gilles P.E.
Lake County Engineer
By 244 19 April 72

SITE PLAN

MADISON TOWNSHIP LAKE COUNTY, OHIO
for RYAN HOMES, INC.
CLIENT OWNER
6996 ROE BLVD MADISON 44057
ADDRESS STREET CITY ZIP

CUMINGS BEACH PARK		LOT	TRACT
RECORD	SUBDIVISION		
VOLUME	PAGE		
1167-1168	ROE BLVD		
SUBLOT NO	STREET	PERM PARCEL #	STREET

LEGEND

SANITARY MANHOLE	○	WATER VALVE (GAS)	+
STORM MANHOLE	●	WATER METER (GAS)	⊕
INLET OR CATCH BASIN	■	AS BUILT ELEVATION	100.0
HYDRANT	⊙		
EXISTING CONTOURS	- - -		
PROPOSED CONTOURS	- - -		
EXIST. ELEV.	100.0		
	100.0 - PROP. ELEV.		
		DIRECTION OF SURFACE DRAINAGE	↓

REMARKS

ALL BOUNDARY DATA SHOWN WAS OBTAINED FROM (DEEDS, RECORDED SUBDIVISION PLAT, OR OTHER PUBLIC RECORDS)

DESIGN CERTIFICATION

THIS PLAT WAS PREPARED BY ME, AND IS CORRECT TO THE BEST OF MY KNOWLEDGE AND BELIEF
Richard J. Bisk PS# 5244
NAME SURVEYOR REGISTRATION NO.

CHECK LIST

DIMENSIONS	WATER MAIN SIZE LOCATION
BEARINGS	SAN SEWER SIZE % GR LOC
TIE TO NEAREST STREET	SAN MH CAST ELEV INV ELEV
SUBLOT NO. PARCEL NO.	SAN CONN SIZE LOC DEPTH
SURROUNDING OWNERS	STORM SEWER SIZE % GR LOC
BLOG DIMENSIONS FIN GR	STORM MH CAST ELEV INV ELEV
BLOG TIES FLR GRADES	PAVT TYPE GRADE CURBS
APRON TYPE WIDTH THICKNESS	GAS LINE LOC SIZE PRESSURE
SIDEWALK TYPE WIDTH THICKNESS	SEPTIC TANK SIZE LOC
CULVERT TYPE DIA LENGTH	WELL LOCATION

ROE BOULEVARD

"AS BUILT" CERTIFICATION

I, HEREBY CERTIFY THAT THE CIRCLED GRADES ARE EXISTING FINISH GRADES CHECKED IN FIELD ON 19 BY SURVEYING AND ARE CORRECT TO THE BEST OF MY KNOWLEDGE AND BELIEF

REGISTERED SURVEYOR NO

REVISIONS			PLAN PREPARED BY:		
NO	DATE	BY	<u>DEBEVERE, SALO & ASSOC. INC</u>		
1			NAME		
2			<u>130 E. JACKSON ST. PRINCEVILLE, O</u>		
			ADDRESS		
3			DRAWN BY <u>RJB</u>	SCALE 1" = 20'	PHONE NO.
4			CHK'D	DATE <u>MAR 17, 72</u>	DRAWING NO.
5			CREW CHIEF	APPRO	<u>3528-1167</u>