


SITE PLAN
FOR
PAC HOMES INC.

APPROVED
MADISON TWP. ZONING
2565
JUL 24 1989
TOWNSHIP INSPECTOR: *[Signature]*

J.M. & N.C. BALDWIN
V. 888 - 850

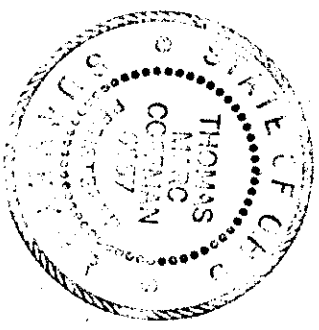

BEING PART OF LOT 5, TRACT 3, IN THE TOWNSHIP OF
MADISON, COUNTY OF LAKE, STATE OF OHIO.

SCALE: 1" = 20'

DATE: 6-26-89

APPROVED BY

DRAWN BY


THIS PLAT WAS PREPARED BY ME
AND IS ACCURATE TO THE BEST
OF MY KNOWLEDGE AND BELIEF.

Thomas P. Gilles, P.E.
REG. SURVEYOR

Grading Plan Approved
as shown and/or noted
THOMAS P. GILLES, P.E.
Lake County Engineer
Date 7/27/89
By GJH
1. Swale as shown

BENCHMARK - ELEV.
N. RIM SAN M/H - 599.34

ROBERT GILLETTE
V. 614 - 260
(VACANT)

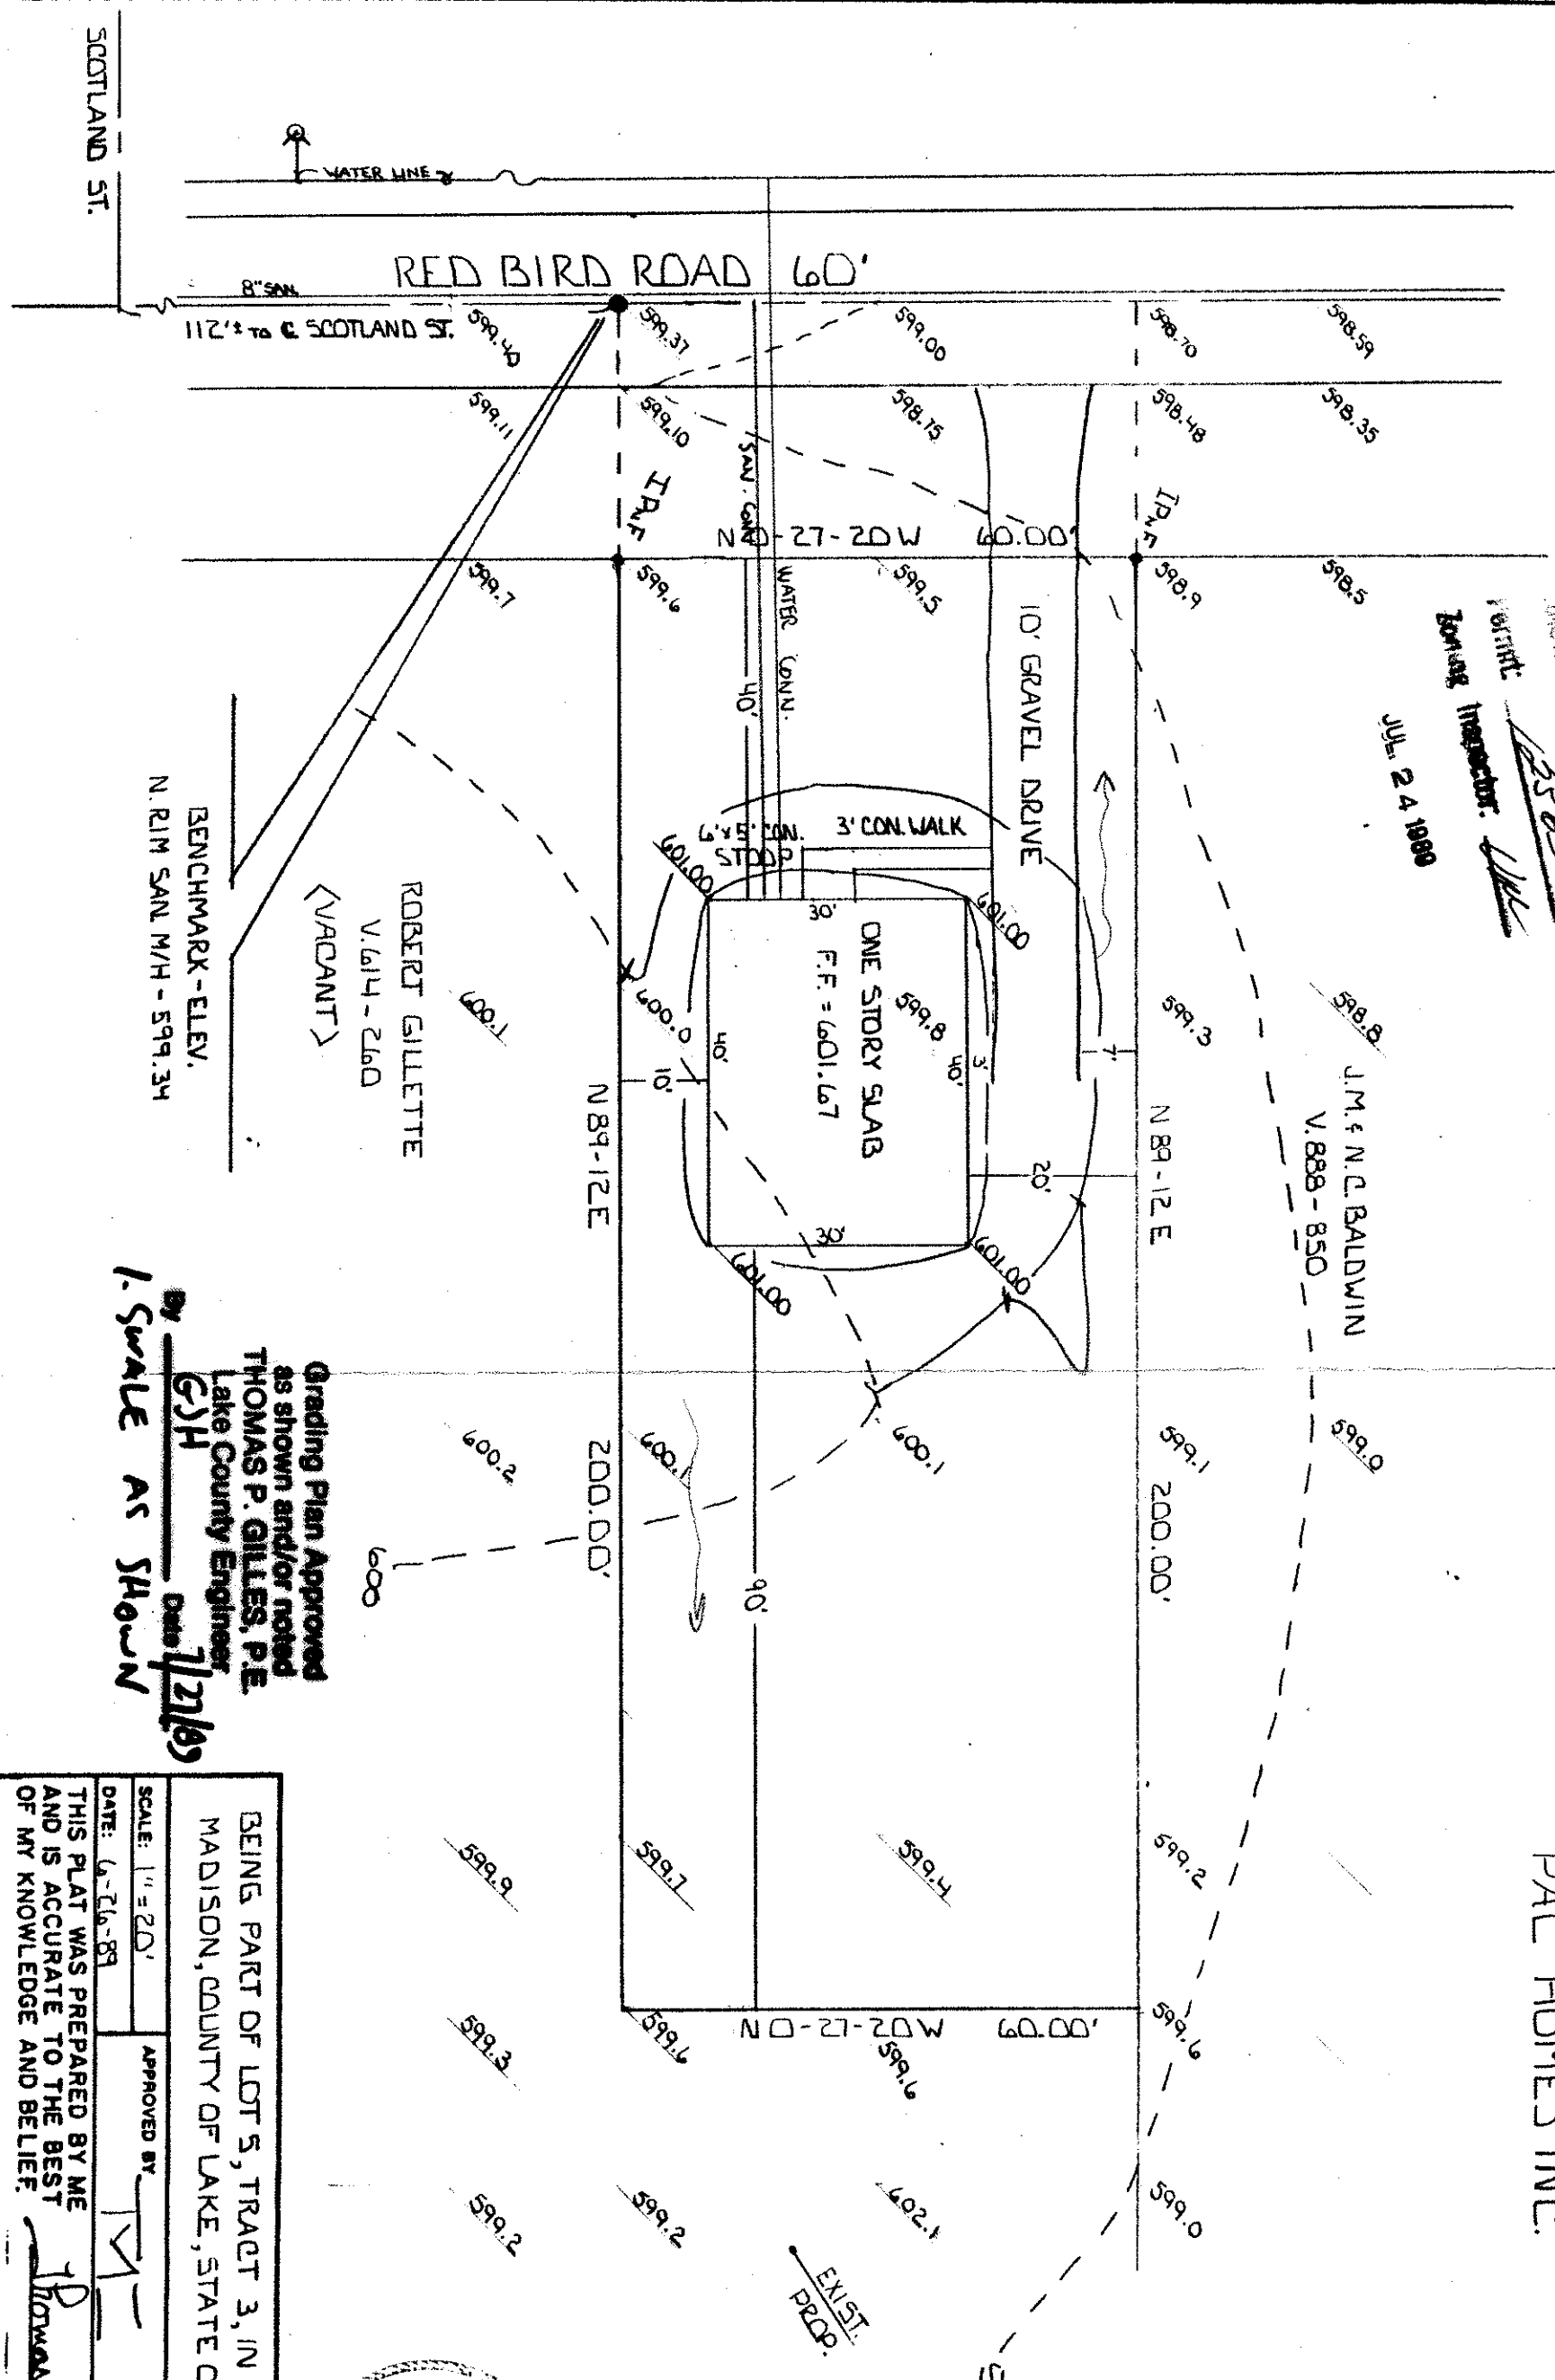

SCOTLAND ST.

RED BIRD ROAD 60'

112' ± TO E. SCOTLAND ST.

27-20 W

N 89-12 E

N 89-12 E

200.00'

200.00'

M 02-12-0 N

EXIST.
PROP.

EXIST.
PROP.