
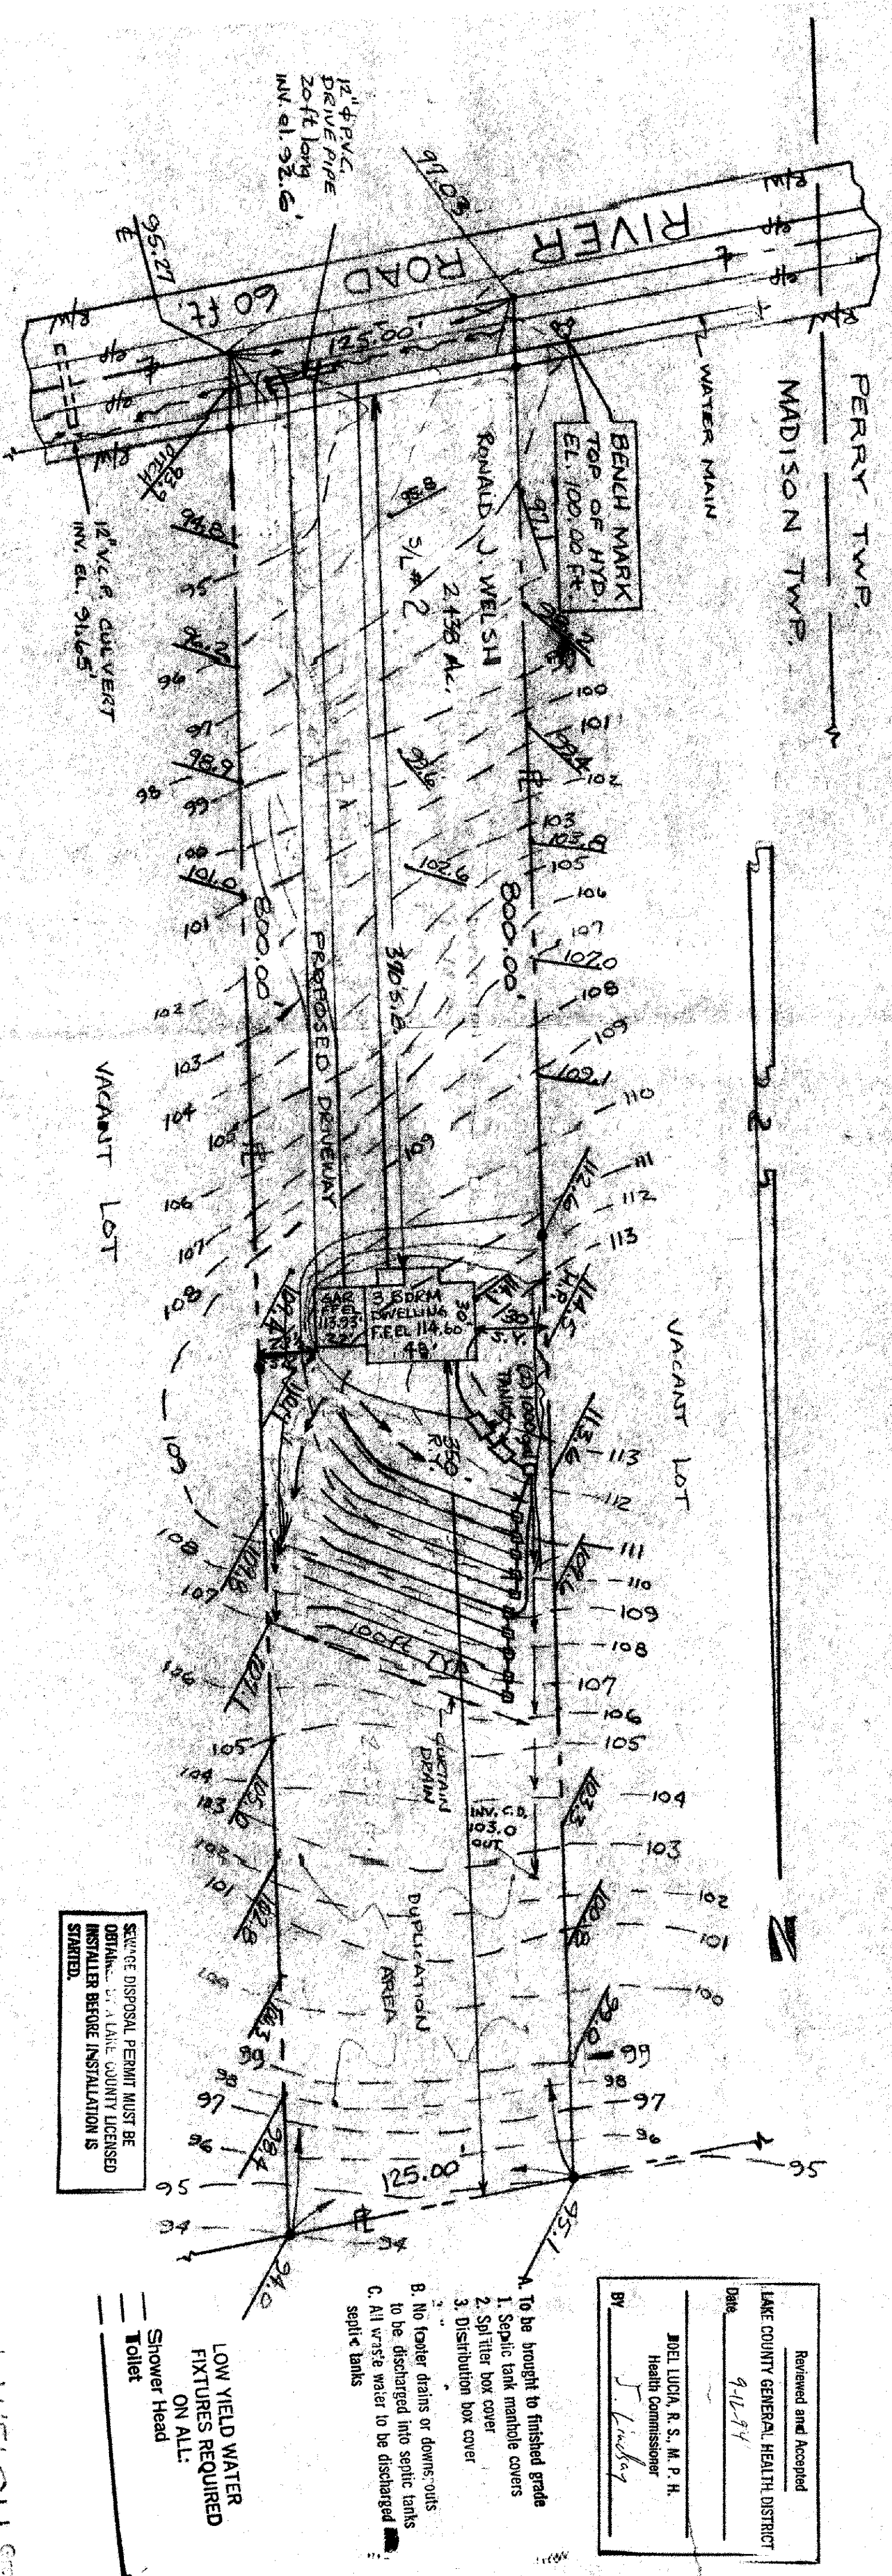


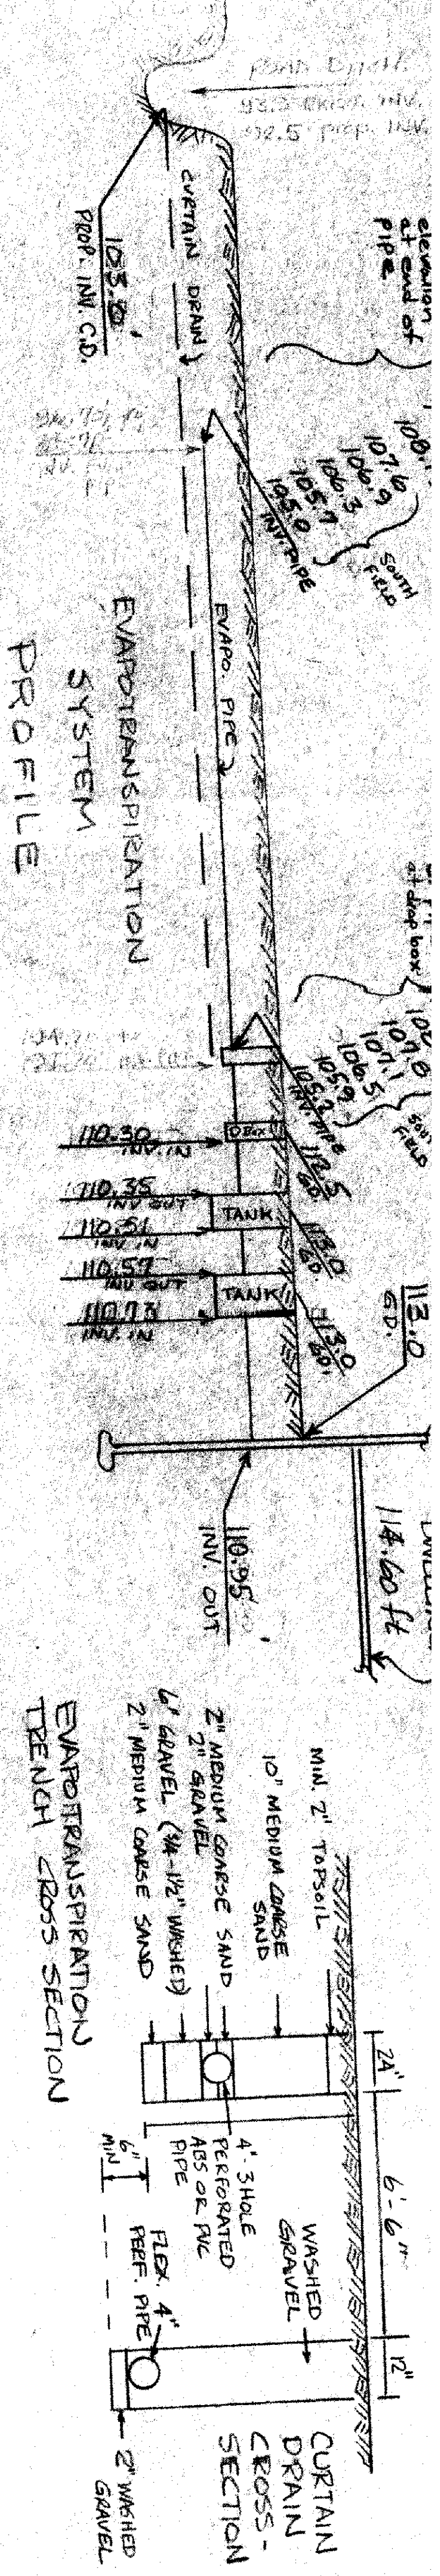

NOTE: 2 fields of evapotranspiration lines totaling 1000 ft in length as shown. 8 ft min between evapotranspiration lines. 8 ft min between curtain drain & evapotranspiration lines. PROPOSED 1 STY. FRAME DWELLING 3 BRDM. FINISH FLOOR EL. 114.60 ft. PROPOSED GARAGE FINISH FLOOR EL. 113.93 ft.

THESE ARE NO PROPOSED POWER DRAINS. I HEREBY CERTIFY THAT THE TOPOGRAPHY SHOWN HEREON, INDICATED BY ONE FOOT CONTOURS & ELEVATIONS, REPRESENTS AN ACTUAL FIELD TOPOGRAPHIC SURVEY MADE BY ME ON THE 25TH DAY OF AUGUST 1994, AND THAT AS OF THAT DATE THE TOPOGRAPHY EXISTED AS SHOWN HEREON.

REV. 9 SEPT. '94
6 SEPT. 1994
SCALE 1" = 50 ft.

SITE PLAN for RONALD J. WELSH
2.4 ACRE PARCEL ON RIVER ROAD TRACT 5
MADISON TOWNSHIP, LAKE COUNTY, O.
By Jim Peter Land Survey Date 12/29/94
as shown and/or noted
THOMAS P. GILLES, P.E.
Professional Engineer

JIM PETER LAND SURVEY
4759 CROSBY CREEK RD.
PAME, OHIO 44085

• DEPUTY 1800 PIN

SEWAGE DISPOSAL PERMIT MUST BE OBTAINED BY A LAKE COUNTY LICENSED INSTALLER BEFORE INSTALLATION IS STARTED.

- To be brought to finished grade
- Septic tank manhole covers
- Split filter box cover
- Distribution box cover
- No toilet drains or downspouts to be discharged into septic tanks
- All waste water to be discharged into septic tanks

Reviewed and Accepted
LAKE COUNTY GENERAL HEALTH DISTRICT
Date 9-11-94
JOEL LUCIA, R.S., M.P.H.
Health Commissioner
By J. Lucida

LOW YIELD WATER FIXTURES REQUIRED ON ALL:
Shower Head
Toilet

APPROVED
THOMAS P. GILLES, P.E.
Professional Engineer
Date 12/29/94