
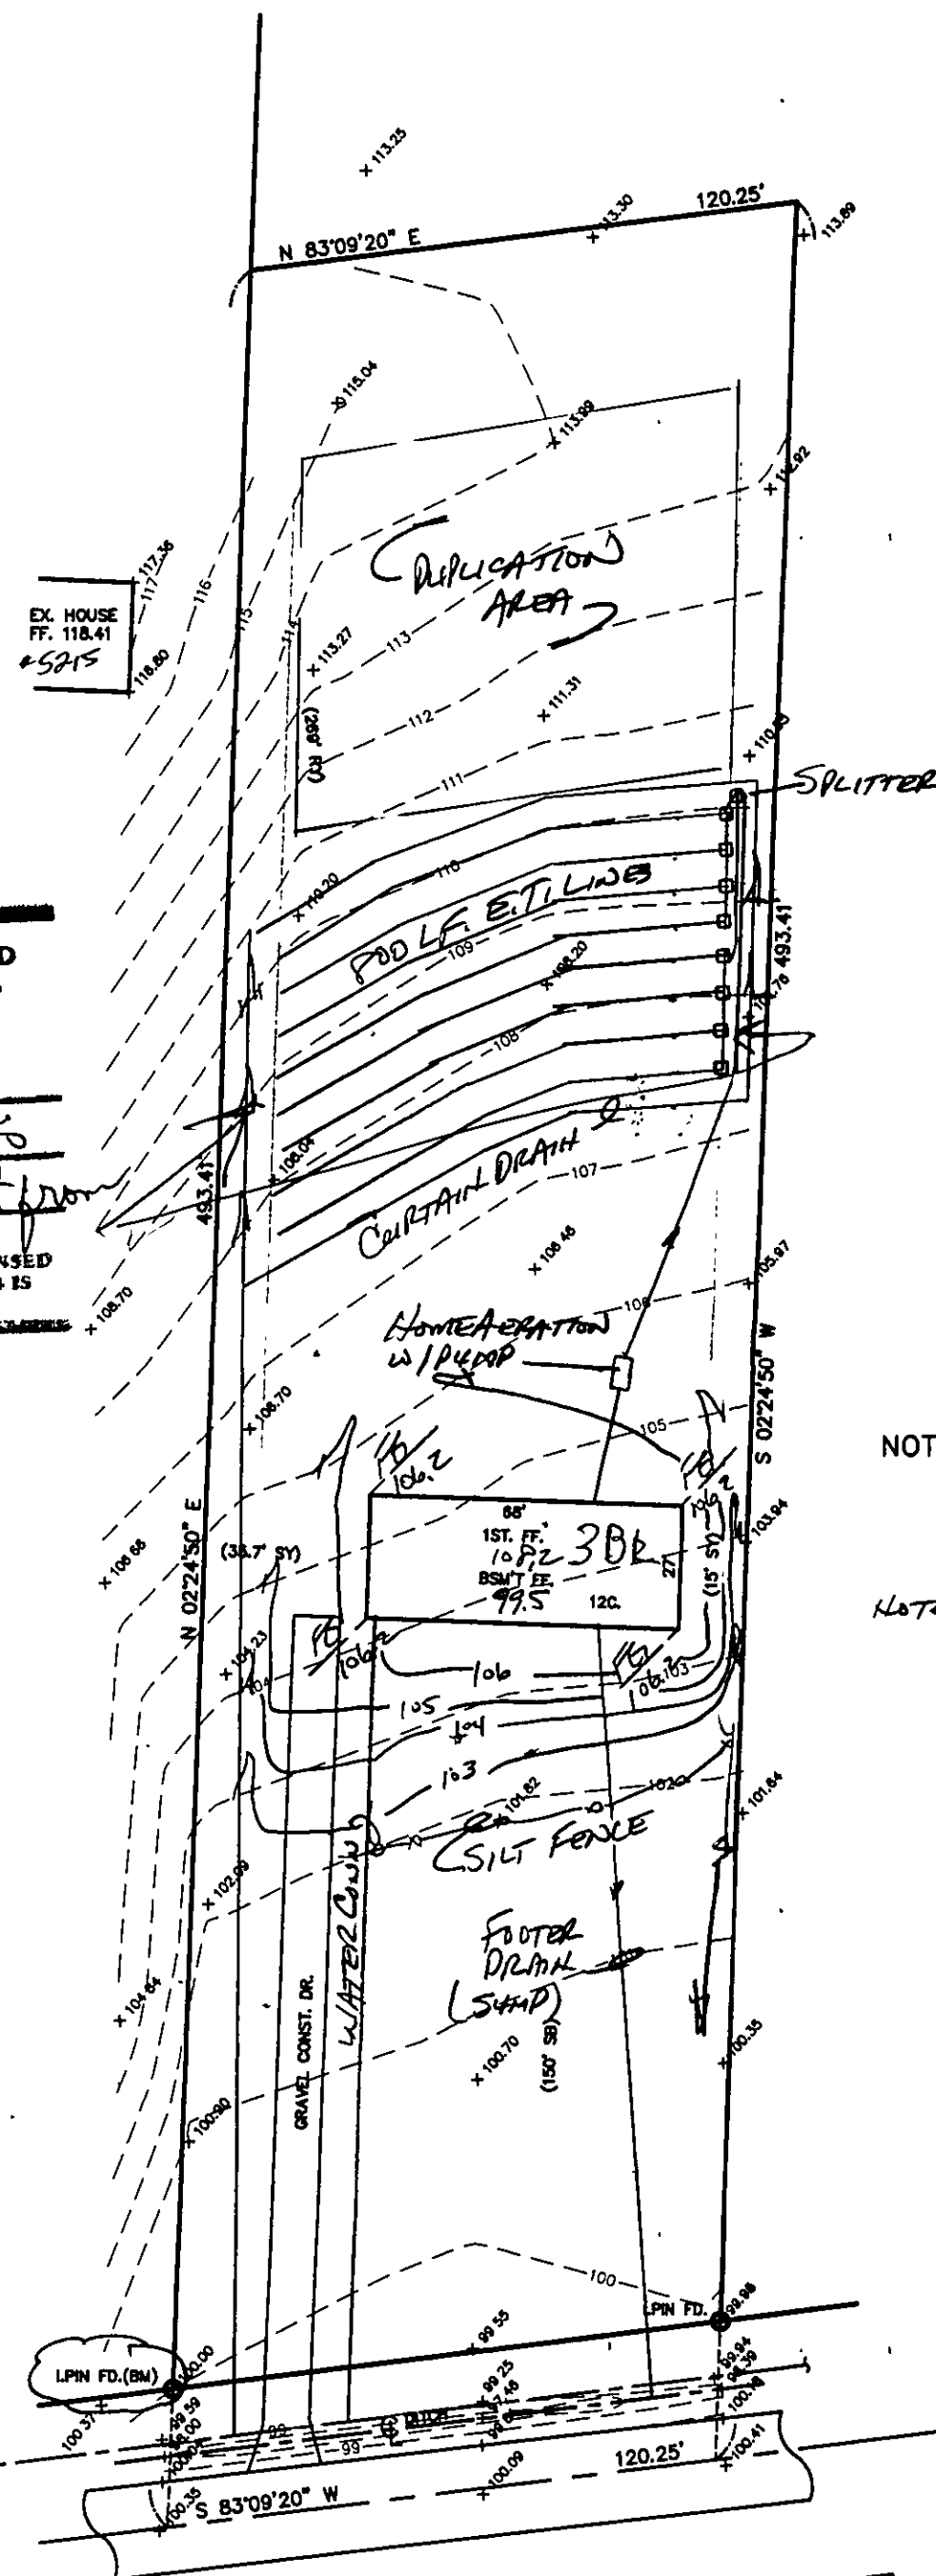


REVIEWED AND ACCEPTED
LAKE COUNTY GENERAL
HEALTH DISTRICT

Date 6-4-01
David B. Moss
all systems are 20ft from
SEWAGE DISPOSAL PERMIT MUST BE
OBTAINED BY A LAKE COUNTY LICENSED
INSTALLER BEFORE INSTALLATION IS
STARTED
all property lines

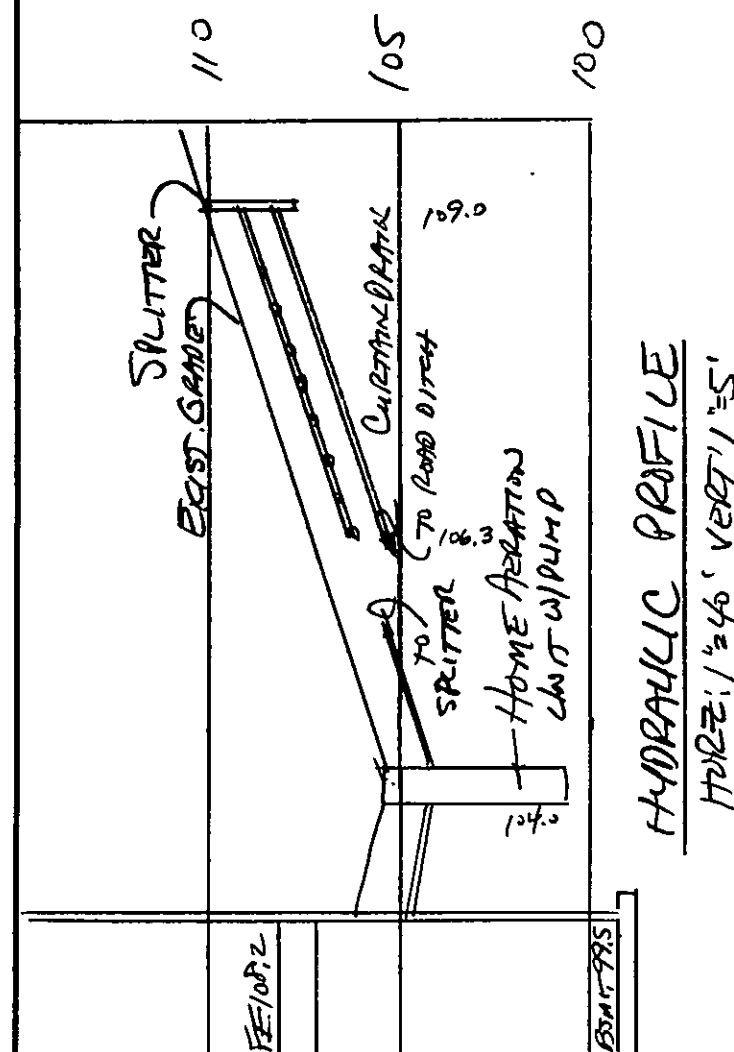

Grading Plan Approved
as shown and/or noted
JAMES R. GILLS, P.E.
Lake County Engineer

By TAM Date 6-11-01
12" MIN DRAIN CULVERT

ROOF DRAINS
SHALL DISCHARGE
TO SPLASH BLOCKS.

NOTE: TEMPORARY SEEDING REQUIRED
IN DISTURBED AREAS.

NOTE: MIN 54'S - 15' ± 20'
TOTAL - 35'

SITE PLAN

MADISON TOWNSHIP, LAKE COUNTY, OHIO

for: GUARDIAN HOMES

CLIENT	OWNER
ADDRESS	STREET CITY ZIP
SUBDIVISION	NAME TRACT
VOL.-PG.	LOT
SUBLOT NO.	STREET VOL.-PG.
	1A-18-45
	PERM. PARCEL NO.

LEGEND

SANITARY MANHOLE	---○---
STORM MANHOLE	---●---
INLET OR CATCH BASIN	---□---
HYDRANT	---◇---
EXISTING CONTOURS	---○---
PROPOSED CONTOURS	---○---
EXIST. ELEV. - 100.0	100.0 ± 2. PROP. ELEV.
AS BUILT ELEVATION	INDICATES DIRECTION OF SURFACE DRAINAGE

REMARKS

ALL BOUNDARY DATA SHOWN WAS OBTAINED FROM (DEEDS, RECORDED
SUBDIVISION PLAT OR OTHER PUBLIC RECORDS)

LOCATIONS AS SHOWN OF ADJACENT WELLS AND SEPTIC TANKS OBTAINED FROM
LAKE COUNTY HEALTH DEPARTMENT

DESIGN CERTIFICATION

THIS PLAT WAS PREPARED BY ME, AND IS CORRECT
TO THE BEST OF MY KNOWLEDGE AND BELIEF.

NAME Harry S. Jones, Jr. SURVEYOR REGISTRATION NO. 6343

CHECK LIST

NO. OF BEDROOMS	WATER MAIN SIZE, LOCATION
DIMENSIONS	SAN. SEWER SIZE & GR. LOC.
BEARINGS	SAN. MH. CAST. ELEV. INV. ELEV.
TIE TO NEAREST STREET	SAN. CONN. SIZE, LOC. DEPTH
SUBLOT NO., PARCEL NO.	STORM SEWER SIZE & GR. LOC.
SURROUNDING OWNERS	STORM MH. CAST. ELEV. INV. ELEV.
BLDG. DIMENSIONS FIN GR.	PAV'T TYPE GRADE CURBS
BLDG. TIES FL'R. GRADES	GAS LINE LOC. SIZE PRESSURE
APRON TYPE WIDTH THICKNESS	SEPTIC TANK LOCATION & DUPLICATION AREA
SIDEWALK TYPE WIDTH THICKNESS	WELL LOCATION
CULVERT TYPE DIA., LENGTH	ISOLATION RADIUS FROM WELL
ROCK OUTCROPPINGS	

REVISIONS			PLAN PREPARED BY:		
NO.	DATE	BY	BABCOCK JONES & ASSOCIATES, INC.		
1	6/30/01	HJ	PAINESVILLE, OHIO		
2					
3			DRAWN BY T.R.	SCALE 1" = 40'	PHONE NO. 440-357-1811
4			CHK'D. H.J.	DATE 5/25/01	DRAWING NO.
5			CREW CHIEF R.B.	APP'D H.J.	01-072

"AS BUILT" CERTIFICATION
I, HEREBY CERTIFY THAT THE CIRCLED GRADES ARE EXISTING
FINISH GRADES CHECKED IN THE FIELD ON 5/25/01, 2001
AND ARE CORRECT TO THE BEST OF MY KNOWLEDGE AND BELIEF.

REGISTERED SURVEYOR

REG. NO.

BM-IRON PIN FOUND
ELEV.=100.00

APPROVED
MADISON TOWNSHIP ZONING
DATE 6/5/01
BY DM 20526

"I, the undersigned hereby certify that
this topography indicated by 6", 1", or 2"
contours, and elevations shown hereon
represent an actual field survey made by
me on the 22nd day of May, 2001
and that the elevations were taken at
appropriate intervals and that as of that
date they existed as indicated hereon."

Name Harry S. Jones, Jr. Reg. No. 6343

