

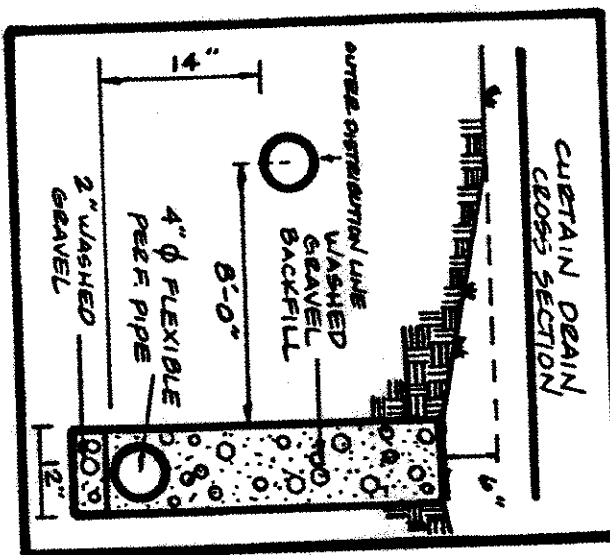


EVAPORATION - TRANSPIRATION  
TRENCH CROSS SECTION

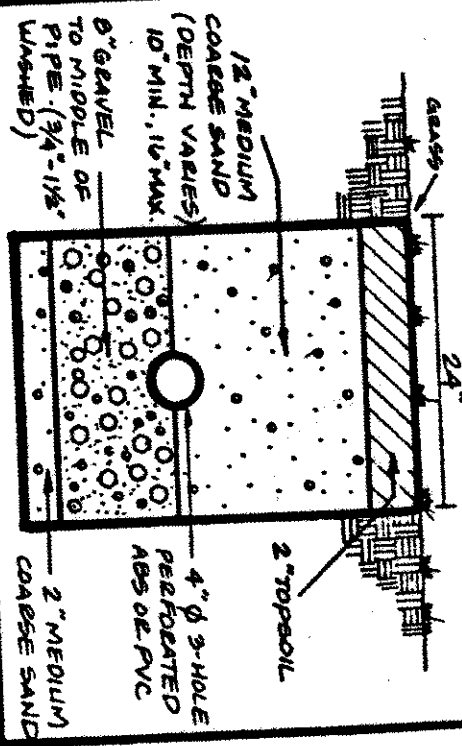


SUBSPACE DETAIL  
SAND FILTER DETAIL


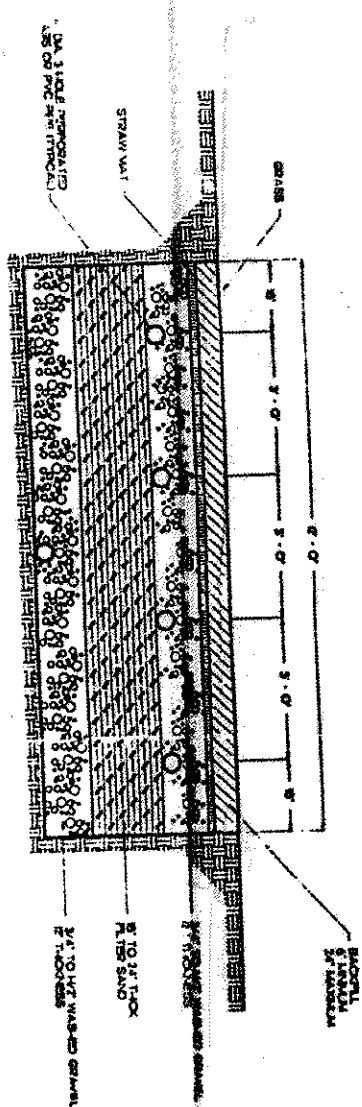


SEWAGE DISPOSAL PERMIT MUST BE OBTAINED BY A LAKE COUNTY LICENSED INSTALLER BEFORE INSTALLATION IS STARTED.

- A. To be brought to finished grade
- 1. Septic tank manhole covers
- 2. Splitter box cover
- 3. Distribution box cover
- B. No footer drains or downspouts to be discharged into septic tanks
- C. All waste water to be discharged into septic tanks

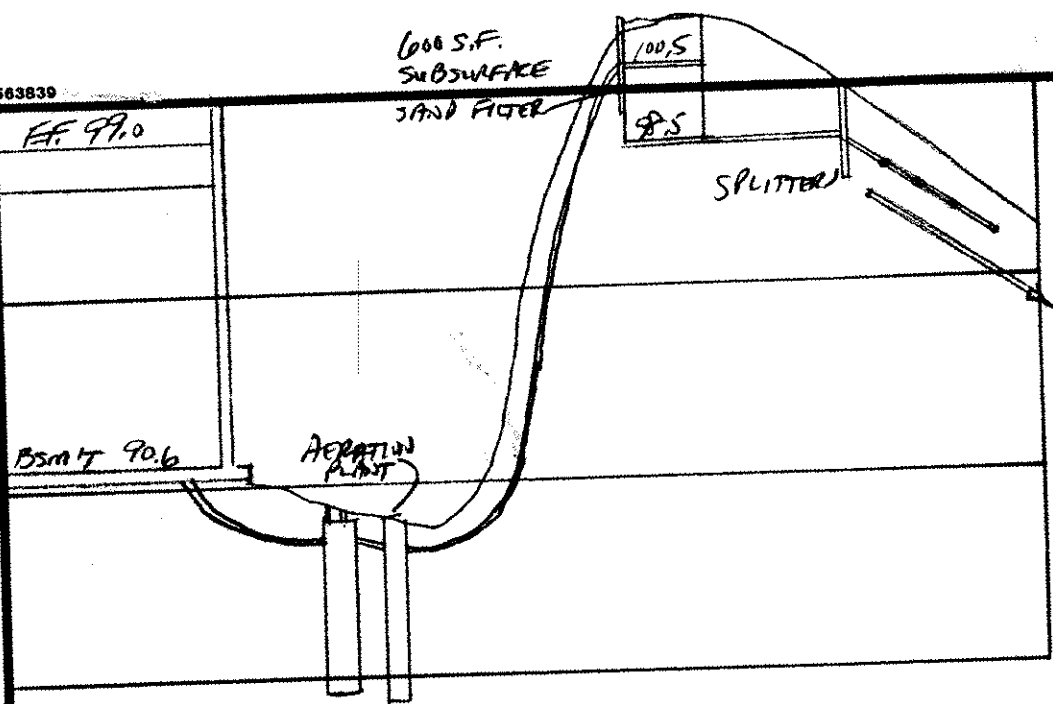

FIELD WATER FIXTURES REQUIRED ON ALL: Shower Head Toilet

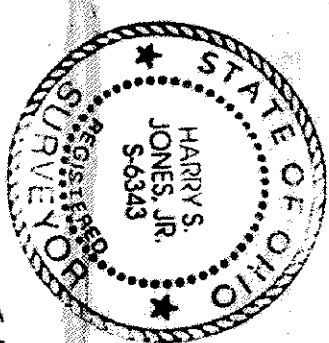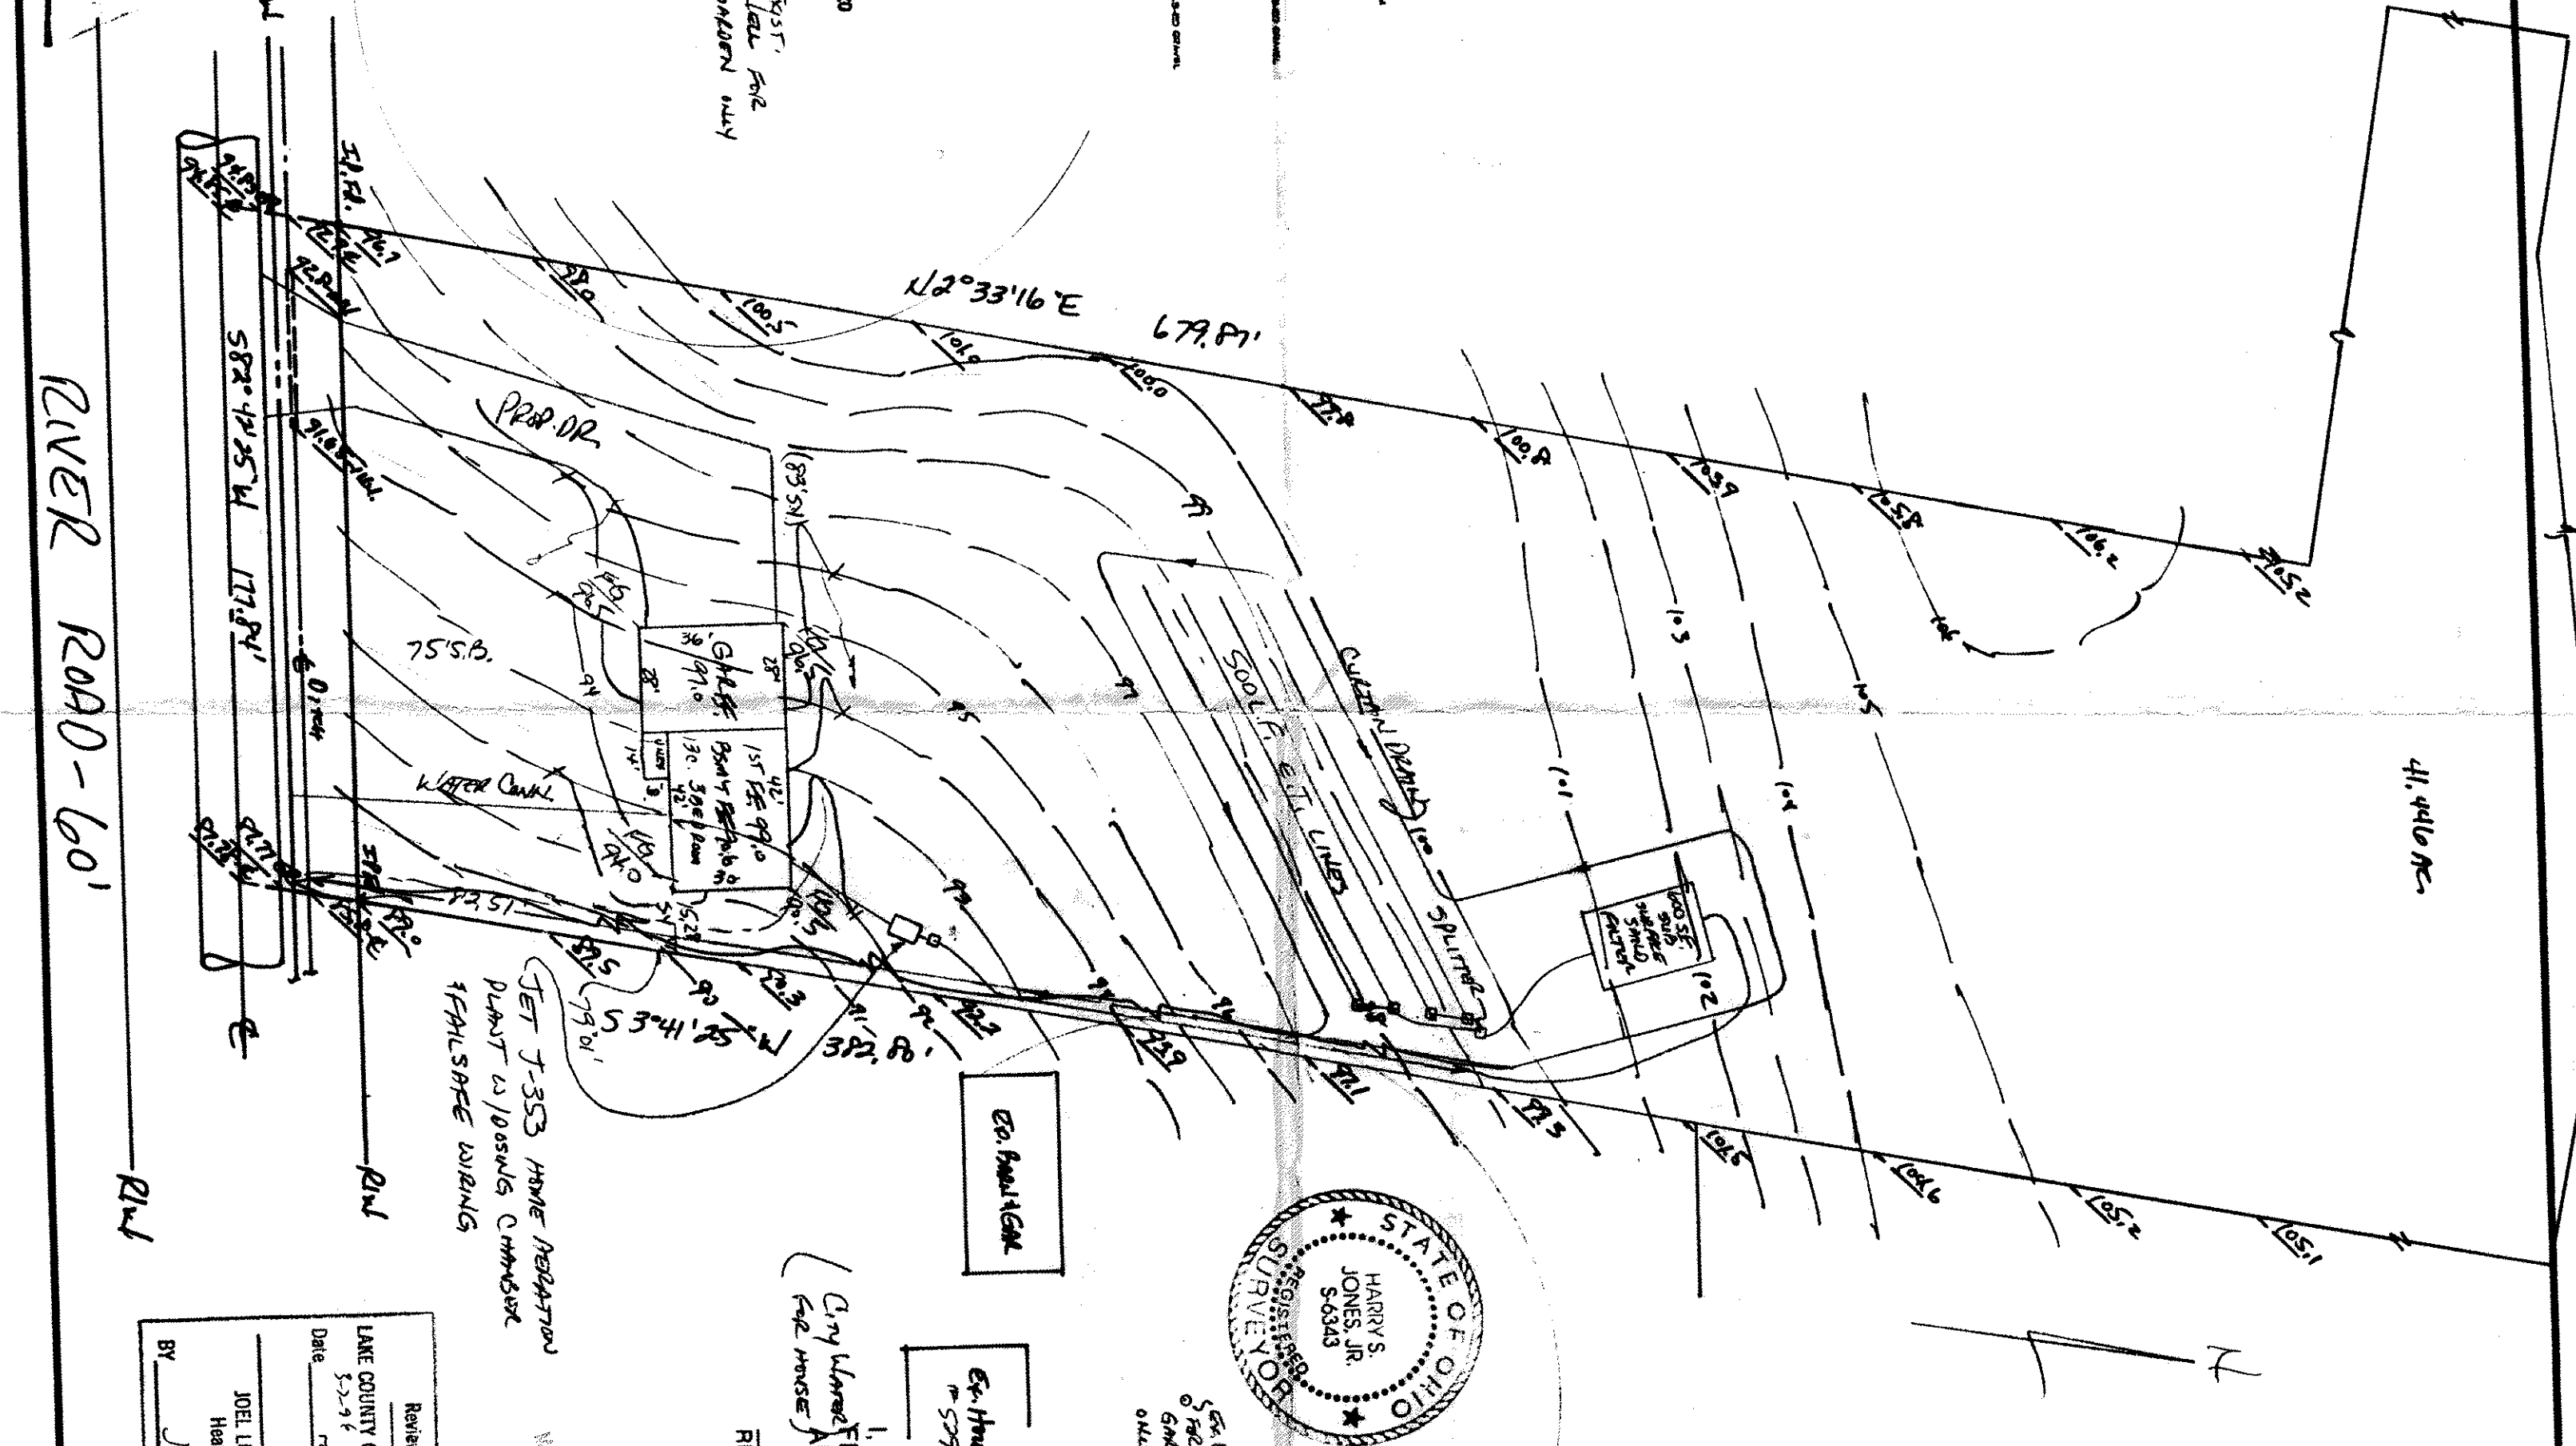

SITE PLAN

HAROLD TOWNSHIP, LAKE COUNTY, OHIO

for: PAUL PAGE

ADDRESS: STREET CITY: ZIP

SUBDIVISION	NAME	LOT	TRAC
VOL. - PG.		1027	1068
SUBLOT NO.	STREET	VOLUME - PG.	PAGE
		14-18-44	1062 P.2
		PERM. PARCEL NO.	STREET

LEGEND	
SANITARY MANHOLE	---○---
STORM MANHOLE	---●---
INLET OR CATCH BASIN	---□---
HYDRANT	---X---
EXISTING CONTOURS	---(---)
PROPOSED CONTOURS	---(---)
EXIST. ELEV.	100.0
PROP. ELEV.	100.0

REMARKS

ALL BOUNDARY DATA SHOWN WAS OBTAINED FROM (DEEDS, RECORDED SUBDIVISION PLAT OR OTHER PUBLIC RECORDS)  
LOCATIONS AS SHOWN OF ADJACENT WELLS AND SEPTIC TANKS OBTAINED FROM LAKE COUNTY HEALTH DEPARTMENT

DESIGN CERTIFICATION

THIS PLAT WAS PREPARED BY ME, AND IS CORRECT TO THE BEST OF MY KNOWLEDGE AND BELIEF.

NAME: Paul Page SURVEYOR REGISTRATION NO. 6343

CHECK LIST

NO. OF BEDROOMS	WATER MAIN SIZE, LOCATION
DIMENSIONS	SAW. SEWER SIZE, % GR. LOC.
BEARINGS	SAW. IN. CAST. ELEV. INV. ELEV.
TIE TO NEAREST STREET	SAW. CORR. SIZE, LOC. DEPTH
SUBLOT NO. PARCEL NO.	STORM SEWER SIZE, % GR. LOC.
SURROUNDING OWNERS	PAV'T TYPE GRADE CURBS
BLDG. DIMENSIONS FIN. GR.	BLDG. TIES P.L.R. GRADERS
APPROX. TYPE WIDTH THICKNESS	APPROX. TYPE WIDTH THICKNESS
SEPTIC TANK LOCATION & DUPPLICATION AREA	SEPTIC TANK LOCATION & DUPPLICATION AREA
WELL LOCATION	WELL LOCATION
ISOLATION RADIUS FROM WELL	ISOLATION RADIUS FROM WELL
ROCK OUTCROPPING	ROCK OUTCROPPING

PLAN PREPARED BY: BABCOCK & JONES & ASSOCIATES, INC.

PAINEVILLE, OHIO

NO.	DATE	BY	SCALE	DATE	PHONE NO.
1	9/27/95	HT	1" = 40'	9/14/95	357-1811
2	9/29/96	HT			
3					
4					
5					

"AS BUILT" CERTIFICATION

I, HEREBY CERTIFY THAT THE CIRCLED GRADES ARE EXISTING FINISH GRADES CHECKED IN THE FIELD ON 1995.  
(City Water Fire House) AND ARE CORRECT TO THE BEST OF MY KNOWLEDGE AND BELIEF.

REGISTERED SURVEYOR REG. NO. 5791

TBM - TSEH - ELEV. = 100.00

APPROVED  
MAR - 4 1996  
LAKE COUNTY HEALTH DISTRICT

Reviewed and Accepted  
JOEL LUDIA, R.S., M.P.H.  
Health Commissioner

"I, the undersigned hereby certify that the topography indicated by 6', 1' or 2' contours, and elevations shown hereon represent an actual field survey made by me on the 13<sup>th</sup> day of SEPT., 1995 and that the elevations were taken at appropriate intervals and that as of that date they existed as indicated hereon."  
Paul Page, #6343  
Professional Engineer

BY: J. C. L. L.

6343 3.14.96