

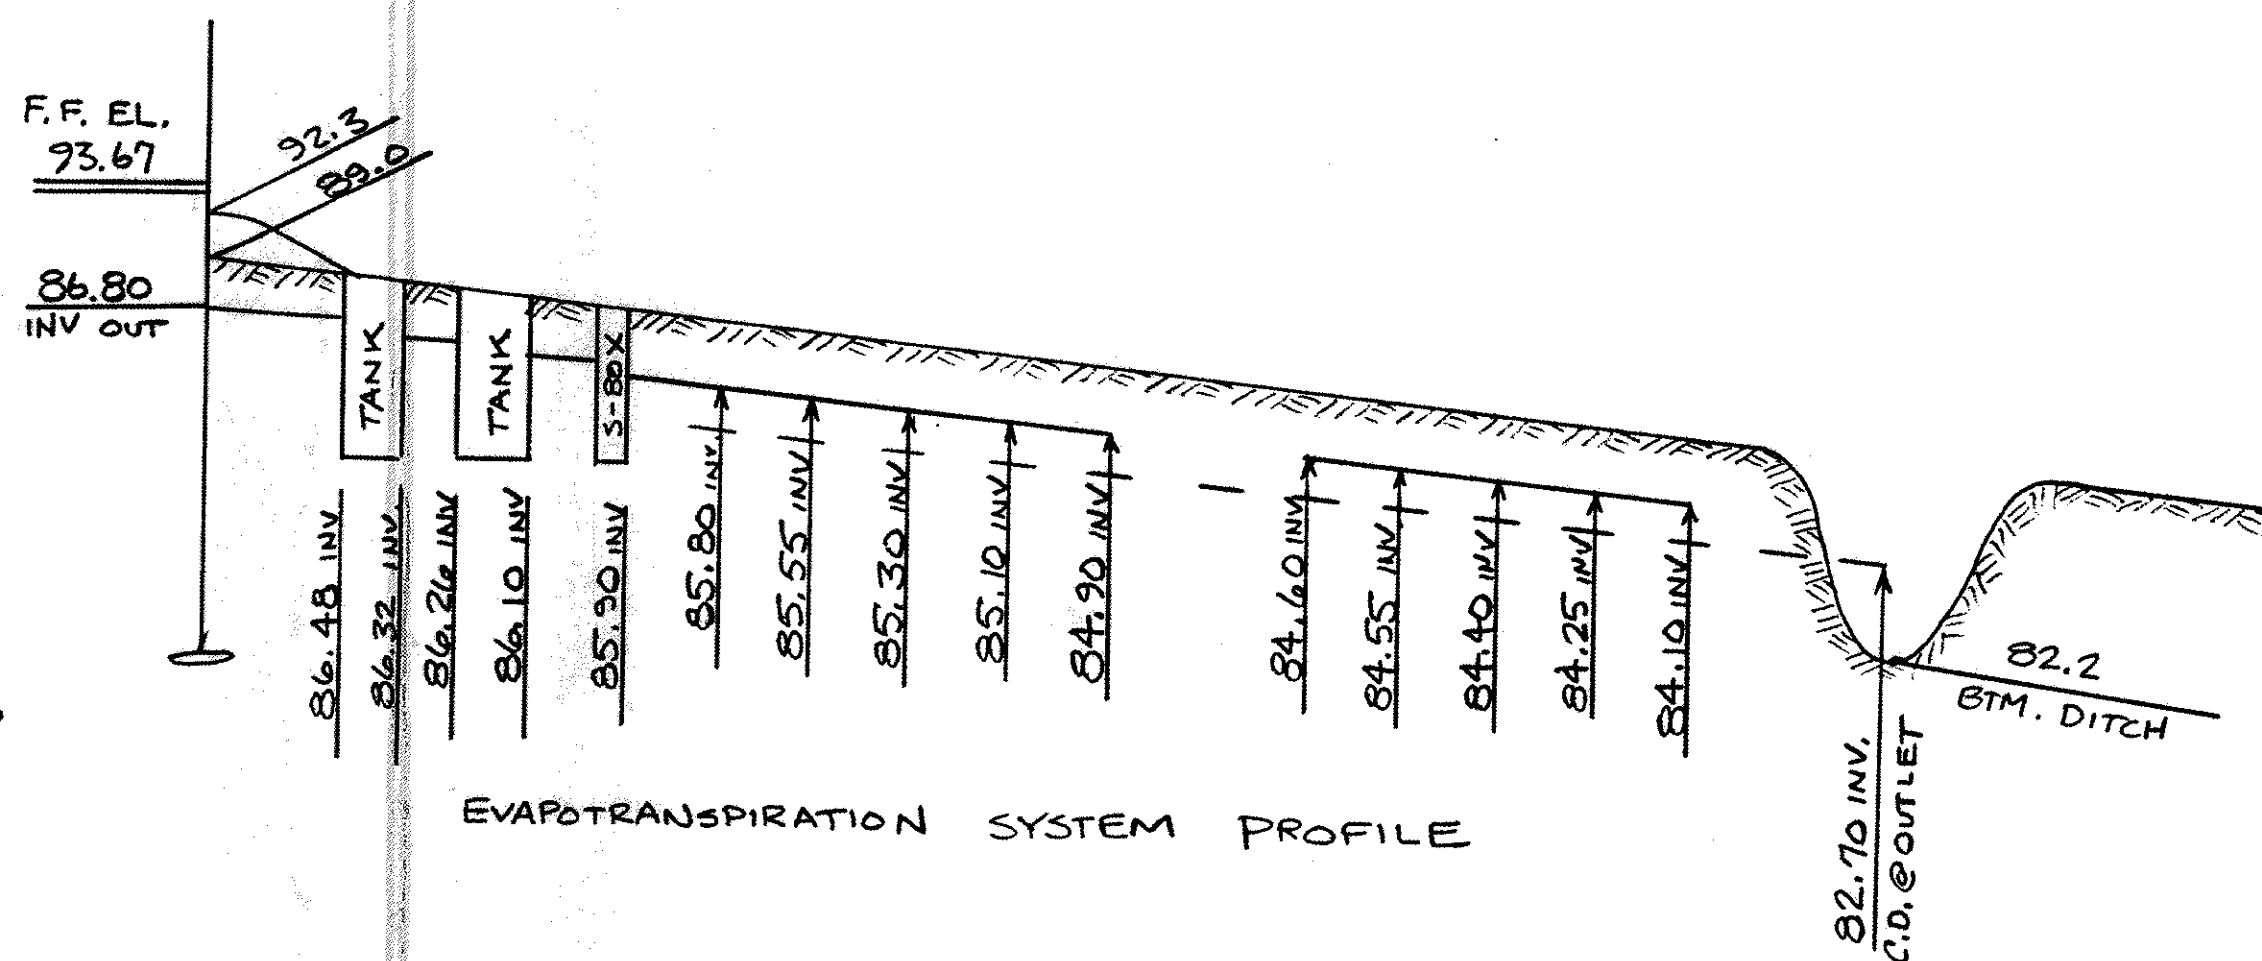


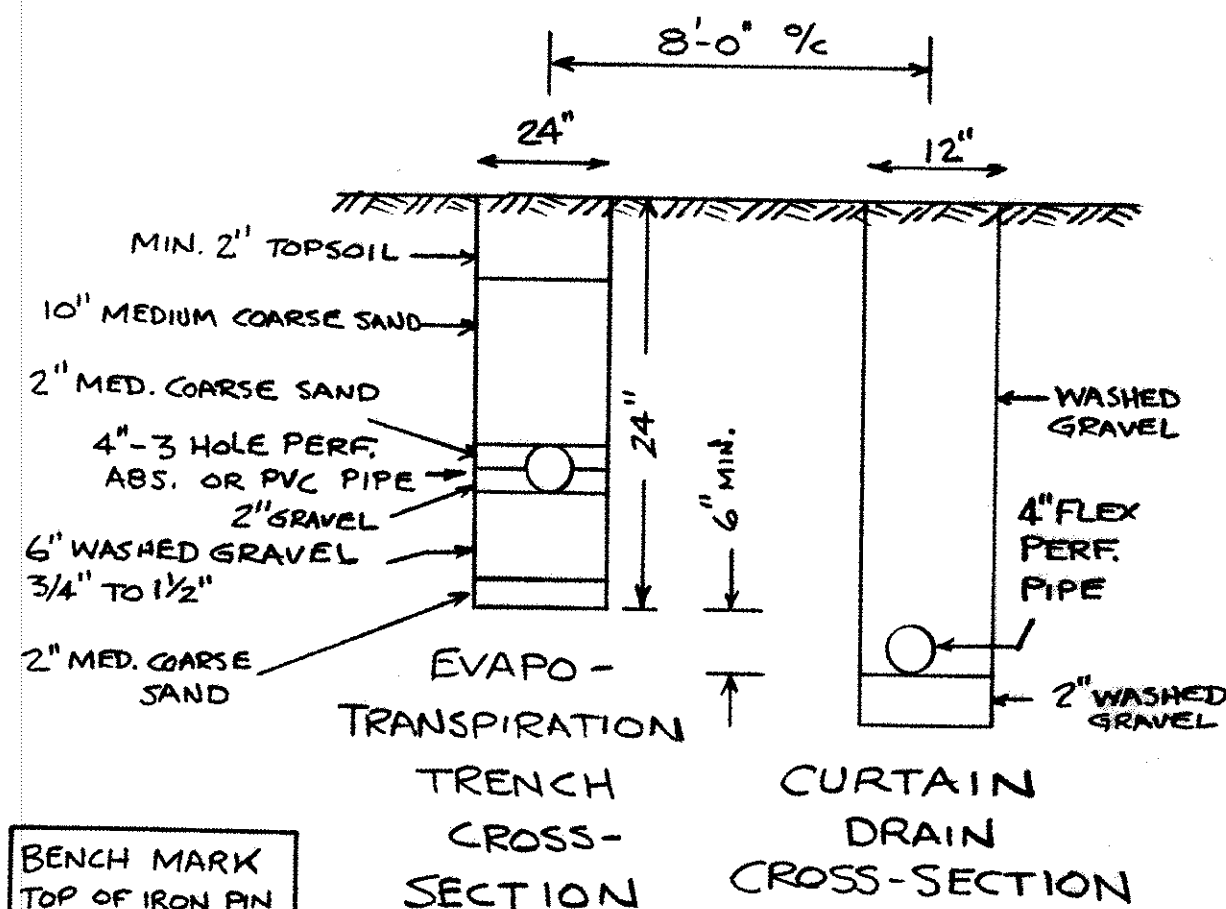

REVIEWED AND ACCEPTED
LAKE COUNTY GENERAL
HEALTH DISTRICT

Date 6/23/97 *Thomas P. Gilles*
Keep trenches shallow 18" Deep
System must be placed in strict accordance
with plans
SEWAGE DISPOSAL PERMIT MUST BE
OBTAINED BY A LAKE COUNTY LICENSED
INSTALLER BEFORE INSTALLATION IS
STARTED.

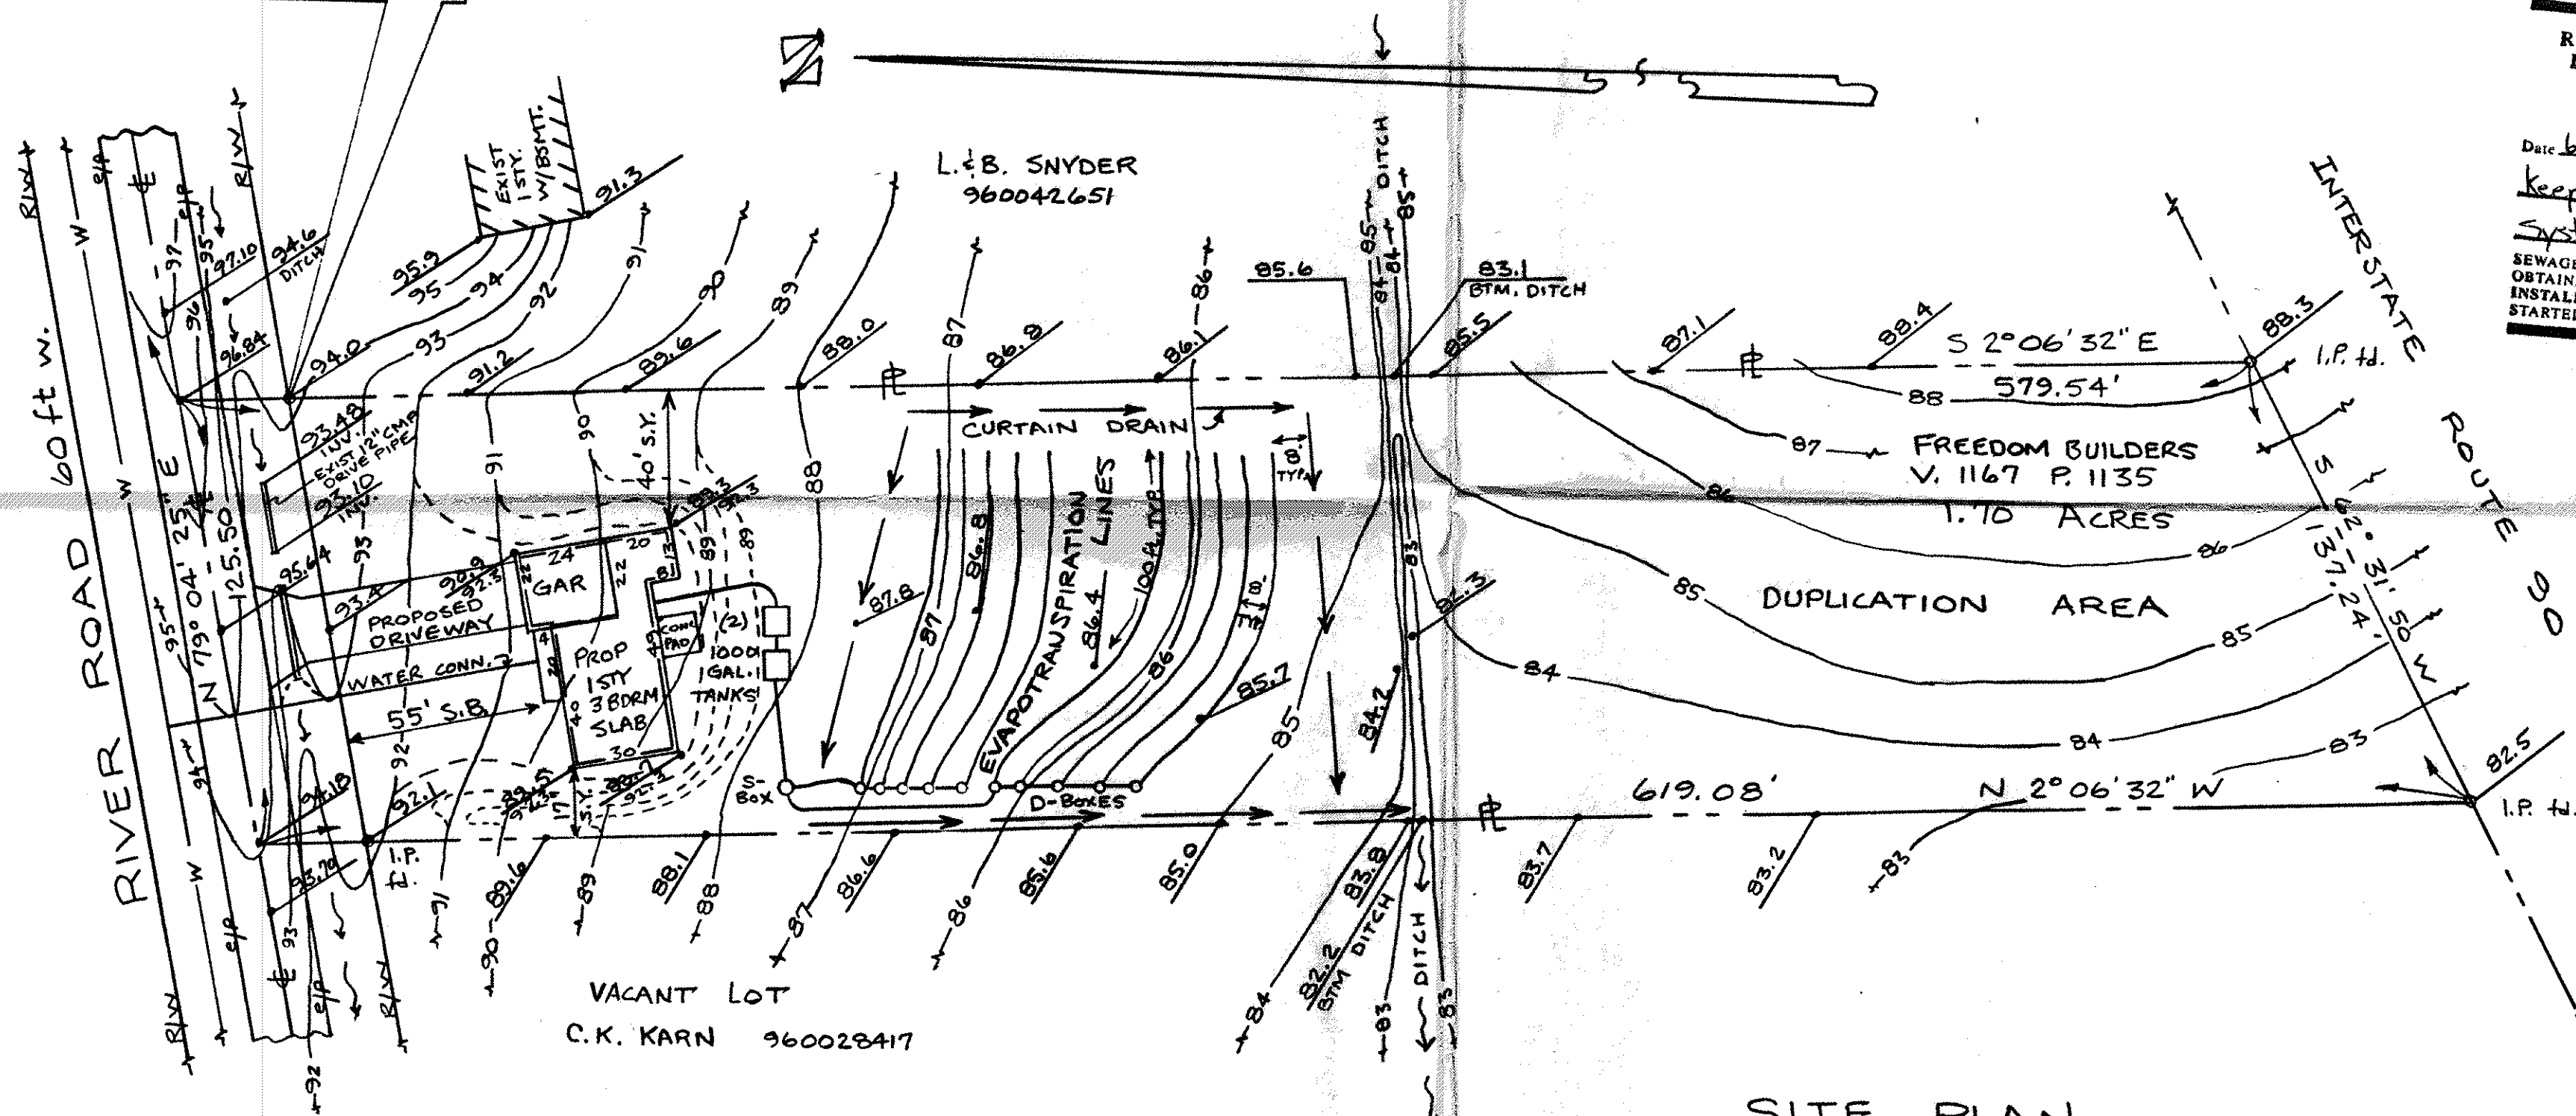

NOTE:

PROPOSED DWELLING 1 STY. FRAME ON SLAB
FINISH FLOOR ELEVATION HOUSE 93.67 ft.
FINISH FLOOR ELEVATION GARAGE 93.00 ft.

JIM PETER LAND SURVEY
4759 CROSBY - COOK RD.
ROME, OHIO 44085
216-294-2187

SITE PLAN
FOR



FREEDOM BUILDERS INC.

BEING A PART OF TRACT S OF MADISON TOWNSHIP
LAKE COUNTY, OHIO

SCALE 1" = 40 ft
28 MAY 1997

Grading Plan Approved
as shown and/or noted
THOMAS P. GILLES, P.E.
Lake County Engineer

By 6/11/97 Date 7-7-97

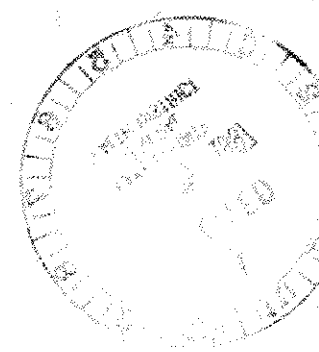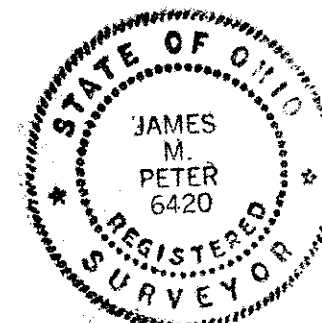

DWG No 970506

I, JIM PETER, LAND SURVEYOR, HEREBY CERTIFY THAT
THE SURVEY SHOWN HEREON, REPRESENTED
THE ACTUAL FIELD TOPOGRAPHIC
CONTOURS AND ELEVATIONS,
BY ME ON THE 12th day of MAY,
1997, AT AS OF THAT DATE THE TOPO
GRAPHY SHOWN HEREON.

APPROVED
MADISON TOWNSHIP ZONING
JUL 2 1997
ZONING INSPECTOR