
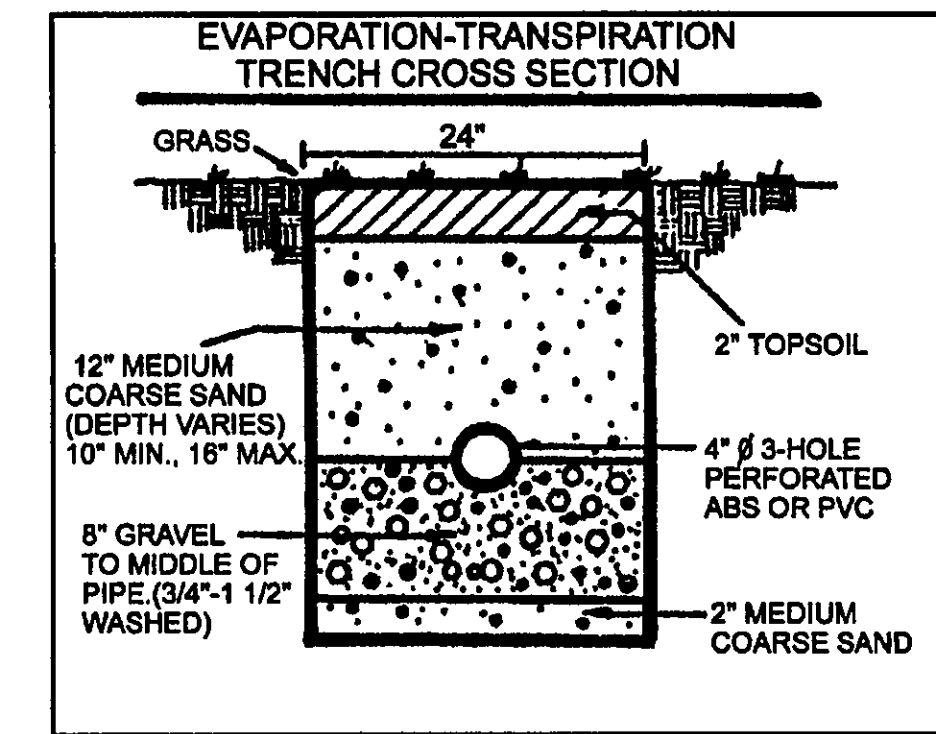


25002 M  
10/28/16  
DATE  
MADISON TOWNSHIP  
APPROVED



SHEET 1 OF 1

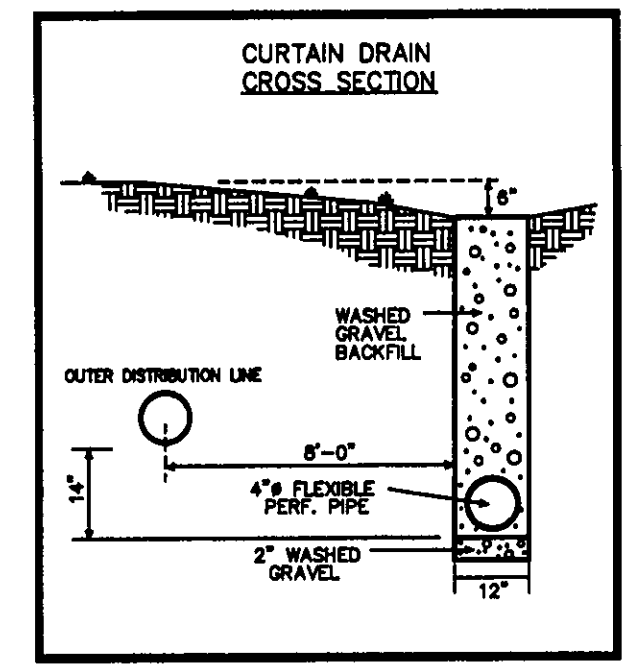

REVIEWED AND ACCEPTED  
LAKE COUNTY GENERAL  
HEALTH DISTRICT

Date: 4/20/01 BY: *David B. Norris RS.*

SEWAGE DISPOSAL PERMIT MUST BE  
OBTAINED BY A LAKE COUNTY LICENSED  
INSTALLER BEFORE INSTALLATION IS  
STARTED

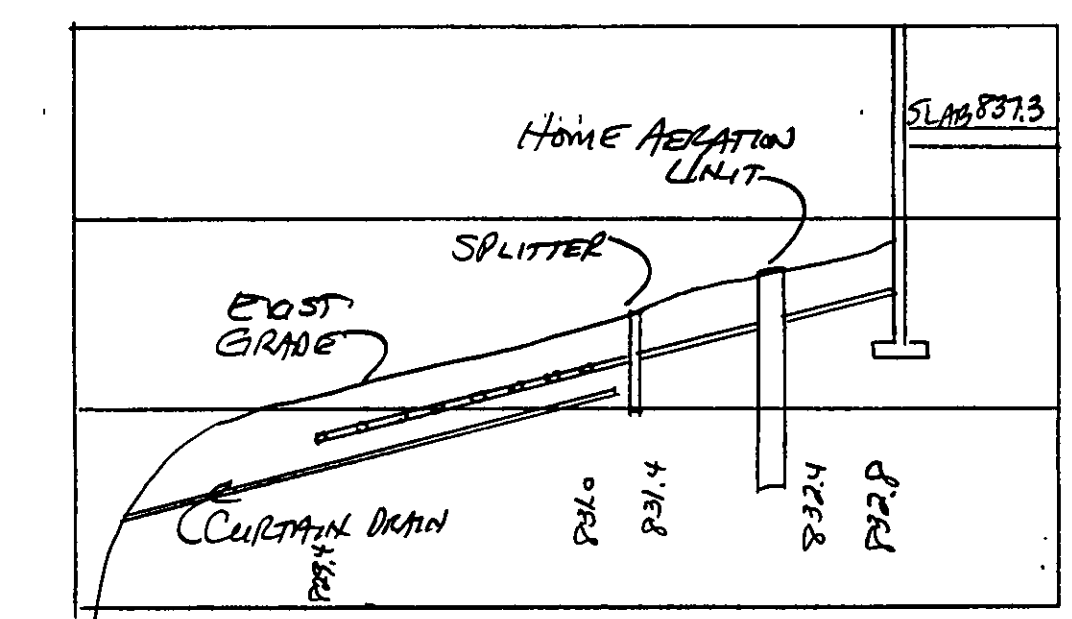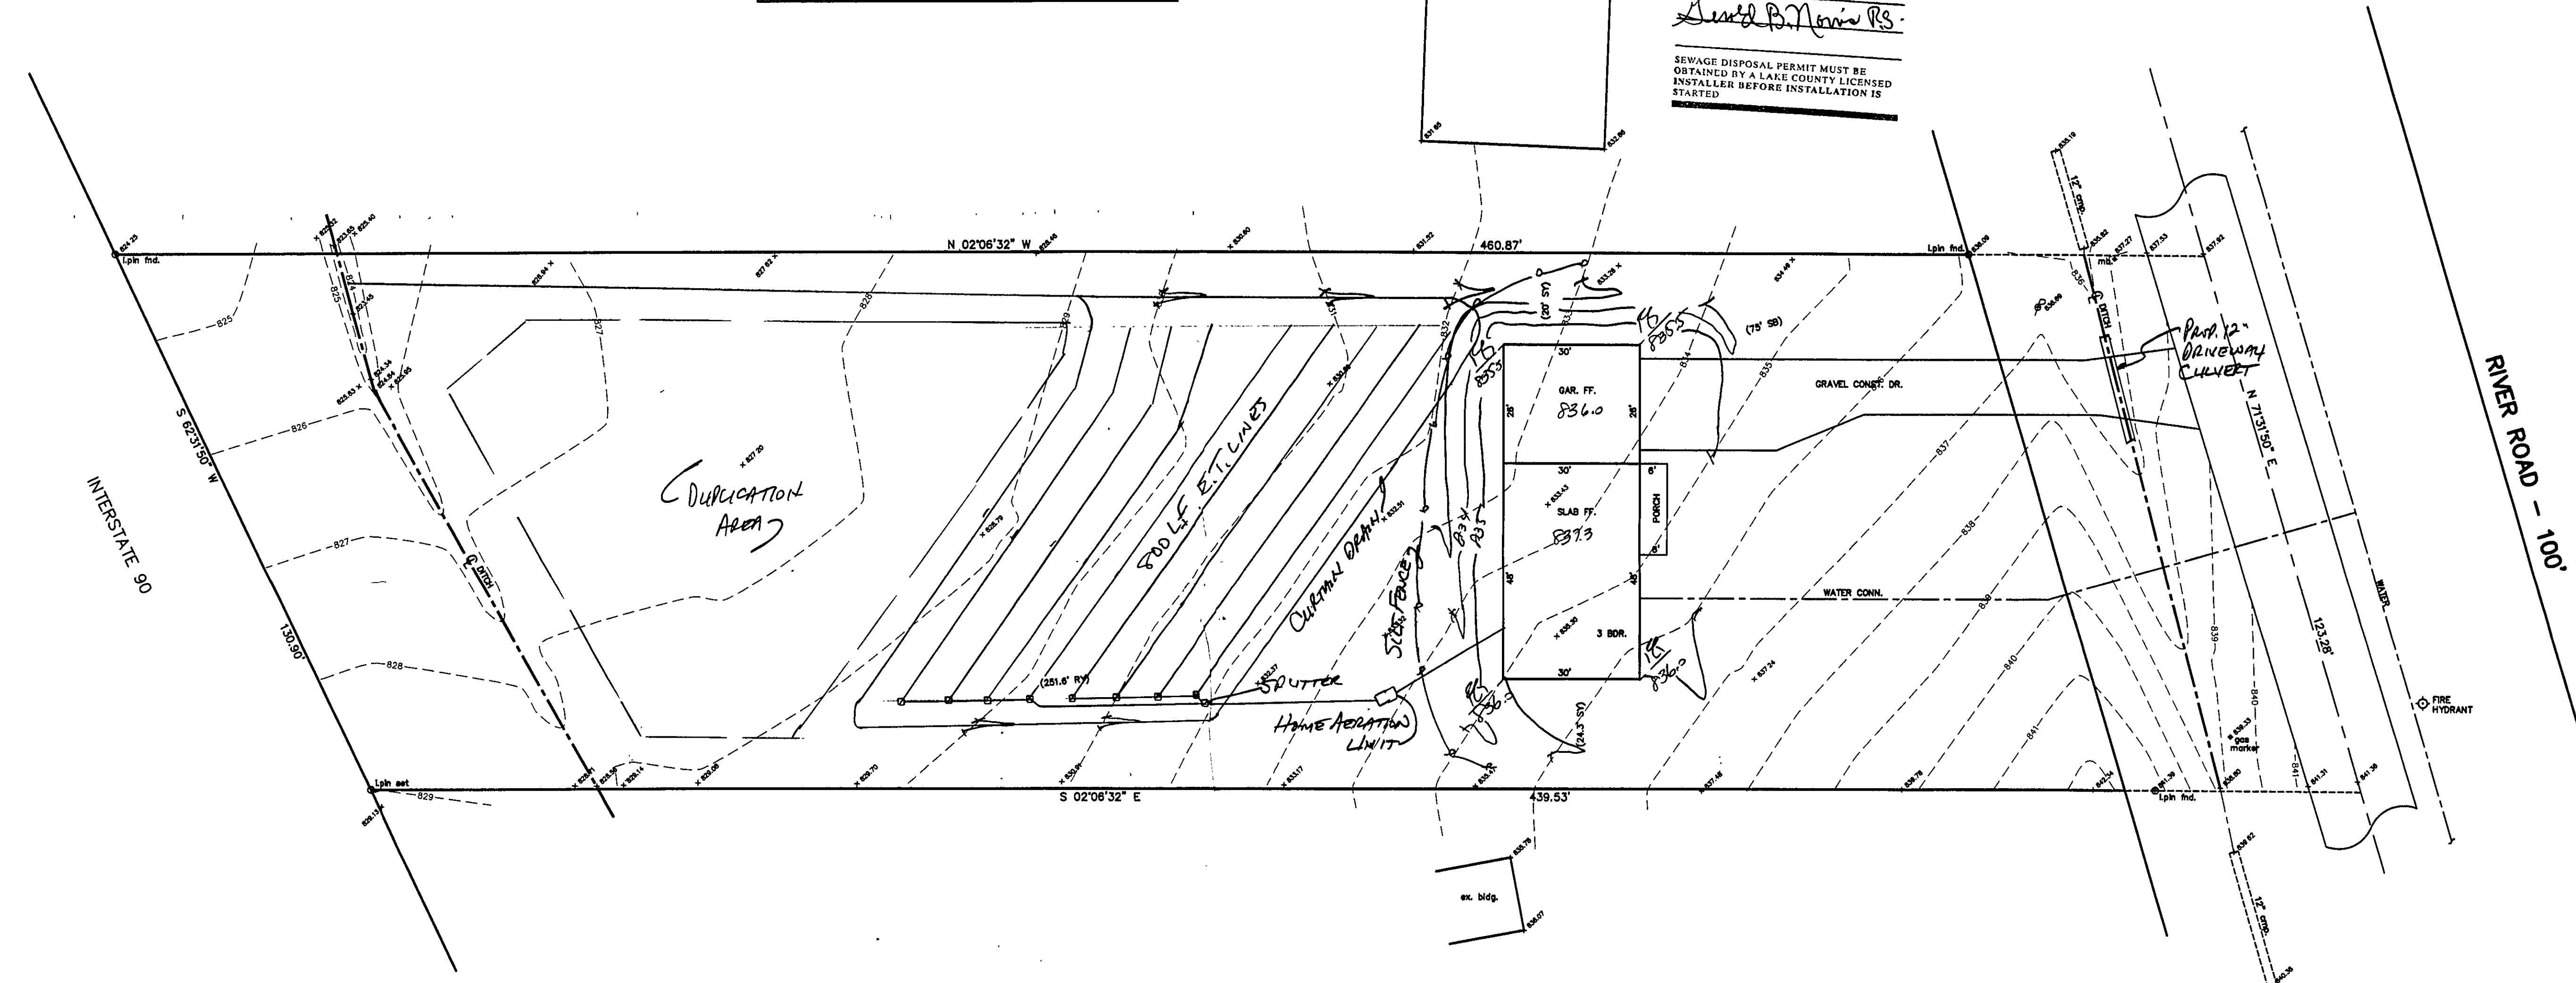


HYDRAULIC PROFILE  
HORIZ: 1"=20' VERT: 1"=5'

Grading Plan Approved  
as shown and/or noted  
JAMES R. GILLS, P.E.  
Lake County Engineer

By: *James R. Gills* 4/26/01  
SHALL DISCHARGE  
TO SPLASH BLOCKS.

"I, the undersigned hereby certify that  
this topography indicated by 6", 1', or 2'  
contours, and elevations shown hereon  
represent an actual field survey made by  
me on the 10th day of Feb., 2000  
and that the elevations were taken at  
appropriate intervals and that as of that  
date they existed as indicated hereon."

Name: *Harry S. Jones* #6343  
Reg. No.

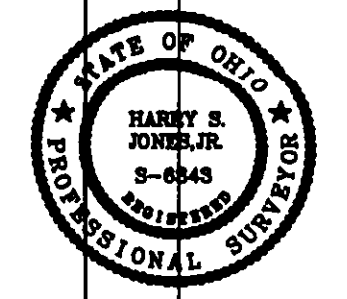

REV NO.	DESCRIPTION	DATE	BY	CHK'D

**bj** BABCOCK, JONES AND ASSOCIATES, INC  
CIVIL ENGINEERS - SURVEYORS - LAND PLANNERS  
PAINESVILLE OHIO 44077

DATE: 2/27/00  
DESIGN BY: H.J.  
DRAWN BY: T.R.  
APPROVED BY: H.J.

SITE PLAN  
FOR  
SHANNON CONSTRUCTION  
5600 River Rd  
MADISON TOWNSHIP LAKE COUNTY

SCALE: 1"=20'  
JOB NO: 00-024  
SHEET 1 OF 1