
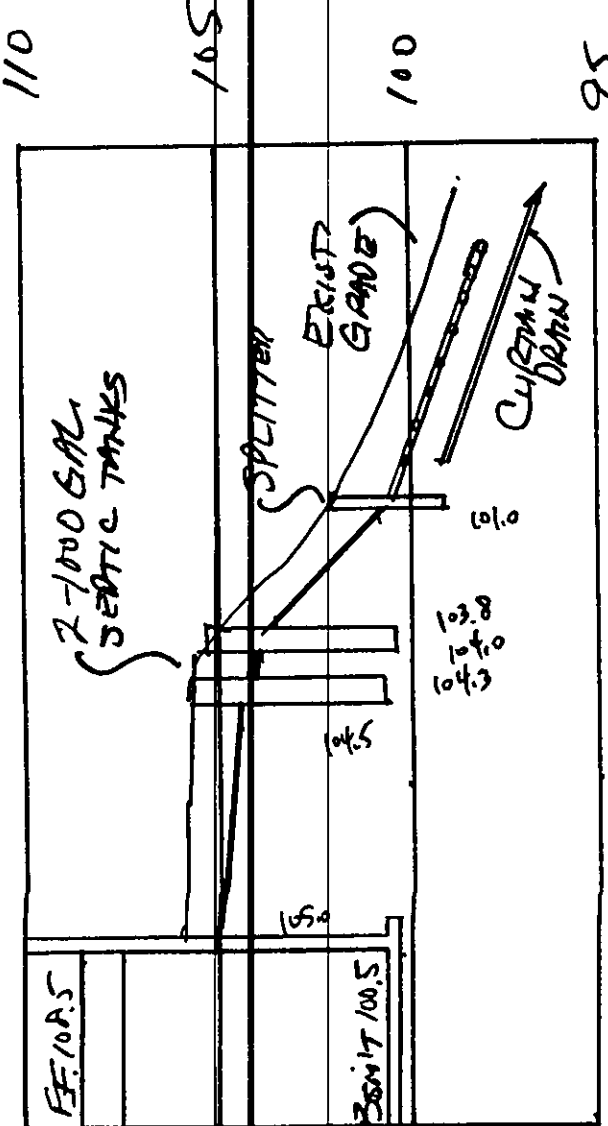
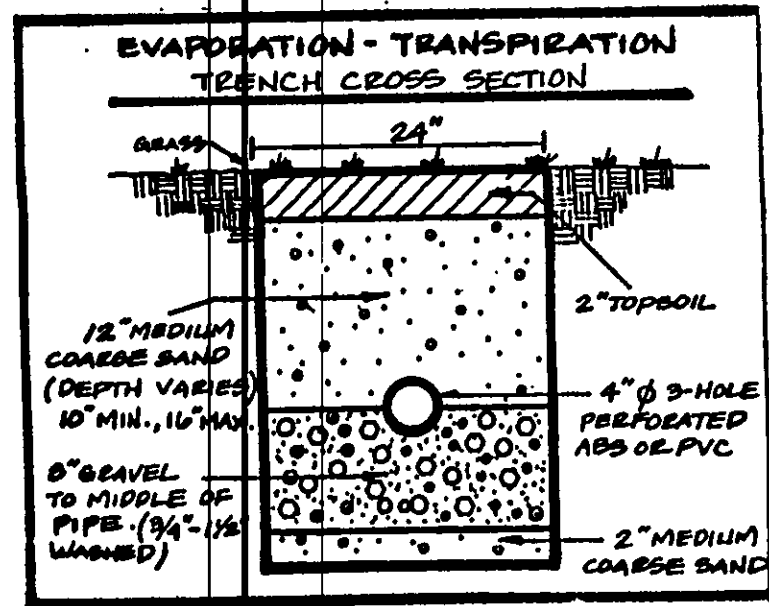


APPROVED
MADISON TOWNSHIP ZONING
DATE 8/3/98
BY SJS

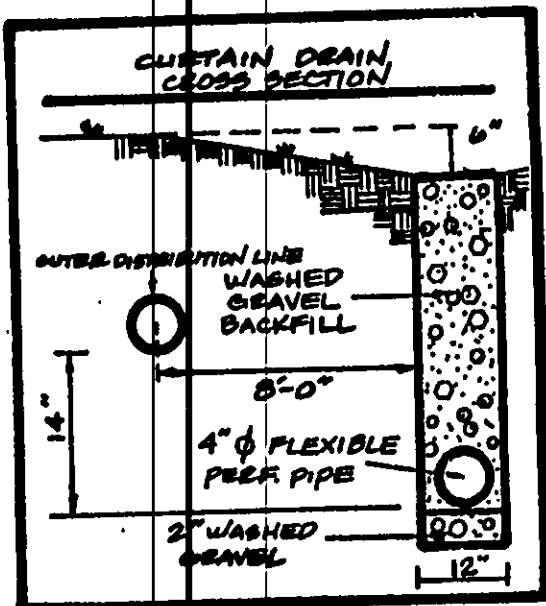


REVIEWED AND ACCEPTED
LAKE COUNTY GENERAL
HEALTH DISTRICT
Date 7/1/98 By *David L. Jones* S/L 5
1A-29A-5

SEWER DISPOSAL PERMIT MUST BE
OBTAINED FROM LAKE COUNTY HEALTH DISTRICT
BEFORE INSTALLATION

S/L 6
1A-29A-6
1.585 AC. ORIGINAL
0.154 AC. SPLIT
1.431 AC. TOTAL

S/L 7
1A-29A-7
1.489 AC. ORIGINAL
0.154 AC. SPLIT
1.643 AC. TOTAL

S/L 8
1A-29A-8

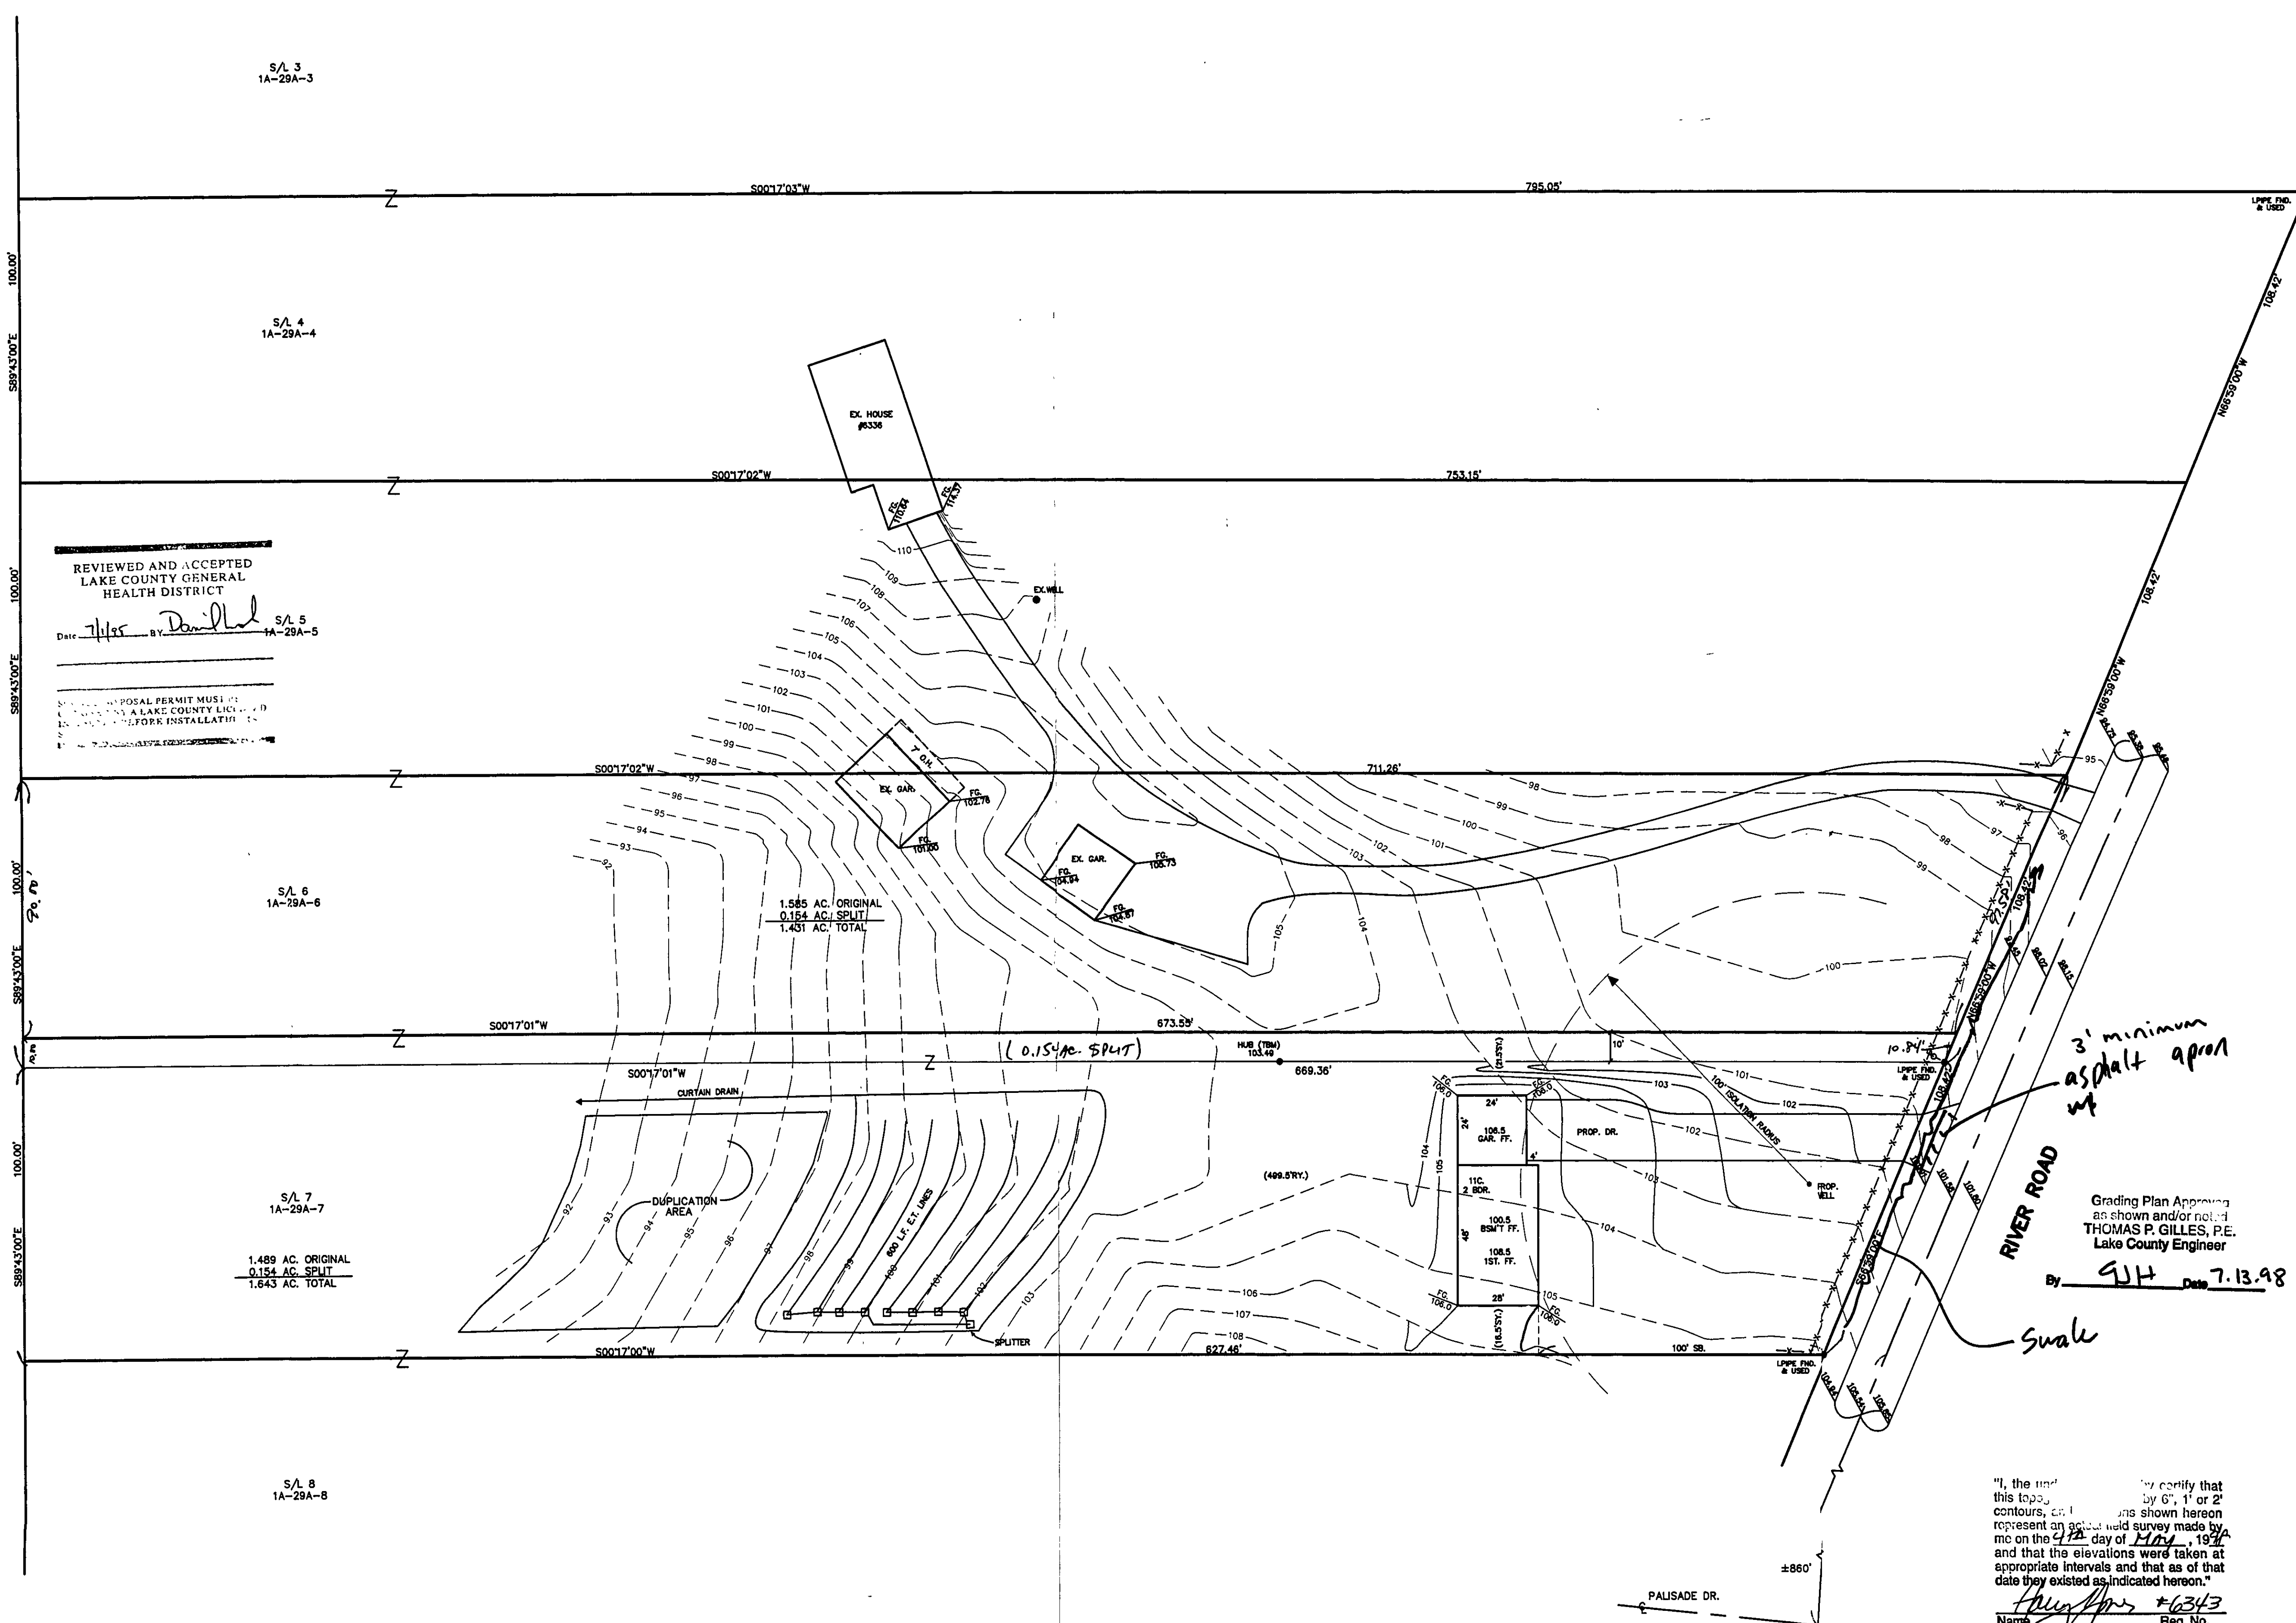


3' minimum
asphalt apron
w/

RIVER ROAD

Snake

Grading Plan Approved
as shown and/or noted
THOMAS P. GILLES, P.E.
Lake County Engineer
By *GJH* Date 7.13.98

"I, the undersigned, do hereby certify that this topographic map, as shown hereon, represents an actual field survey made by me on the 12th day of May, 1998, and that the elevations were taken at appropriate intervals and that as of that date they existed as indicated hereon."
Name *Harry S. Jones, Jr.* #6343
Reg. No.

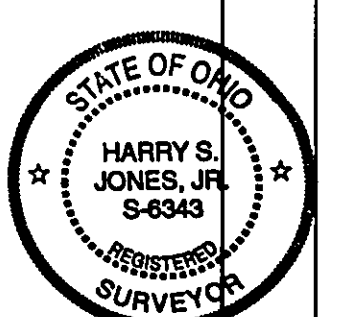

REV NO.	DESCRIPTION	DATE	BY	CHK'D
1	ADDED HOUSE AND SEPTIC	5/19/98	H.J.	H.J.
2	ADDED 10' SPLIT	6/26/98	T.R.	H.J.

bj BABCOCK, JONES AND ASSOCIATES, INC
CIVIL ENGINEERS - SURVEYORS - LAND PLANNERS
PAINESVILLE OHIO 44077

DATE 5/6/98
DESIGN BY H.J.
DRAWN BY T.R.
APPROVED BY H.J.

SITE PLAN
FOR
MARILYN THOMPSON
MADISON TWP. LAKE COUNTY OHIO

SCALE 1"=30'
JOB NO 98-104
SHEET 1 OF 1