


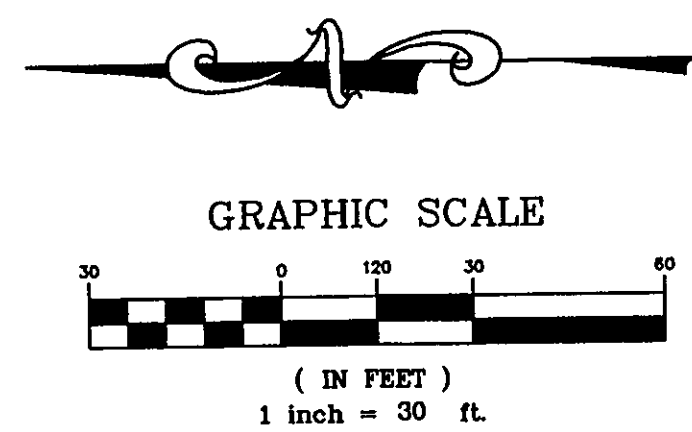

TIMOTHY & PAMELA KORYCKI
P.P.# 10-41-019
VOL. 212 PG. 170
(5-8-86)

(3.308 AC.)
DAVID & DEBRA KISSIG
P.P.# 10-41-038
DOC. # 110043608
(11-28-87)

ROBERT & ROBIN BAIRD
P.P.# 10-41-033
VOL. 630 PG. 113
(7-1-81)

REVIEWED AND ACCEPTED
LAKE COUNTY GENERAL
HEALTH DISTRICT

Date: 1-8-98 BY: *Daniel*
keep trenches at 18"

SEWAGE DISPOSAL PERMIT MUST BE
OBTAINED BY A LAKE COUNTY LICENSED
INSTALLER BEFORE INSTALLATION IS
STARTED

Grading Plan Approved
as shown and/or noted
THOMAS P. GILLES, P.E.
Lake County Engineer

By: *GLH* Date: 1-28-98

APPROVED
MADISON TOWNSHIP ZONING
DATE: 1/14/98
BY: *ML* 156-39

PRINTED
JAN 05 1998
LAKE INC.

LAKE, Inc.
ENGINEERS & SURVEYORS
30601 EUGLID AVENUE WICKLIFFE, OHIO 44092
PHONE: (216) 585-2100 FAX: (216) 585-5122

Rev. No.	Description	Date	By	CHK'D

P.P.# 104138
MR. & MRS. DAVID KISSIG
MADISON TOWNSHIP, LAKE COUNTY

Drawn By: D.Abbott
Filename: 97-131\97-131
Checked By:
Approved By:
Date: DECEMBER 31, 1997

SITE PLAN

Scale:	
1" = 30'	
1" = ?	
Sheet No.	Of
1	2