

SEWAGE SYSTEM MUST BE INSPECTED BY HEALTH DEPARTMENT BEFORE COVERING.

LOW FLOW WATER FIXTURES REQUIRED ON ALL:
Shower Head
Toilet


Reviewed and Accepted	JOE LUTKA, R.S., M.E., M.
LAKE COUNTY GENERAL HEALTH DISTRICT	Health Commissioner
Date	1-11-91

- A. To be brought to finished grade
1. Septic tank manhole covers
2. Sifter box cover
3. Distribution box cover
B. No footer drains or downspouts to be discharged into septic tanks
C. All waste water to be discharged into septic tanks

51.57 E
1200.0'

Name Harry S. Jones, Jr.
#6343
Reg. No.


"I, the undersigned hereby certify that the topography indicated by 6", 1" or 2" contour lines and elevations shown hereon represent an actual field survey made by me on the 19th day of January, 1991, and that the elevations were taken at appropriate intervals and that as of that date they existed as indicated hereon."

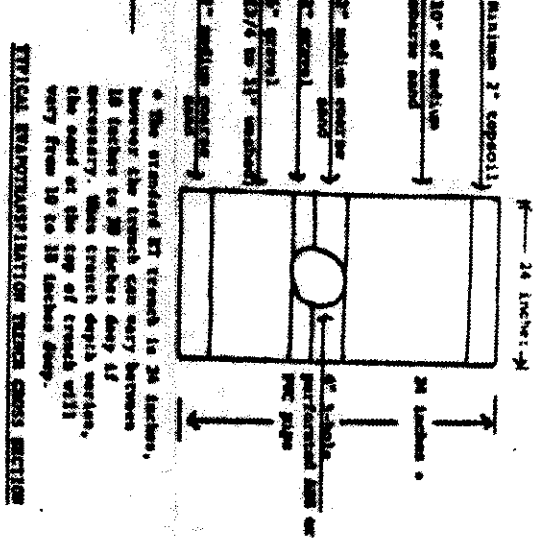

1. The finished ground is shown by a solid line.
2. The existing ground is shown by a dashed line.
3. The proposed ground is shown by a dotted line.
4. The existing structures are shown by a solid line.
5. The proposed structures are shown by a dashed line.
6. The existing utilities are shown by a solid line.
7. The proposed utilities are shown by a dashed line.
8. The existing easements are shown by a solid line.
9. The proposed easements are shown by a dashed line.
10. The existing setbacks are shown by a solid line.
11. The proposed setbacks are shown by a dashed line.


Grading Plan Approved
as shown and/or noted
by J.G.H. County Engineer
Date 1/28/91

APPROVED
MADISON TWP. ZONING
PERMIT 18936
Zoning Inspector: OK
JAN 29 1991

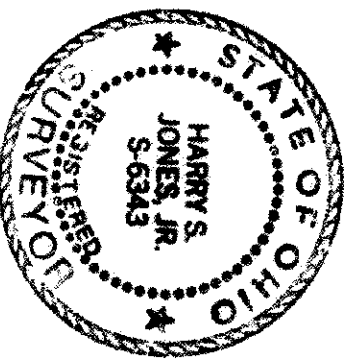


ENTER STREET
(OK 508)


HYDRAULIC PROFILE
SCALE HORIZ. - 1" = 50' VERT. - 1" = 5'

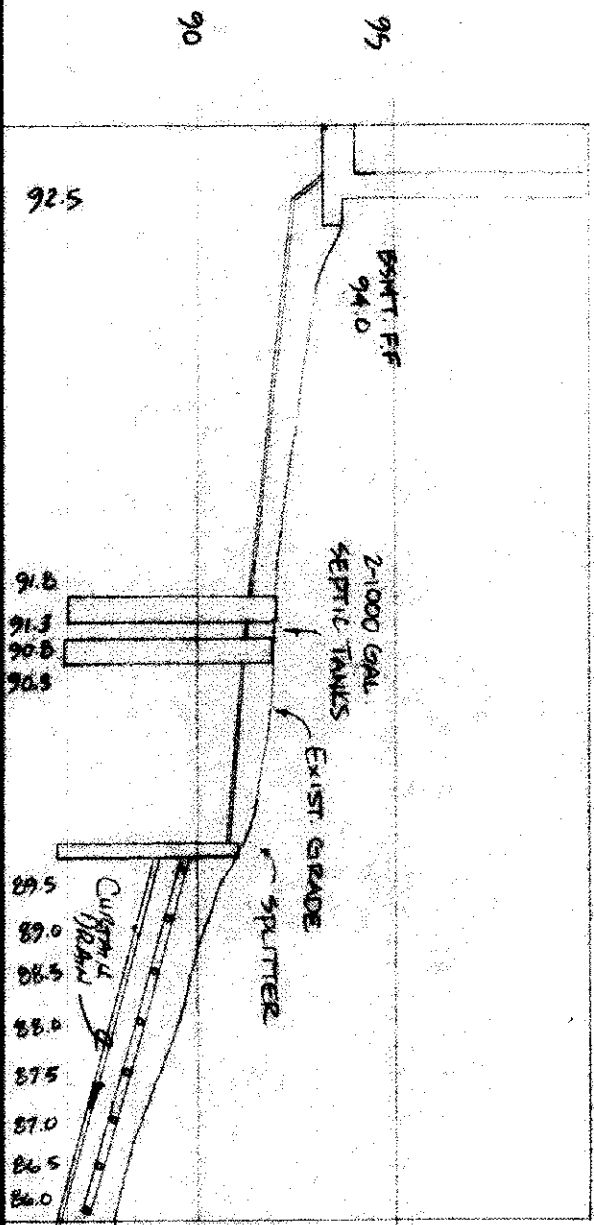

RIVER ROAD - 60'

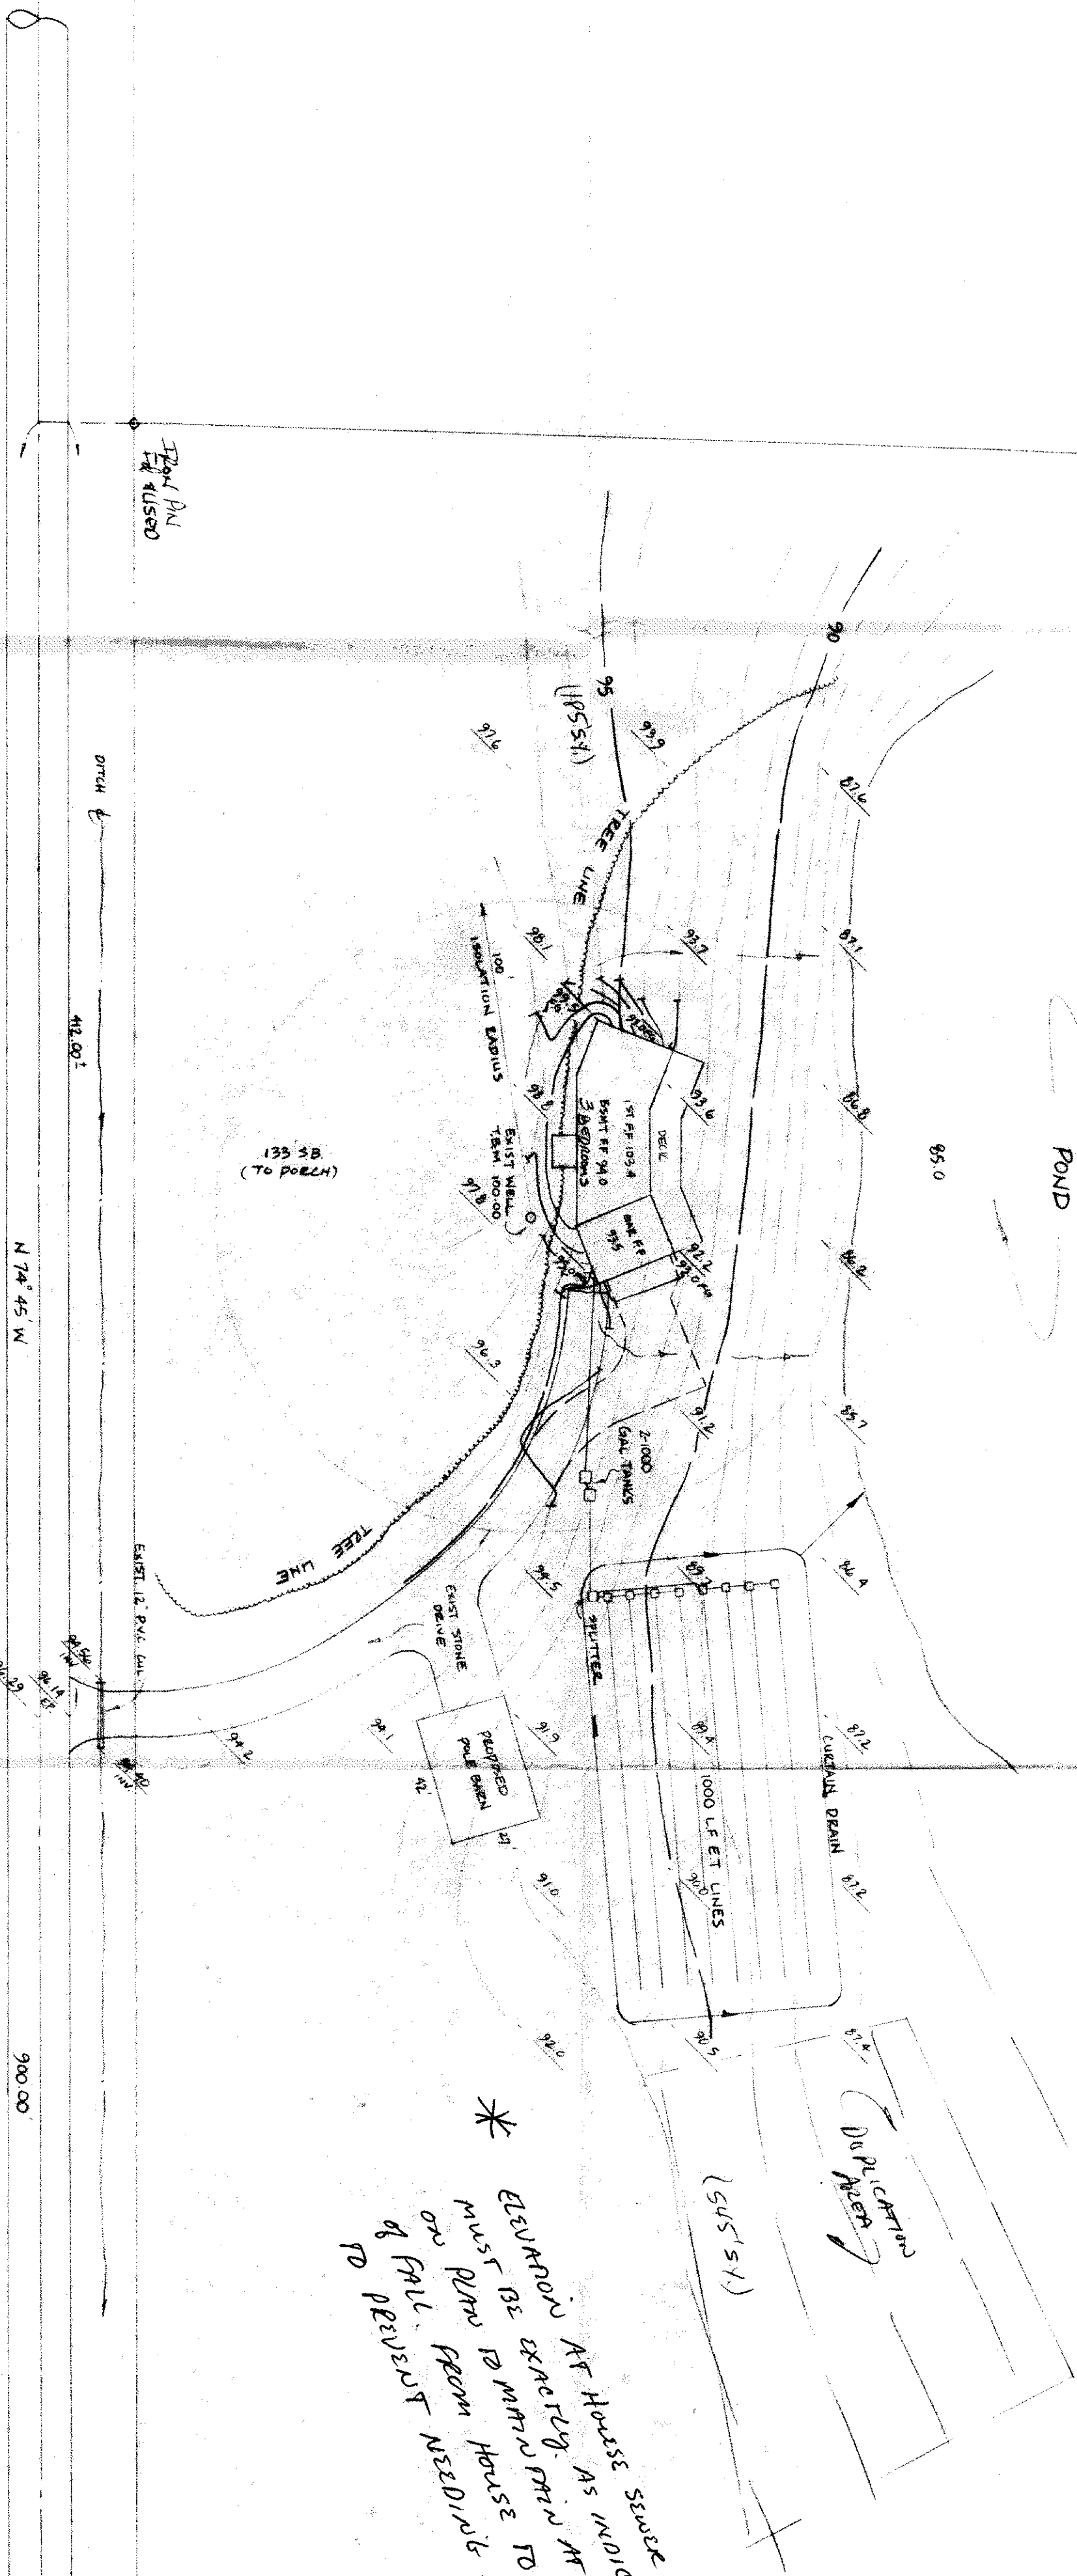

* ELEVATION AT HOUSE SEWER PIPE MUST BE EXACTLY THE SAME AS THE ELEVATION AT THE PUMP. OR FALL. A FEET. TO PREVENT BACKFLOW.

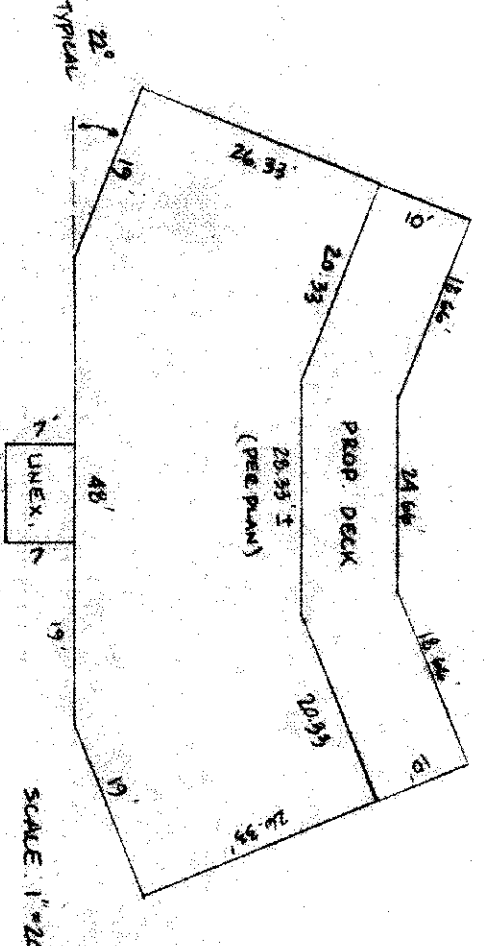

SITE PLAN FOR FRANK VIDERVAL 6082 River Rd. MADISON OH.

BABCOCK, JONES AND ASSOCIATES, INC.
CIVIL ENGINEERS - SURVEYORS - LAND PLANNERS
PAINESVILLE OHIO 44077

DATE 1-7-90
DESIGN BY JH
DRAWN BY JL
APPROVED BY JH

KNOW AS BEING A PART OF TRACT 10 IN MADISON TWP.
Vol. 572 - PG. 105 DEEM PARCEL # 1A-42-2
COUNTY OF LAKE STATE OF OHIO

SCALE 1" = 40'
JOB NO. 91-003
SHEET 1 OF 1