


N

I, THE UNDERSIGNED, HEREBY CERTIFY THAT THE TOPOGRAPHY SHOWN HEREON, INDICATED BY 1" CONTOURS AND ELEVATIONS REPRESENTS AN ACTUAL FIELD TOPOGRAPHIC SURVEY MADE BY ME ON THE 21ST OF AUGUST, 1991, AND THAT THE ELEVATIONS WERE TAKEN AT APPROPRIATE INTERVALS AND THAT AS OF THAT DATE THEY EXISTED AS SHOWN HEREON.

JOEL LUCIA, R.S., M.P.H.
Health Commissioner

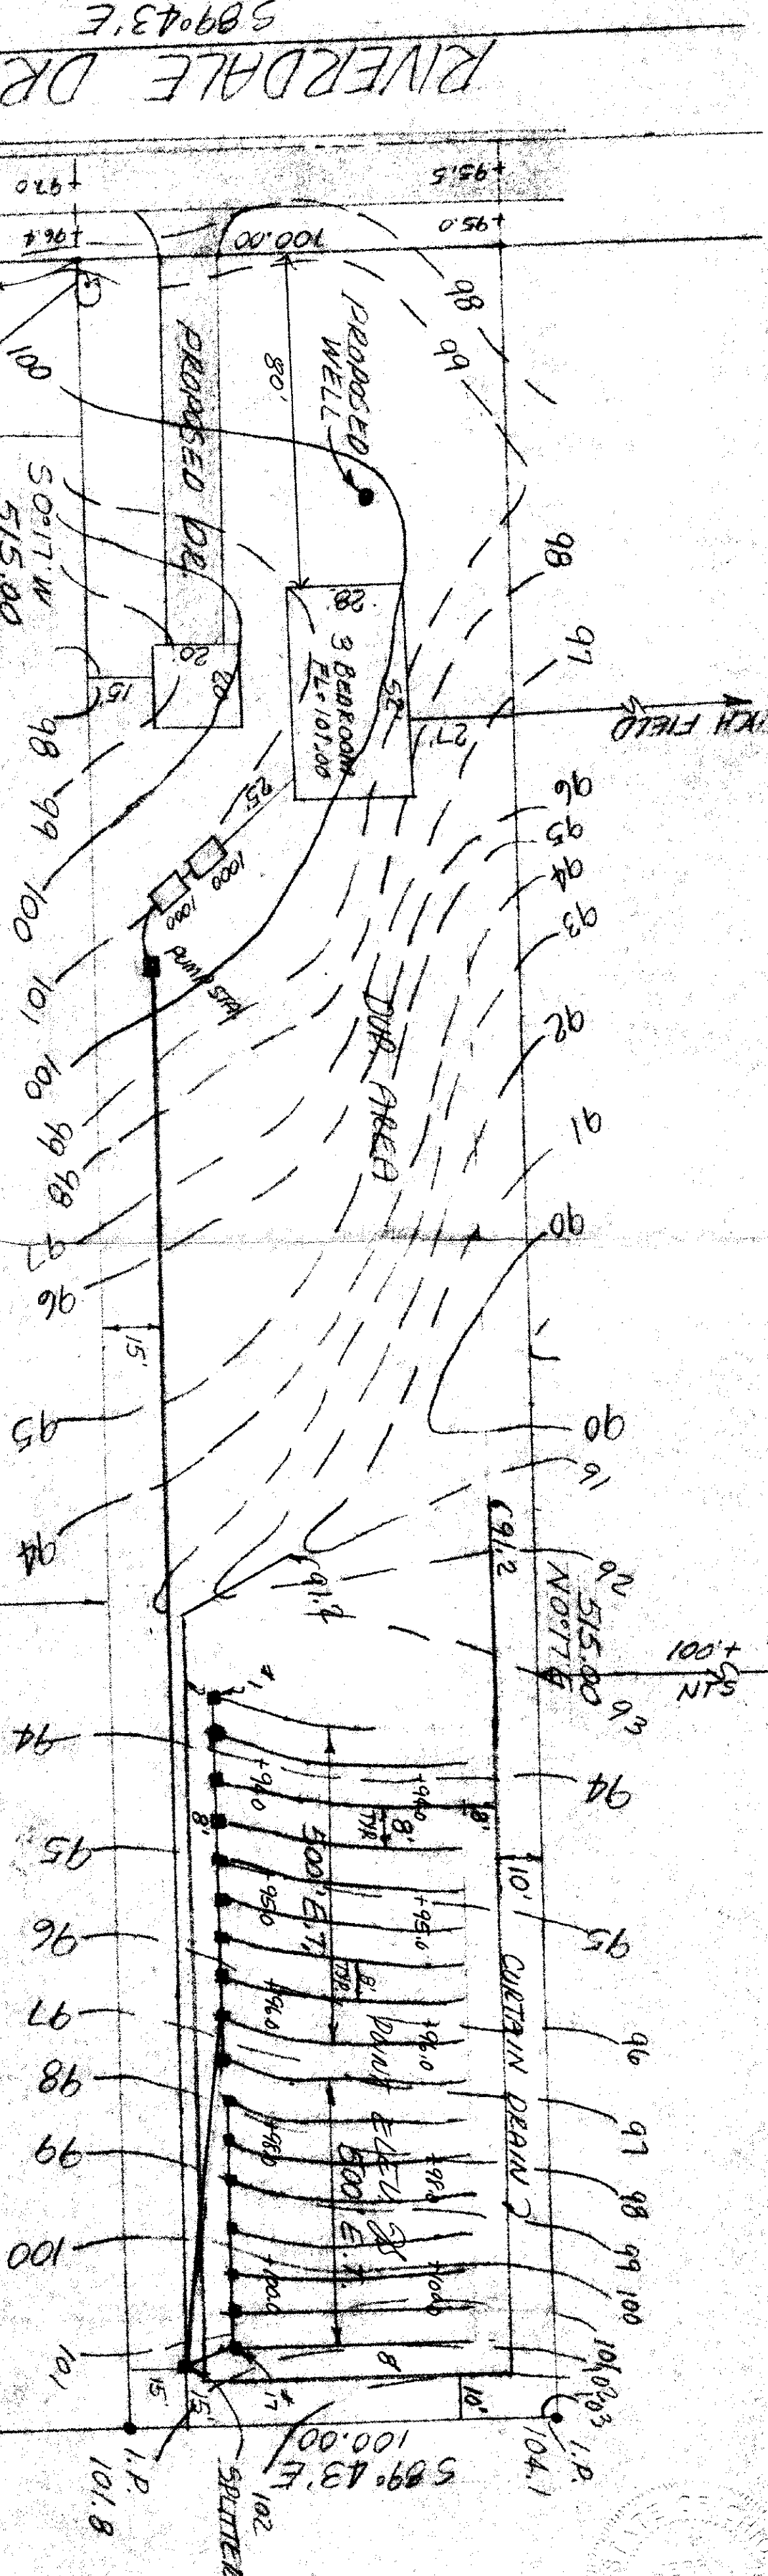

B.M. P.K. NAIL
WEST SIDE TREE = 100.00

EX. PROFILE 15' FROM E.P.D.

APPROX WELL

- DIST. BOXES - SOUTH TO NORTH
- 1. 91.8
 - 2. 92.2
 - 3. 92.6
 - 4. 93.0
 - 5. 93.4
 - 6. 93.8
 - 7. 94.1
 - 8. 94.8
 - 9. 95.2
 - 10. 95.3
 - 11. 96.0
 - 12. 96.5
 - 13. 97.0
 - 14. 97.6
 - 15. 97.7
 - 16. 98.5
 - 17. 98.6
- E.T. LINES 1" LOWER THAN DIST. BOXES

Reviewed and Accepted
LANE COUNTY GENERAL HEALTH DISTRICT
Date 9.10.91
JOEL LUCIA, R.S., M.P.H.
Health Commissioner
BY: N. T. TULLOZ

SEWAGE DISPOSAL PERMIT MUST BE OBTAINED BY A LANE COUNTY LICENSED INSTALLER BEFORE INSTALLATION IS STARTED.

- A. To be brought to finished grade
- 1. Septic tank manhole covers
 - 2. Splitter box cover
 - 3. Distribution box cover

LOW YIELD WATER FIXTURES REQUIRED ON ALL:

BOB WHITED

DATE 9.14.91

MADISON PALISADES SUB MADISON

250 GAL PUMP STA. W/ SEWAGE EFFLUENT PUMP W/ ADJUSTABLE ALARM IN HOUSE

HYDRAULIC PROFILE
1" = 5' VERT
1" = 30' HOR.

4" PER. PIPE

3" WASHED GR.

CURTAIN DRAIN - 6" DEEPER THAN E.T.

Grading Plan Approved
as shown and/or noted
THOMAS P. GILLES, P.E.
Lane County Engineer
By: T.H.
Date 9.10.91

589043'E

RIVERDALE DRIVE 50'

16' STONE PUNT.

900' TO C.L. PALISADE DR.

100' TO LEACH FIELD

100' TO LEACH FIELD

APPROX WELL
100' ±
NTS

515.00
NOT TO SCALE

515.00

515.00

