


RECEIVED AUG 14 1987



SCALE: 1"=30'

SURVEY FOR SUBLOT No. 24 IN THE MADISON PALISADES-ON-THE  
GRAND RIVER SUBDIVISION, AS RECORDED IN PLAT BOOK VOL. F PG. 54  
PART OF TRACTS No. 7 & 10  
MADISON TWP.  
LAKE COUNTY, OHIO

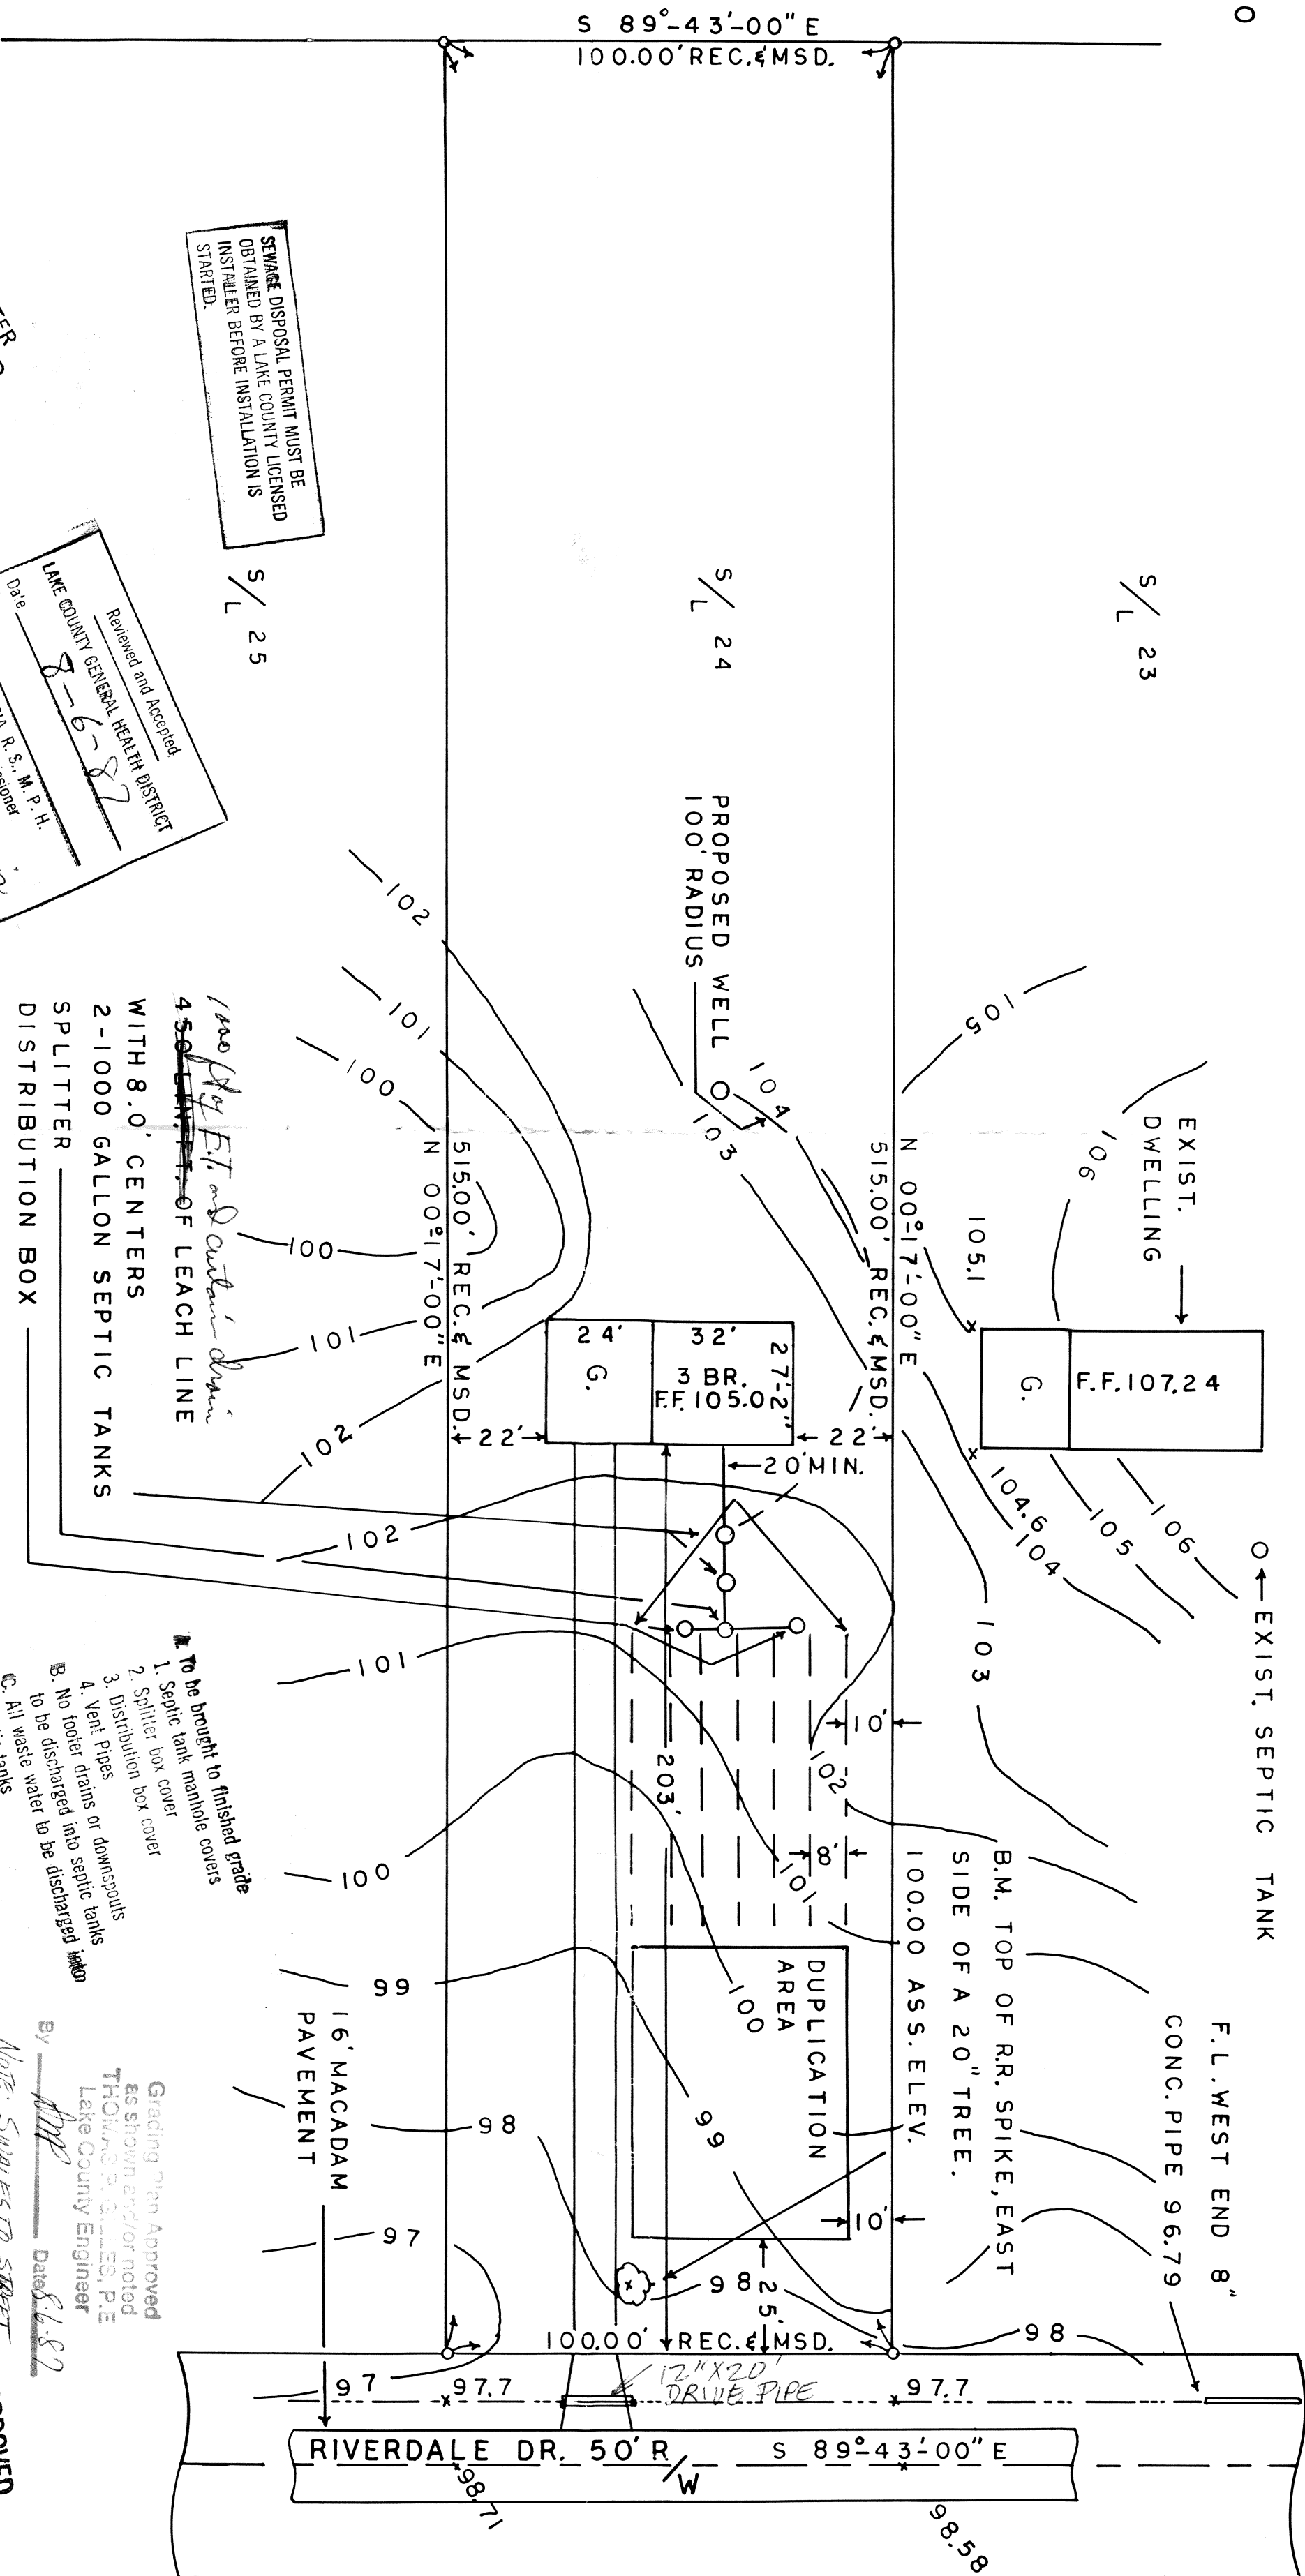

SEWAGE DISPOSAL PERMIT MUST BE  
OBTAINED BY A LAKE COUNTY LICENSED  
INSTALLER BEFORE INSTALLATION IS  
STARTED.

LOW YIELD WATER  
FIXTURES REQUIRED  
ON ALL  
Shower Head  
Toilet

Reviewed and Accepted  
LAKE COUNTY GENERAL HEALTH DISTRICT  
Date: 8-6-87  
JOEL LUKA, R. S., M. P. H.  
Health Commissioner  
BY: [Signature]


LEGEND:

o = I.P. FOUND & USED

- \* To be brought to finished grade
- 1. Septic tank manhole covers
- 2. Splitter box cover
- 3. Distribution box cover
- 4. Vent Pipes
- B. No toilet drains or downspouts to be discharged into septic tanks
- C. All waste water to be discharged into septic tanks

Grading Plan Approved  
as shown and/or noted  
THOMAS P. JONES, P.E.  
Lake County Engineer  
By: [Signature] Date: 8.6.87

APPROVED  
MADISON TWP. ZONING  
Permit: 12136  
Zoning Inspector: [Signature]

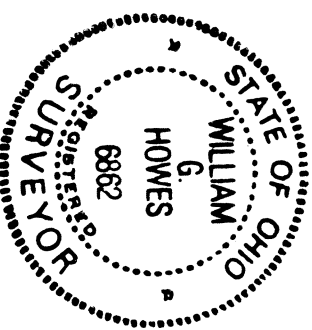

SURVEY FOR  
JOHN W. WATTS  
SURVEYED BY  
WILLIAM G. HOWES  
R.S. No. 68862  
7-12-87  
JOB No. A-95  
A-98