


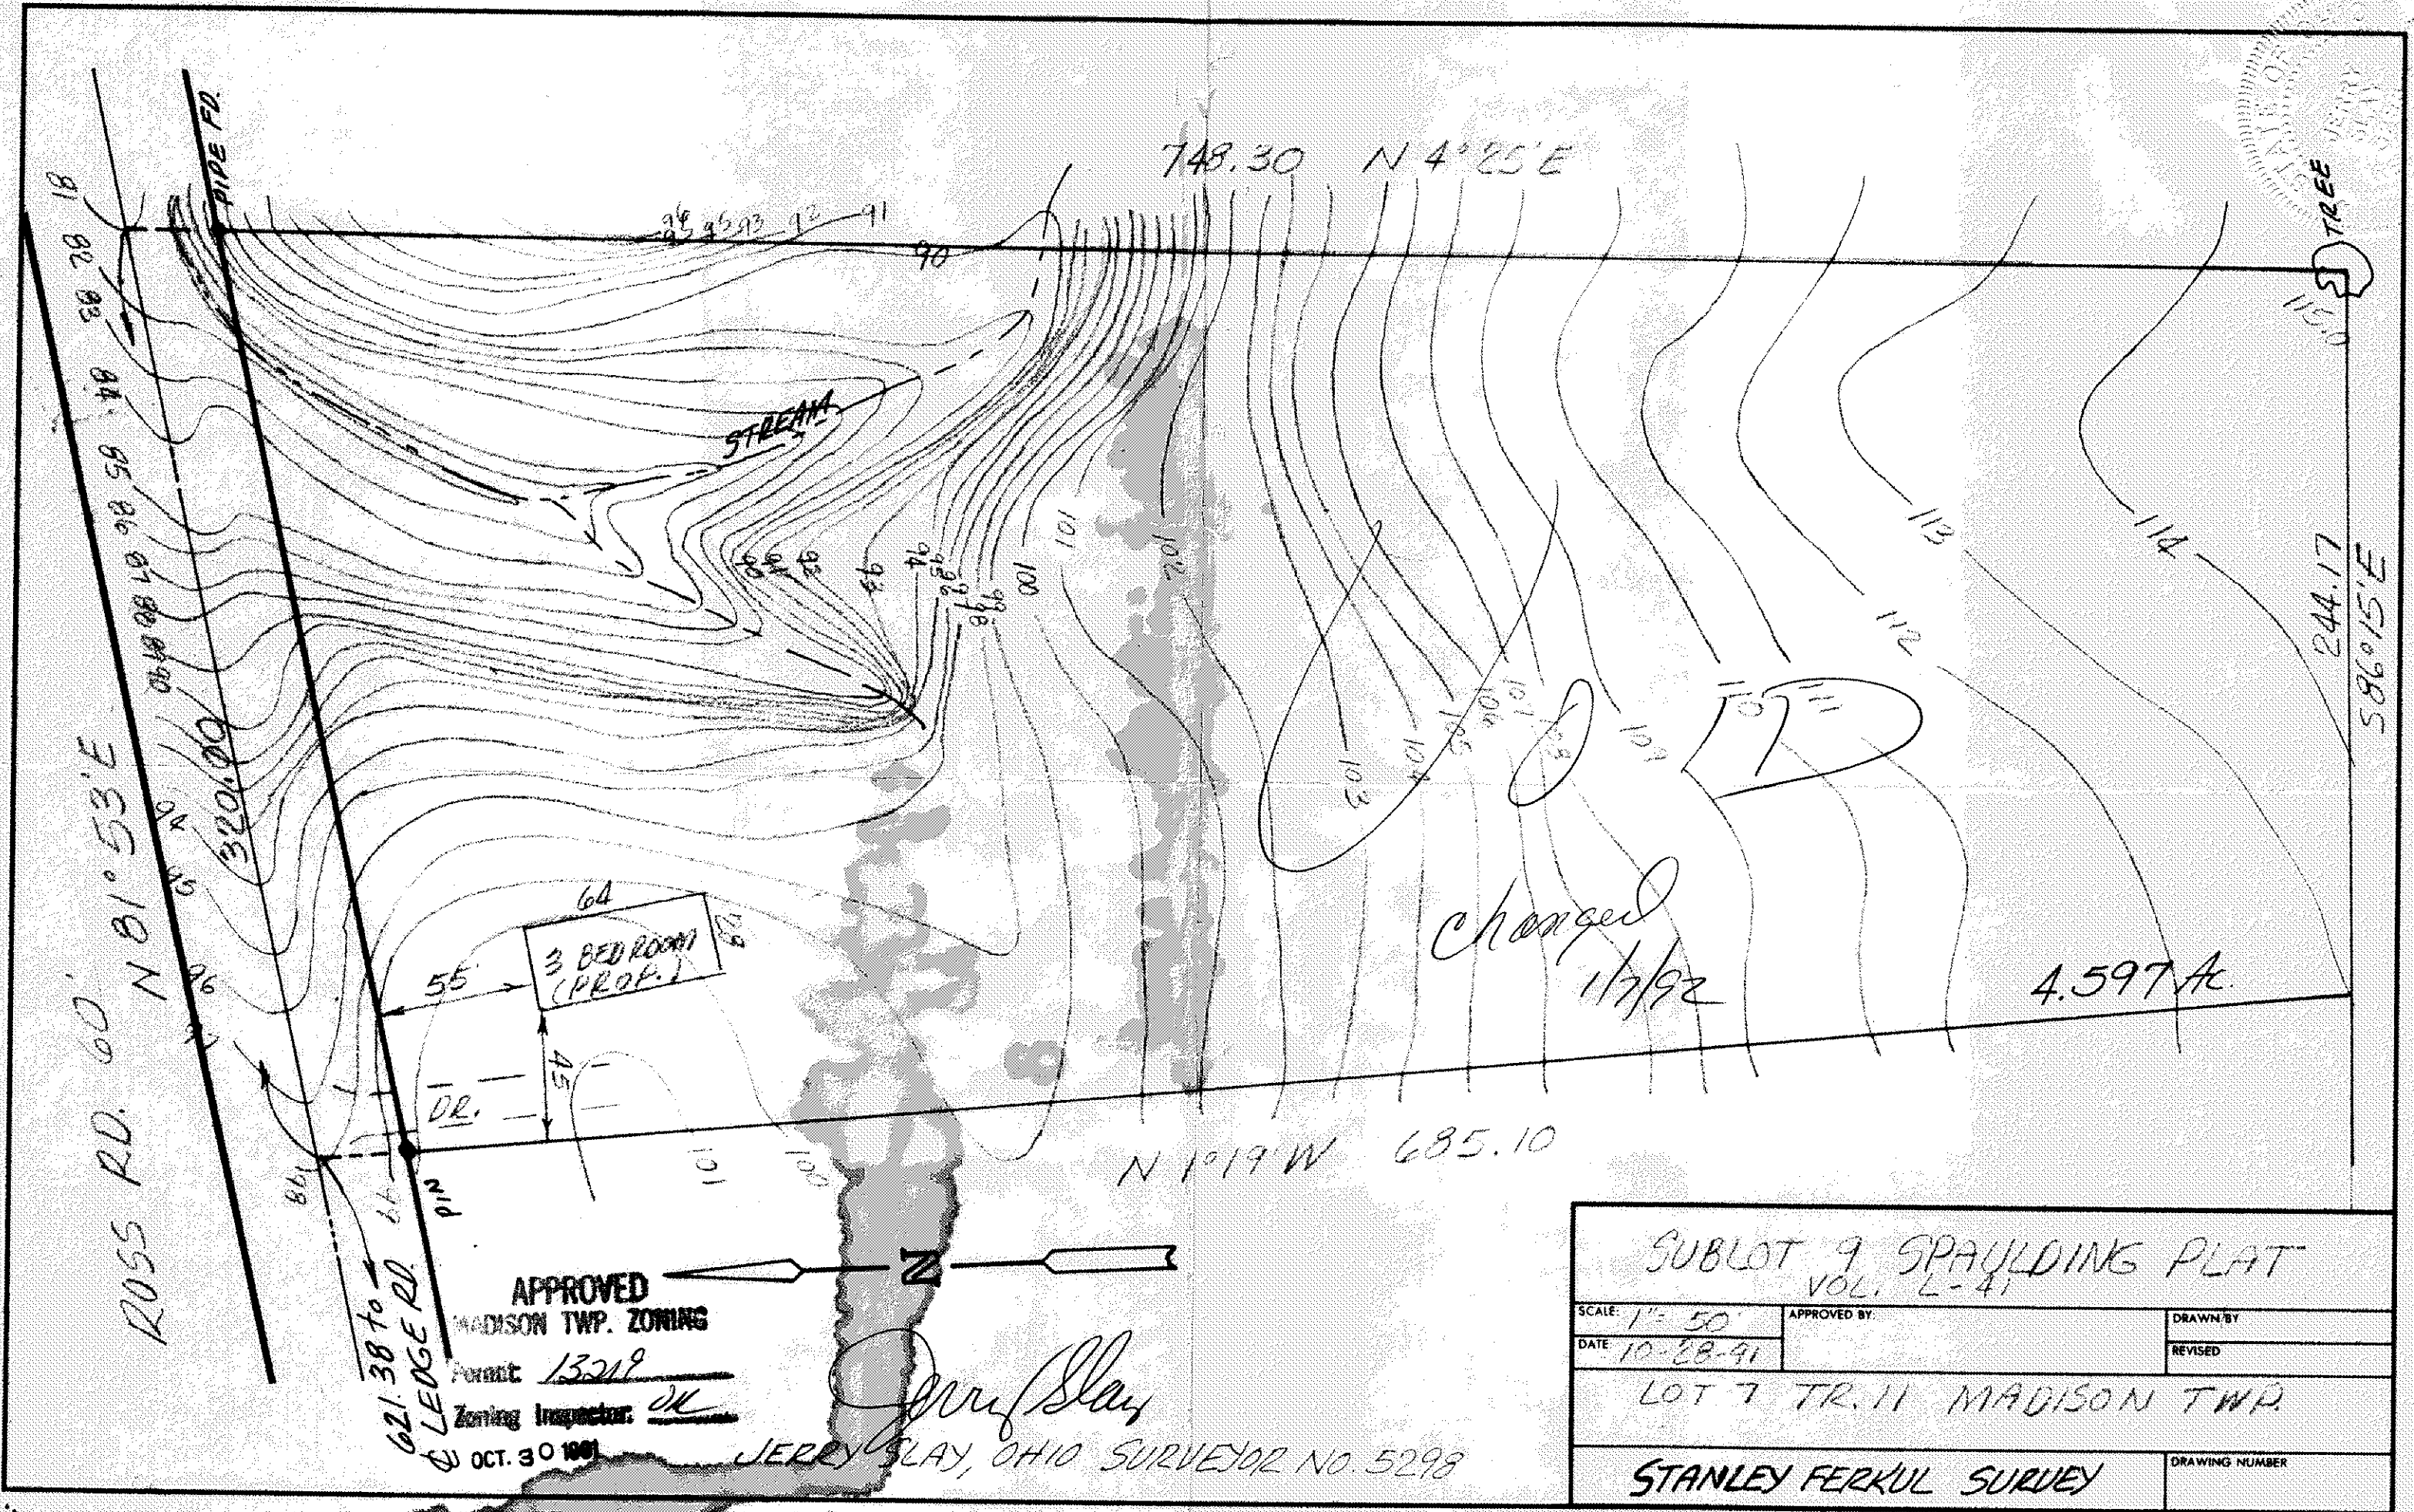

SQUARE FEET = 1792

FOUNDATION - CONCRETE SLAB + 2" COARSE OF CEMENT BLOCK

TYPE OF HOME - 2 BE MODULAR