

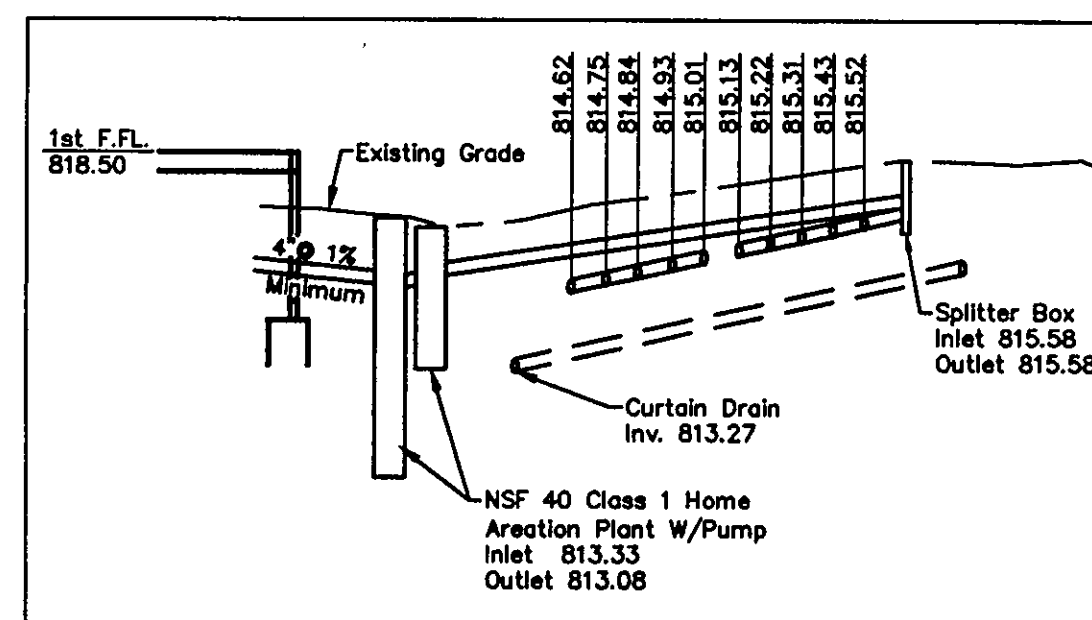
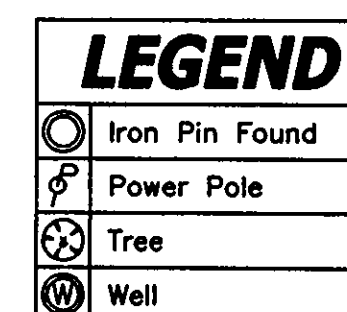


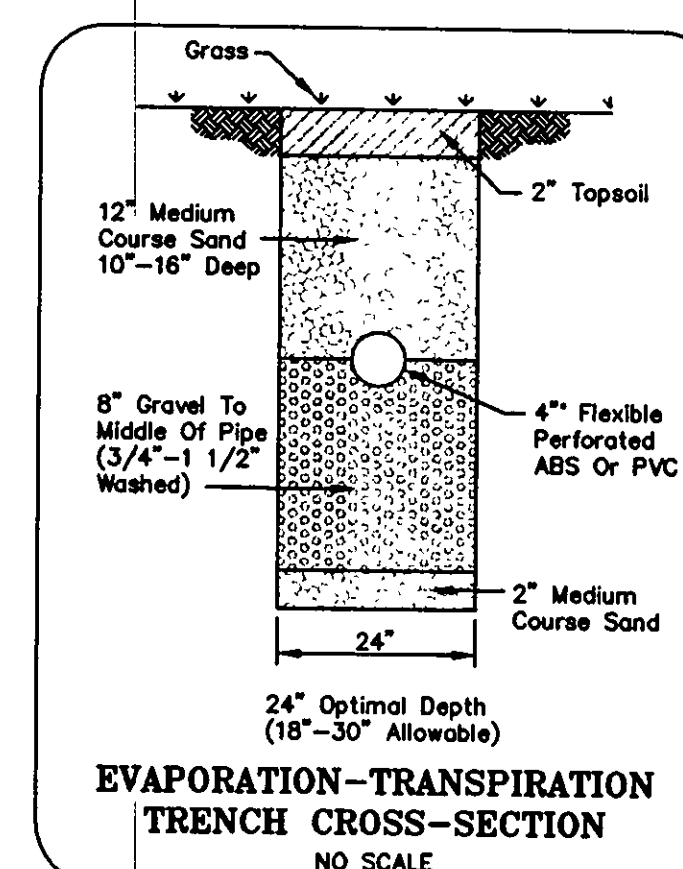

Hydraulic Profile

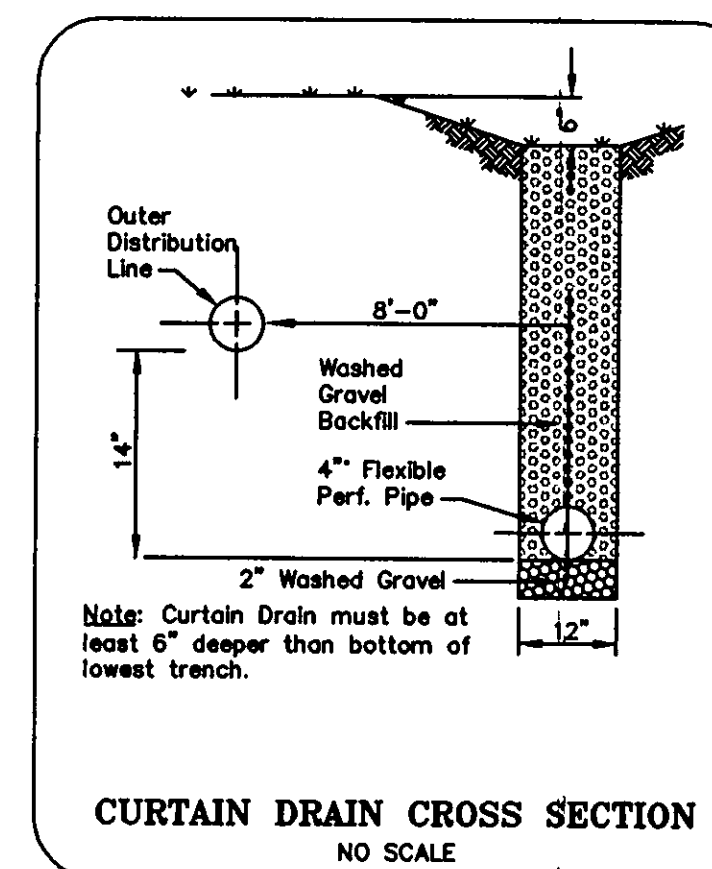

REVIEWED AND ACCEPTED
LAKE COUNTY GENERAL
HEALTH DISTRICT

Date 11-12-02 BY Gerald B. Norris

AGE DISPOSAL PERMIT MUST BE
AINED BY A LAKE COUNTY LICENSE
LLER BEFORE INSTALLATION IS
IED

LEGEND

	Iron Pin Found
	Power Pole
	Tree
	Well


Existing Well

~~move sewage line
20ft from the
property lines~~

Lot A	5.3773 acres
Area in R/W	0.1030 acres
Total	5.4803 acres

County Line Road

APPROVED
MADISON TOWNSHIP ZONING
DATE 11/19/02
BY 21187

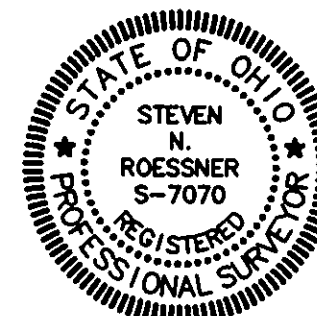

"I, the undersigned hereby state that this topography, indicated by 6", 1' or 2' contours, and the elevations shown hereon represent an actual field survey made by Foresight Engineering Group, Inc. on the 16 day of September, 2002 and that the elevations were taken at appropriate intervals and that as of that date they existed as indicated hereon."

Steven N. Roessner 11/11/02