


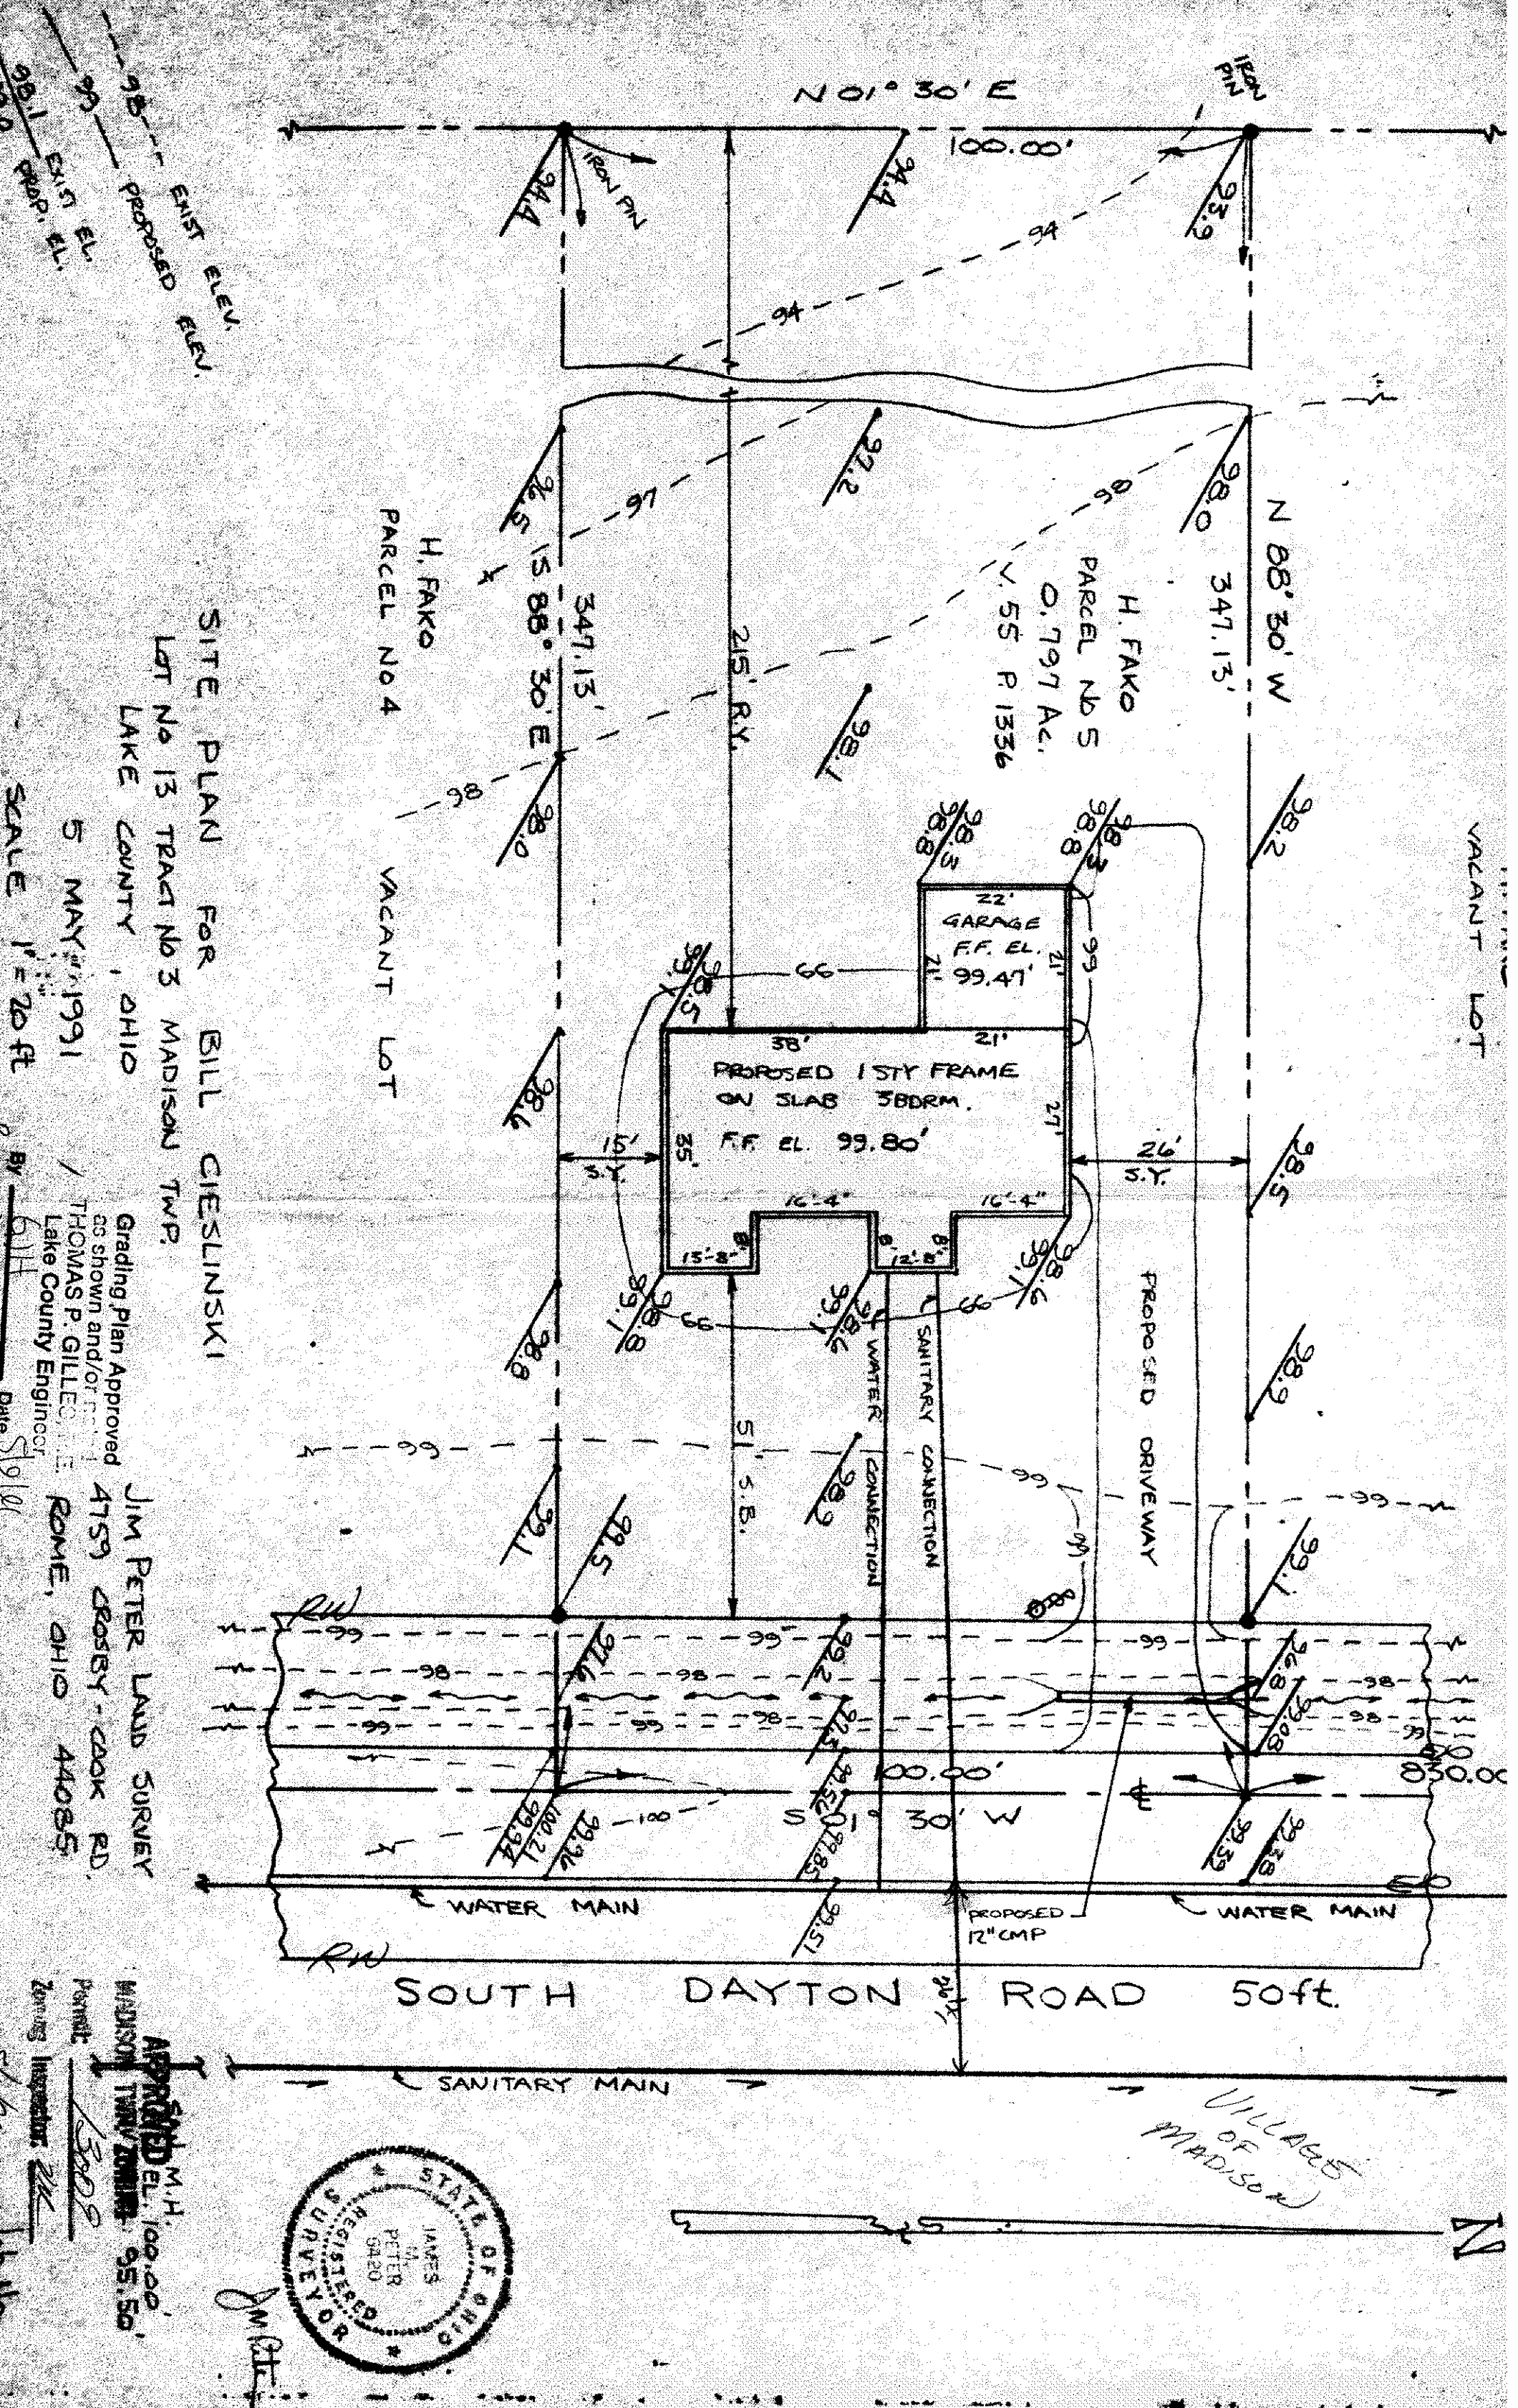

SITE PLAN FOR BILL CIESLINSKI
LOT NO 13 TRACT NO 3 MADISON TWP.
LAKE COUNTY, OHIO
5 MAY 1991
SCALE 1" = 20' FT

Grading Plan Approved
as shown and/or noted
THOMAS P. GILLESPIE
Lake County Engineer
JIM PETER LAUD SURVEY
4759 CROSBY - CROK RD.
ROME, OHIO 44085

APPROVED M.H.
EL. 100.00
MADISON TWP. ZONING 95.50
Permit
1302
Zoning Inspector

