
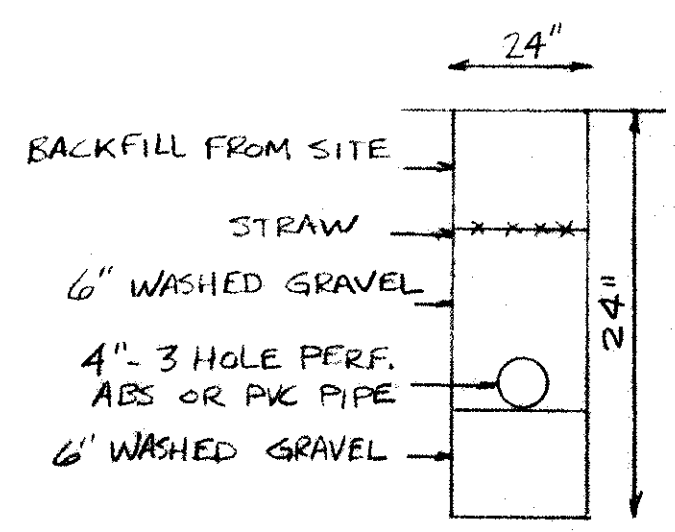


Grading Plan Approved
as shown and/or noted
THOMAS P. GILLES, P.E.
Lake County Engineer
By GTH Date 11/20/91

I, THE UNDERSIGNED HEREBY CERTIFY THAT
THE TOPOGRAPHY SHOWN HEREON INDICATES
BY ONE FOOT CONTOURS & ELEVATIONS
AN ACTUAL FIELD TOPOGRAPHIC SURVEY
MADE BY ME ON THE 12TH DAY OF
NOV. 1991, AND THAT THE ELEVATIONS
WERE TAKEN AT APPROPRIATE INTERVALS
AND THAT AS OF THAT DATE THEY EXISTED
AS INDICATED HEREON.

JMR

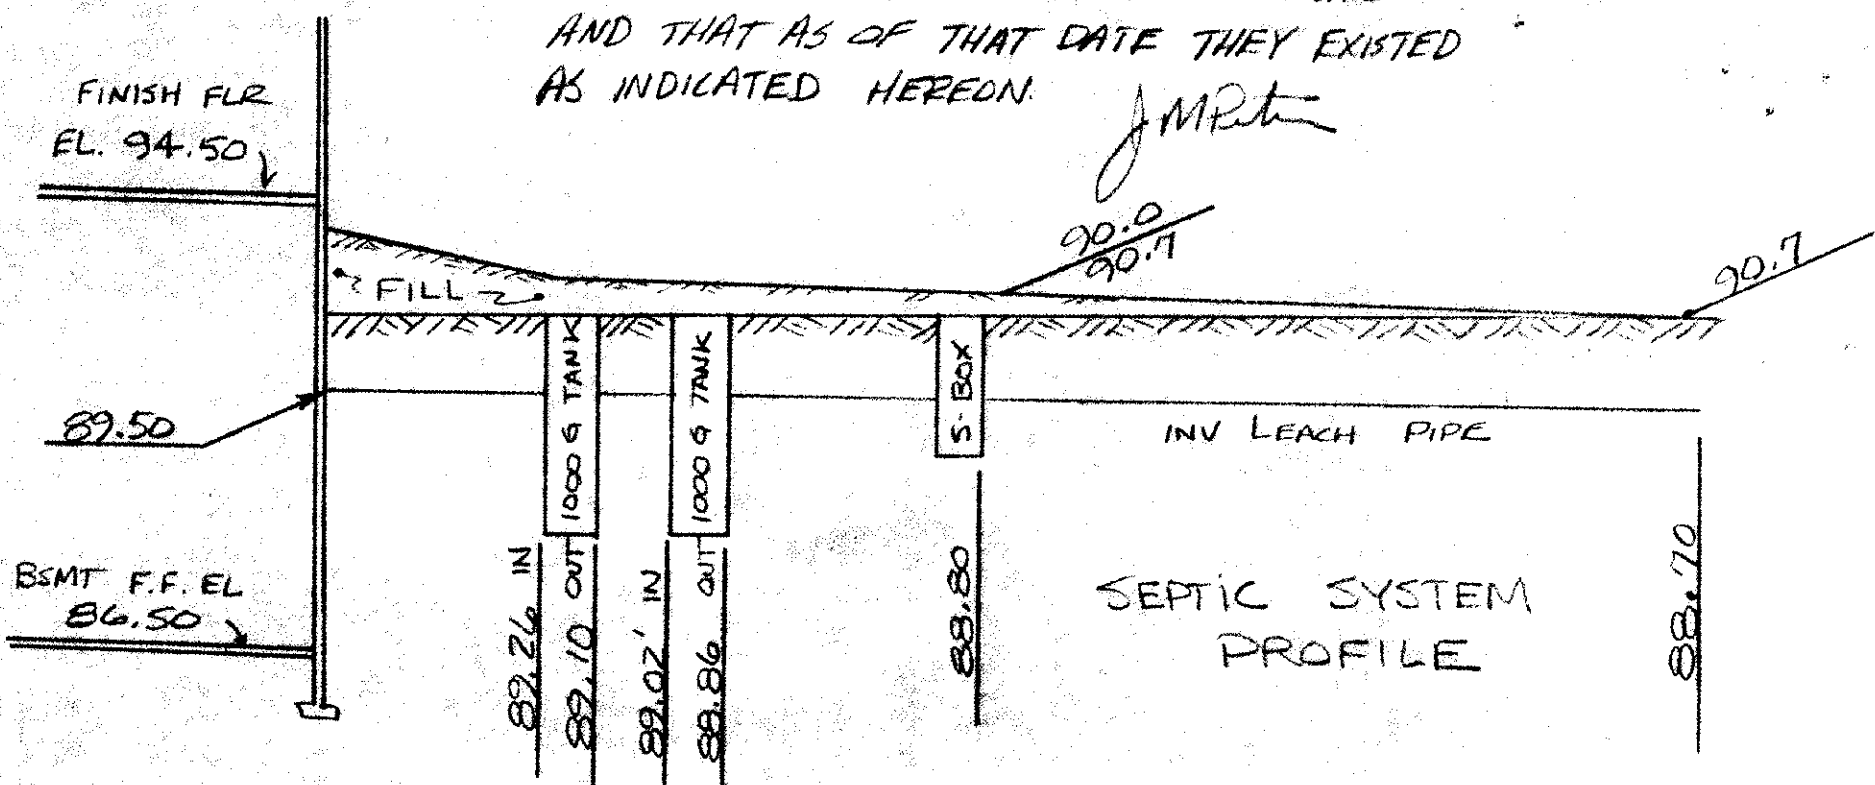

LEACH TRENCH CROSS-SECTION

