

SITE PLAN

MANUSAL TOWNSHIP, LAKE COUNTY, OHIO

for: **LATICA DAVIS**

OWNER: **210 SPANISH HILL AVE. MASSILLON 44446**

ADDRESS: **STREET CITY ZIP**

SUBDIVISION: **VOL. - PG.** NAME: **LOT 14** TRACT: **1081**

SUBLOT NO.: **STREET** PERMIT/FINANCE NO.: **5790771** STREET: **1081**

LEGEND

SANITARY MANHOLE: **○** WATER VALVE (GAS): **○**
 STORM MANHOLE: **●** WATER METER (GAS): **○**
 INLET OR CATCH BASIN: **○** AS BUILT ELEVATION: **○**
 HYDRANT: **○** EXISTING CONTOURS: **---**
 PROPOSED CONTOURS: **---**
 EXIST. ELEV.: **100.0** PROP. ELEV.: **100.0**

REMARKS

ALL BOUNDARY DATA SHOWN WAS OBTAINED FROM (DEEDS, RECORDED SUBDIVISION PLAT OR OTHER PUBLIC RECORDS)
 LOCATIONS AS SHOWN OF ADJACENT WELLS AND SEPTIC TANKS OBTAINED FROM LAKE COUNTY HEALTH DEPARTMENT

DESIGN CERTIFICATION

THIS PLAT WAS PREPARED BY ME, AND IS CORRECT TO THE BEST OF MY KNOWLEDGE AND BELIEF

NAME: **JOEL LUCIA R. S. M. P. H.** REGISTRATION NO.: **5790771**

CHECK LIST

NO. OF BEDROOMS: **3** WATER MAIN SIZE LOCATION: **1" = 30'**
 BEARINGS: **102°18'N** SAN. SEWER SIZE: **12"** OR. LOC.: **102°18'N**
 SUBLOT NO. PARCEL NO.: **102°18'N** SAN. MAIN: **12"** OR. LOC.: **102°18'N**
 SURROUNDING OWNERS: **102°18'N** SAN. MAIN: **12"** OR. LOC.: **102°18'N**
 ELEV. DIMENSIONS: **102°18'N** SAN. MAIN: **12"** OR. LOC.: **102°18'N**
 ACTION TYPE: **102°18'N** SAN. MAIN: **12"** OR. LOC.: **102°18'N**
 SIGNATURE: **102°18'N** SAN. MAIN: **12"** OR. LOC.: **102°18'N**
 CULVERT TYPE: **102°18'N** SAN. MAIN: **12"** OR. LOC.: **102°18'N**
 ROCK OUTCROPPING: **102°18'N** SAN. MAIN: **12"** OR. LOC.: **102°18'N**

PLAN PREPARED BY: **BABCOCK • JONES & ASSOCIATES, INC.**

PAINEVILLE, OHIO

NO.	DATE	BY
1	10/2/89	BY
2	10/11/93	BY
3	10/11/93	BY
4	10/11/93	BY
5	10/11/93	BY

"AS BUILT" CERTIFICATION

I, HEREBY CERTIFY THAT THE CIRCLED GRADES ARE EXISTING FINISH GRADES CHECKED IN THE FIELD ON **19** AND ARE CORRECT TO THE BEST OF MY KNOWLEDGE AND BELIEF.

REGISTERED SURVEYOR REG. NO. **5790771**

THM - TOP OF TRAIL PILE

CHIEF ENGINEER OF THIS PROJECT



ELEV. = 100.00

SOUTH RIDGE ROAD - 60'

4 BARS LONG

Grading Plan Approved
 as shown and/or noted
 THOMAS P. GILLES, P.E.
 Lake County Engineer

By **G.H.** Date **10/24/97**

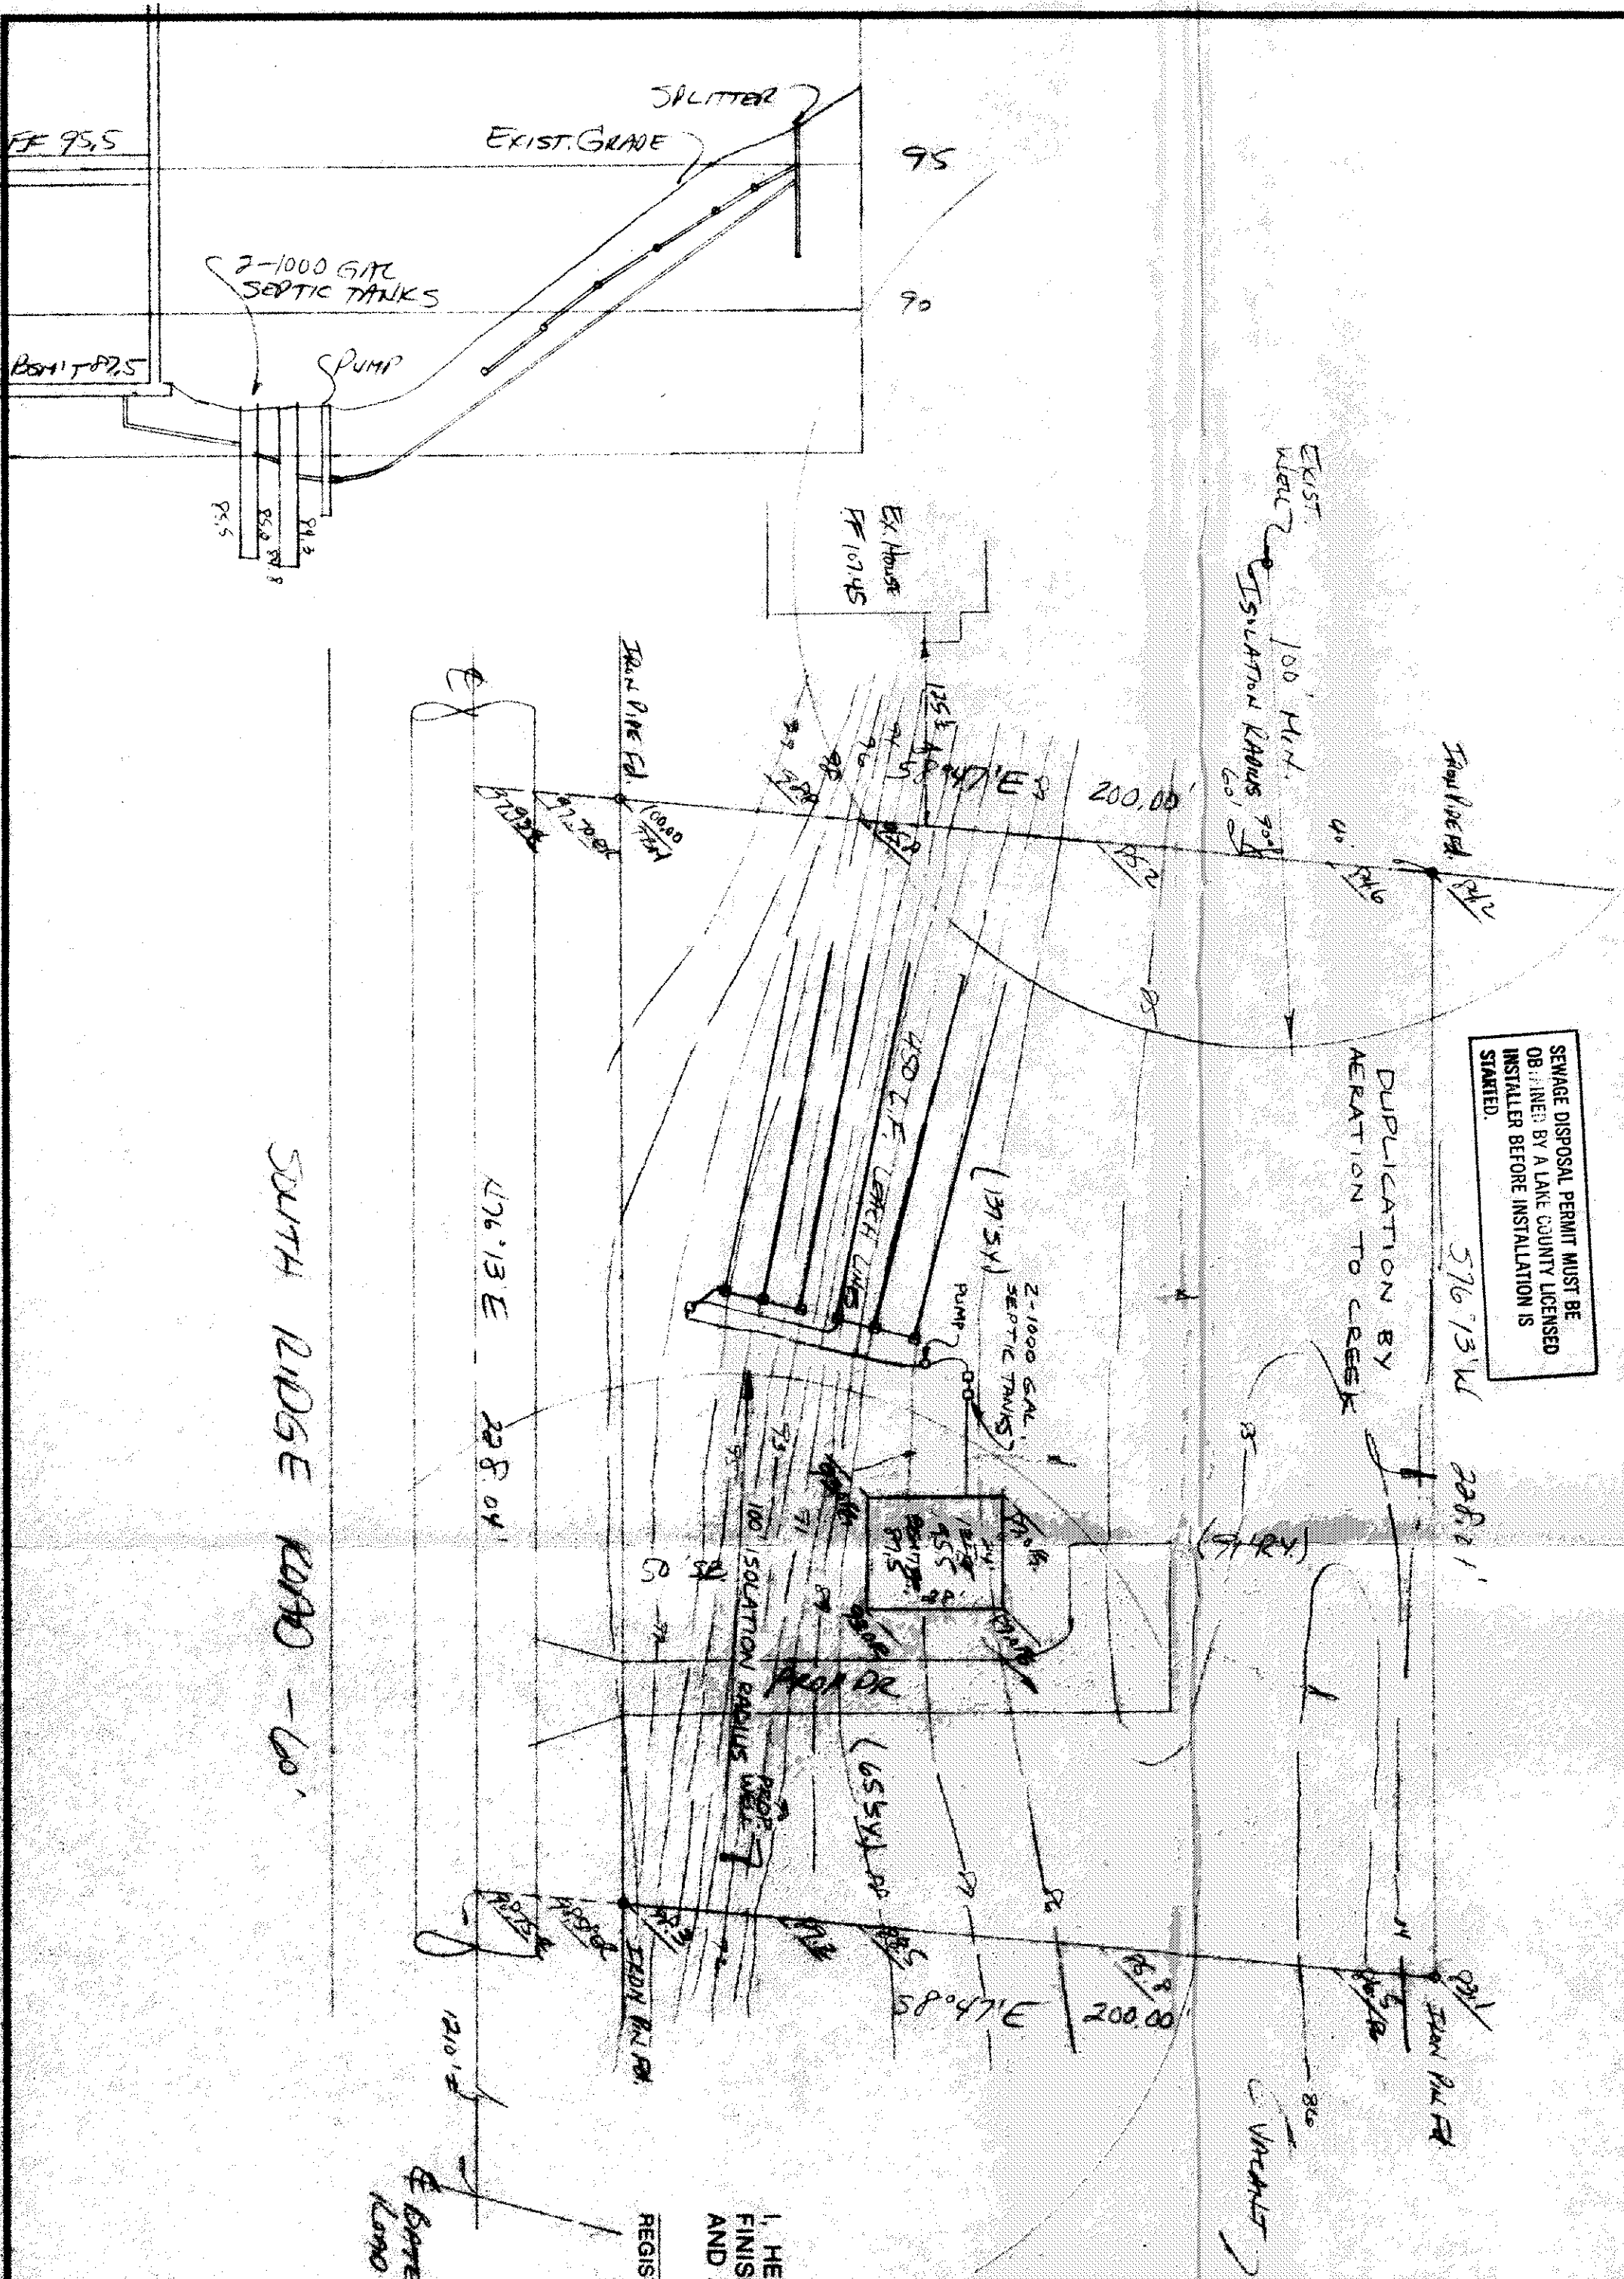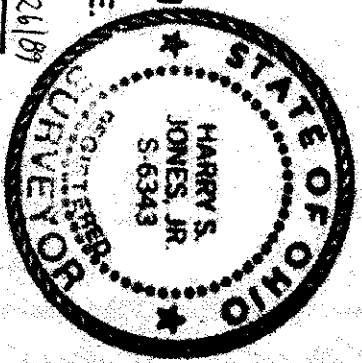

- To be brought to finished grade
- Septic tank manhole covers
- Splitter box cover
- 1" x 1" x 1" box cover
- No fecer drains or downspouts
- To be discharged into septic tanks
- All waste water to be discharged into septic tanks

LOW YIELD WATER
 FIXTURES REQUIRED
 ON ALL:
 Shower Head
 Toilet

SEWAGE DISPOSAL PERMIT MUST BE OBTAINED BY A LAKE COUNTY LICENSED INSTALLER BEFORE INSTALLATION IS STARTED

Reviewed and Accepted
 LAKE COUNTY GENERAL HEALTH DISTRICT
 Date: **10-20-89**
 Check lines against 80% Slope
 JOEL LUCIA R. S. M. P. H.
 Health Commissioner
 By: **Quadrone**

NOTE:
 THIS LOT IS NOT IN
 A DESIGNATED FLOOD
 ZONE PER **174254**
 INSURANCE MAPS. FLOOD