
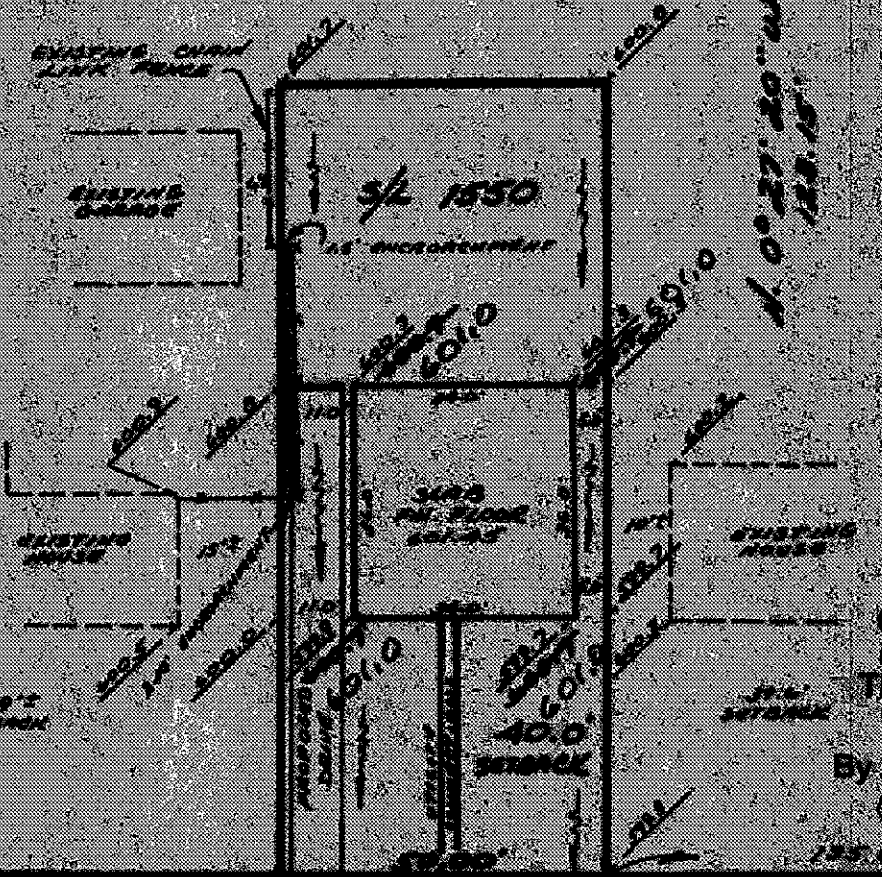


S. 89° 12' 10" W.
50.00'

S. 0° 27' 20" E.
122.45'

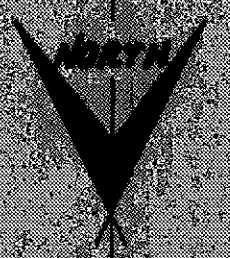

Grading Plan Approved
as shown and/or noted
THOMAS P. GILLES, P.E.
Lake County Engineer

By *JWK* Date *12-1-76*



SCOTLAND STREET 50'

TRAVERS ROAD 40'

2.0' DIA. SANITARY
MANHOLE - 10' DEPTH
270.00'

APPROVED
MADISON TWP. ZONING

Permit: *9700*
Zoning Inspector: *John P. Brown*

"AS BUILT" CERTIFICATION

I, HEREBY CERTIFY THAT THE CIRCLED GRADES ARE EXISTING FINISH
GRADES CHECKED IN FIELD ON *12-1-76* BY
SURVEYING AND ARE CORRECT TO THE BEST OF MY KNOWLEDGE AND BELIEF.

REGISTERED SURVEYOR

REG. NO.

SITE PLAN

MADISON LAKE COUNTY, OHIO

for: NORTHERN INDUSTRIES
CLIENT OWNER

ADDRESS		STREET	CITY	ZIP
SUBDIVISION		NAME	LOT	TRACED
VOL. - PG.		VOLUME	PAGE	
SUBLOT NO.		STREET	PERM. PARCEL NO.	STREET

LEGEND

SANITARY MANHOLE	---	WATER VALVE (GAS)	---
STORM MANHOLE	---	WATER METER (GAS)	---
INLET OR CATCH BASIN	---	AS BUILT ELEVATION	---
HYDRANT	---	INDICATES DIRECTION OF SURFACE DRAINAGE	---
EXISTING CONTOURS	---		
PROPOSED CONTOURS	---		
EXIST. ELEV.	---	PROP. ELEV.	---

REMARKS

ALL BOUNDARY DATA SHOWN WAS OBTAINED FROM (DEEDS, RECORDED
SUBDIVISION PLAT OR OTHER PUBLIC RECORDS)
LOCATIONS AS SHOWN OF ADJACENT WELLS AND SEPTIC TANKS OBTAINED FROM
LAKE COUNTY HEALTH DEPARTMENT

DESIGN CERTIFICATION

THIS PLAT WAS PREPARED BY ME, AND IS CORRECT
TO THE BEST OF MY KNOWLEDGE AND BELIEF.
NAME *Robert J. Salo* SURVEYOR REGISTRATION NO. *PS 45244*

CHECK LIST

NO. OF BEDROOMS	WATER MAIN SIZE, LOCATION
DIMENSIONS	SAN. SEWER SIZE & GR. LOC.
BEARINGS	SAN. MH. CAST ELEV. INV. ELEV.
TIE TO NEAREST STREET	SAN. CONN. SIZE, LOC. DEPTH
SUBLOT NO. PARCEL NO.	STORM SEWER SIZE & GR. LOC.
SURROUNDING OWNERS	STORM MH. CAST ELEV. INV. ELEV.
BLDG. DIMENSIONS FIN. GR.	PAV'T TYPE GRADE CURBS
BLDG. TIES FLY. GRADES	GAS LINE LOC. SIZE PRESSURE
APRON TYPE WIDTH THICKNESS	SEPTIC TANK LOCATION & DUPLICATION AREA
SIDEWALK TYPE WIDTH THICKNESS	WELL LOCATION
CULVERT TYPE DIA. LENGTH	ISOLATION RADIUS FROM WELL
ROCK OUTCROPPINGS	

REVISIONS			PLAN PREPARED BY:	
NO.	DATE	BY	DEBEVEC-SALO & ASSOCIATES, INC.	
1			135 EAST JACKSON ST. FAIRBURN, OHIO	
2				
3			DRAWN BY <i>RJS</i>	SCALE <i>1"=20'</i>
4			CHECK'D <i>RJS</i>	DATE <i>12-1-76</i>
5			CREW CHIEF <i>J</i>	APPRO. <i>1788-1550</i>