


J.F. #DL DEERING
Y 810-1143

① CURVE DATA

N 68.36-44E
1516.19' Radius
5 73-20-DIW
1406.19'
156.48' ARC
155.52'

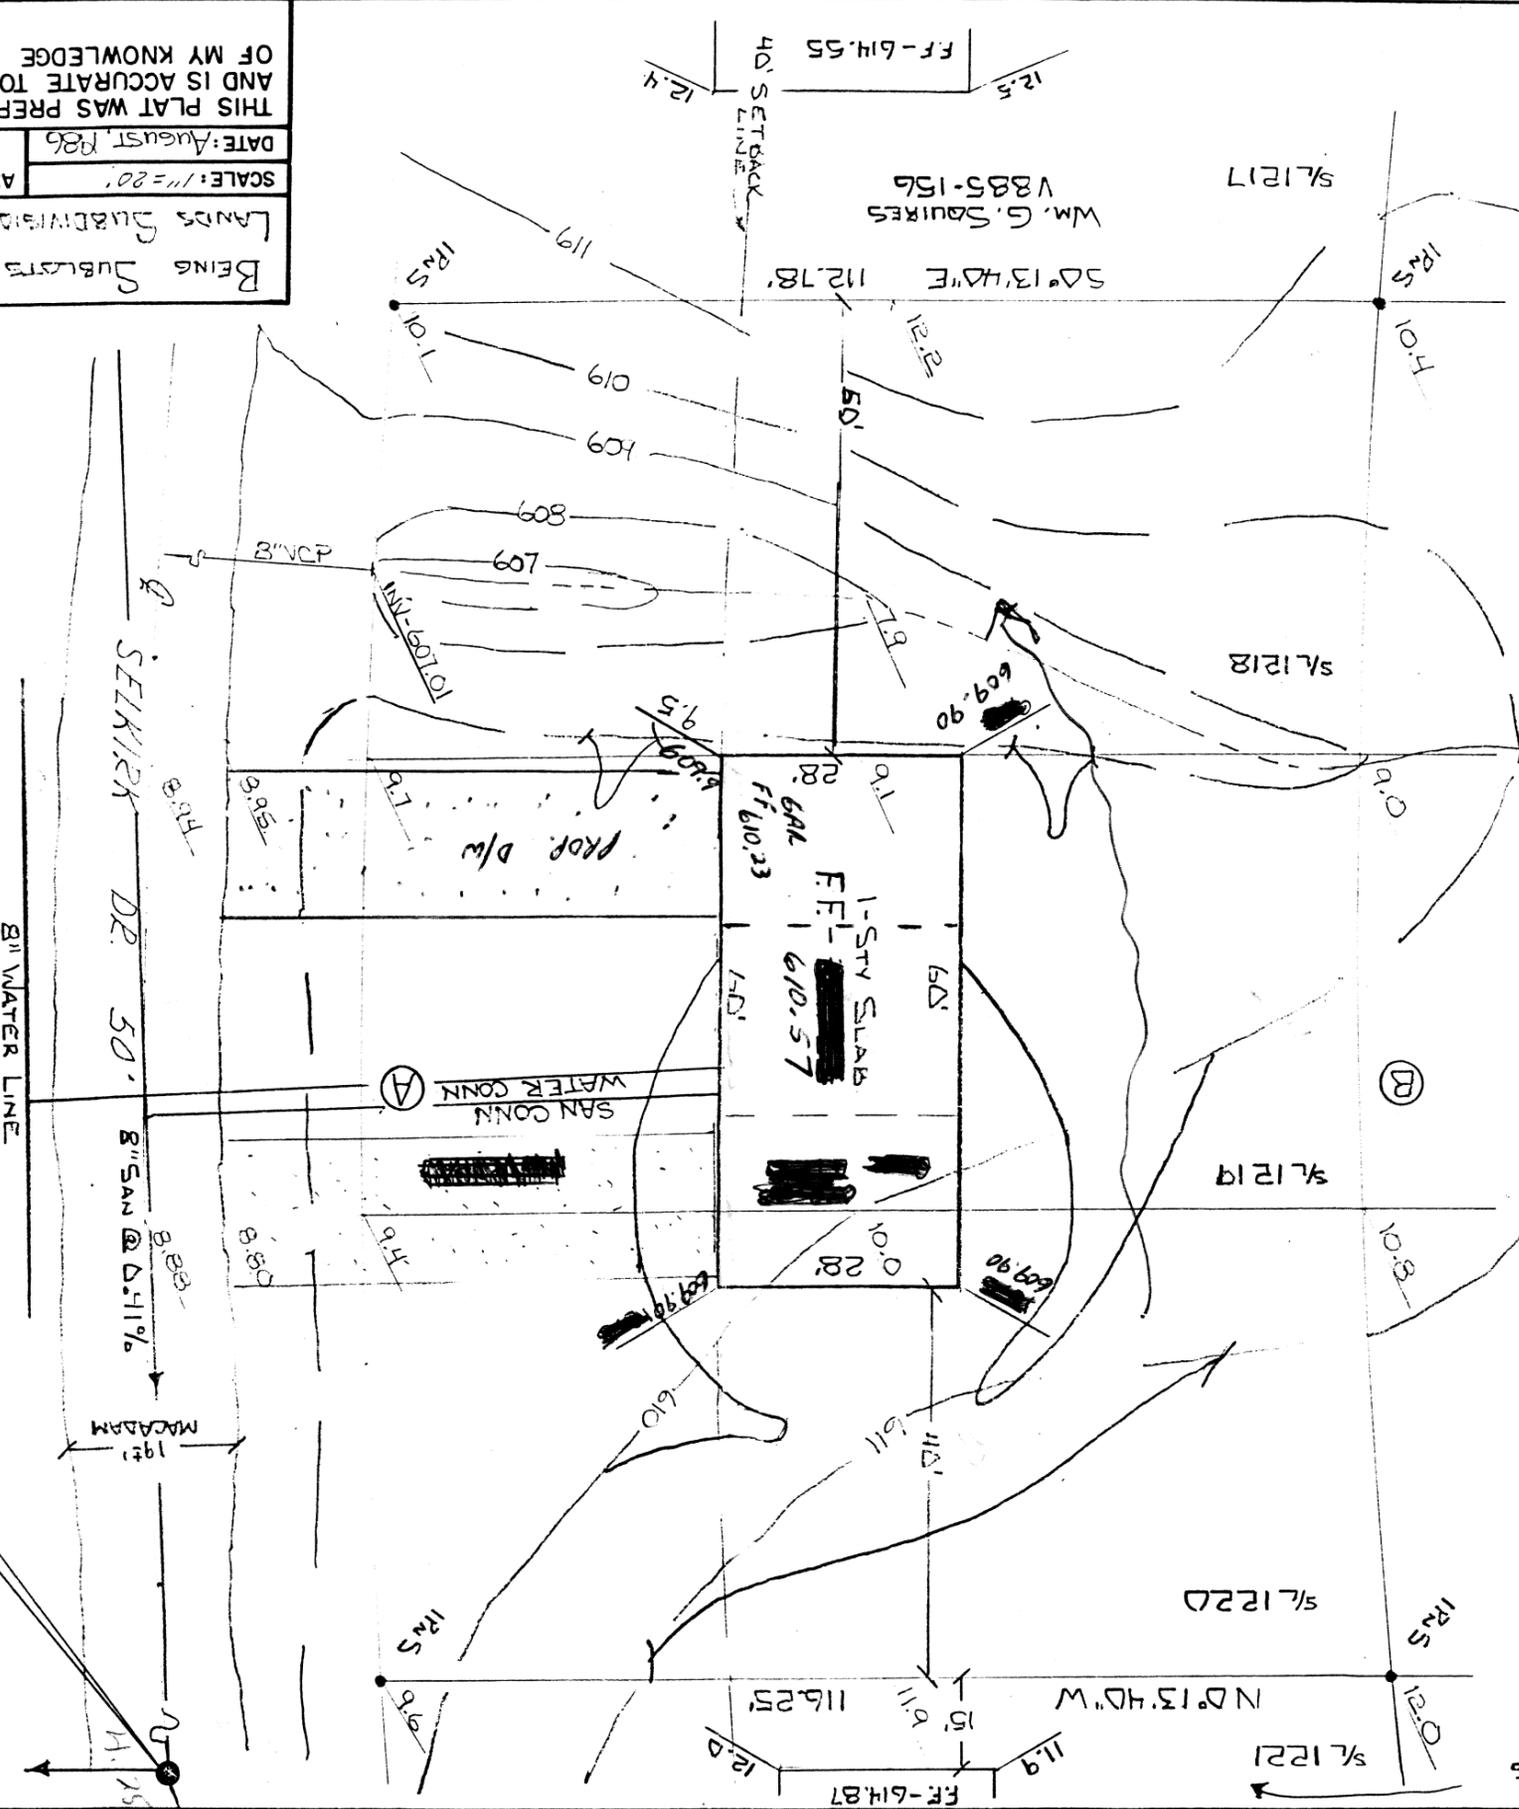

SITE PLAN

W.M. J. SNYDER JR.
Vol. 827-1316

BENCHMARK - 508.20
SAN MH @ TRINITY INTERSECTION

Grading Plan Approved
as shown and/or noted
THOMAS P. GILLES, P.E.
Lake County Engineer

By *[Signature]* Date 9-22-8

EXIST.
PRD.P.

APPROVED
MADISON TWP. ZONING
Permit 11927
Zoning Inspector *[Signature]*



BEING SUBJECTS 1218, 1219, 1220 OF MADISON GOLF LA
LANDS SUBDIVISION, MADISON TOWNSHIP, LAKE COUNTY, O.
DRAWN BY: *[Signature]*
APPROVED BY: *[Signature]*
DATE: August, 1986
SCALE: 1" = 20'

THIS PLAT WAS PREPARED BY ME
AND IS ACCURATE TO THE BEST
OF MY KNOWLEDGE AND BELIEF
[Signature]