


PAC HOMES

AKC CO. Ohio

1130 JUL 14 1965

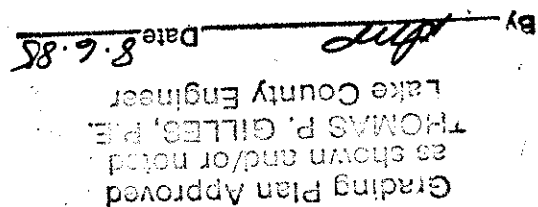

Date 8.6.85

100

[illegible]

Perkins

Zoning Inspector Xuan



540 P26

DRIVE

50

Mr. Wm A. Spoonhauer