


GLENN & RUTHANN GNAGY
#960004192
1B-113A-01

PETER S. & NANCY E. OTTERMAN
#2002R02821
1B-113A-07

PETER S. & NANCY E. OTTERMAN
#2002R028201
1B-113A-2


JOAN CLARK
#199955423
1B-113A-08

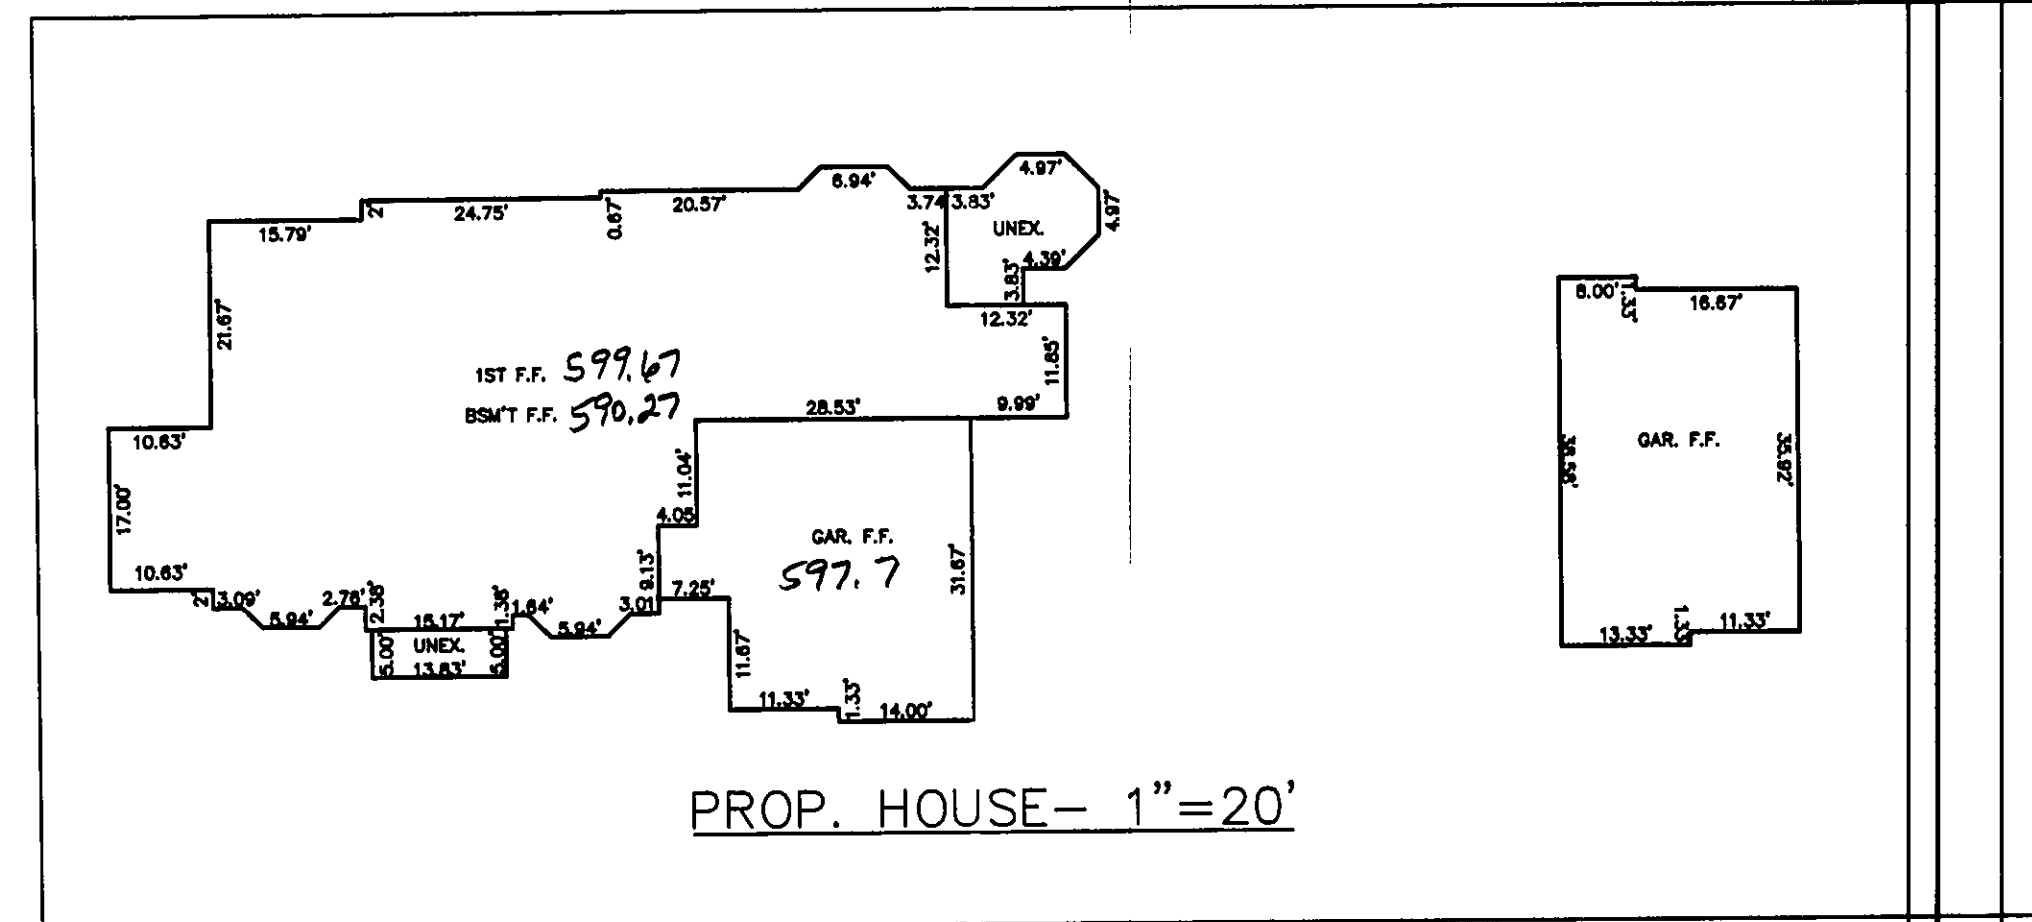

BM - SAN MH
RIM - 595.96

CURVE TABLE					
CURVE	LENGTH	RADIUS	TANGENT	CHORD	DELTA
C1	67.77	622.65	33.93	67.73	98.73609° W 98.1411°

GRAPHIC SCALE

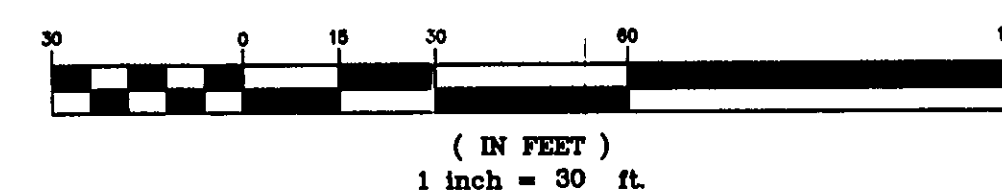


TO BE GRADED
AS PER CONVERSATION
WITH MR. HARRY JONES

BY: [Signature]
Date: 9/10/02
Lake County Engineer
JAMES R. GILLIS, P.E.
as shown and/or noted
Grading Plan Approved

APPROVED
MADISON TOWNSHIP ZONING
DATE: 9/12/02
BY: [Signature]

EXISTING UTILITIES NOTE:
THE SIZE AND LOCATION, BOTH HORIZONTAL AND VERTICAL
OF THE UNDERGROUND UTILITIES SHOWN HEREON, HAVE BEEN
OBTAINED BY A SEARCH OF AVAILABLE RECORDS.
VERIFICATION BY FIELD OBSERVATION HAS BEEN CONDUCTED
WHERE PRACTICAL, HOWEVER, BABCOCK, JONES AND ASSOCIATES
INC. DOES NOT GUARANTEE THE COMPLETENESS NOR ACCURACY
THEREOF.

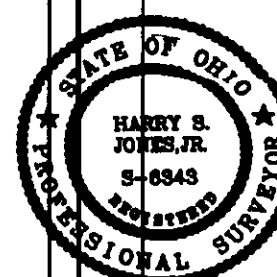

REV. NO.	DESCRIPTION	DATE	BY	CHK'D
1	REVISED REFLECTING LOT SPLIT	5/22/02	M.M.	H.J.
2	REVISED GUEST HSE & FINISH GRADES	9/10/02	B.P.	H.J.



BABCOCK, JONES AND ASSOCIATES, INC
CIVIL ENGINEERS - SURVEYORS - LAND PLANNERS
PAINESVILLE OHIO 44077

DATE: 5/7/02
DESIGN BY: H.J.
DRAWN BY: M.M.
APPROVED BY: H.J.

SITE PLAN
FOR
KERN BUILDING

MADISON TOWNSHIP

LAKE COUNTY, OHIO

SCALE: 1"=30'
JOB NO: 02-068
SHEET 1 OF 1