


BEING PART OF LOT 4, TRACT 4 IN THE
TOWNSHIP OF MADISON, COUNTY OF LAKE, OHIO

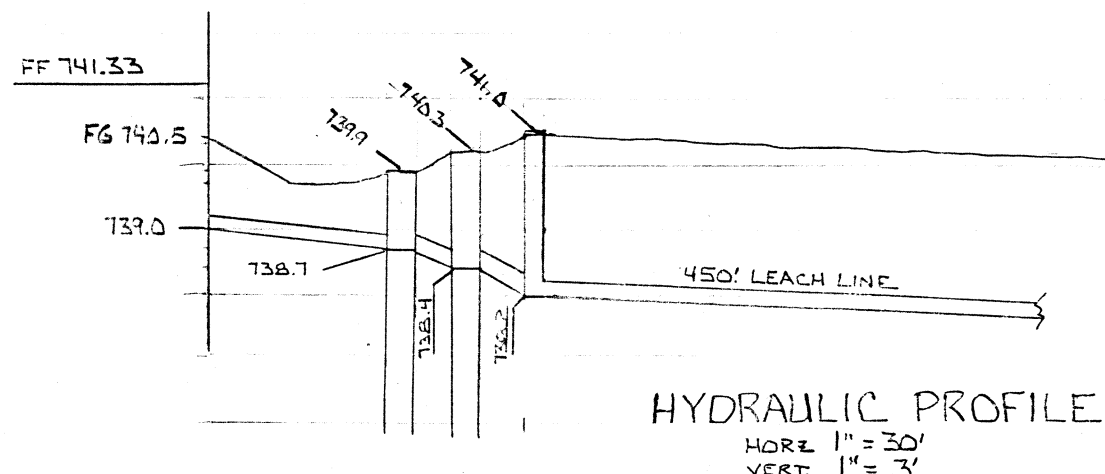

APPROVED
MADISON TWP. ZONING

Permit: 11830

Zoning Inspector: K. Lau

ARNOLD FRED & GRETTA ELLEN
VOL. 704 PG. 302,304


Grading Plan Approved
as shown and/or noted
THOMAS P. GILLES, P.E.
Lake County Engineer

By DM Date 7.22.87

1.165 Acres

SEWAGE DISPOSAL PERMIT MUST BE
OBTAINED BY A LAKE COUNTY LICENSED
INSTALLER BEFORE INSTALLATION IS
STARTED.

LAURELEE SATTER F
VOL. 38 PG. 347

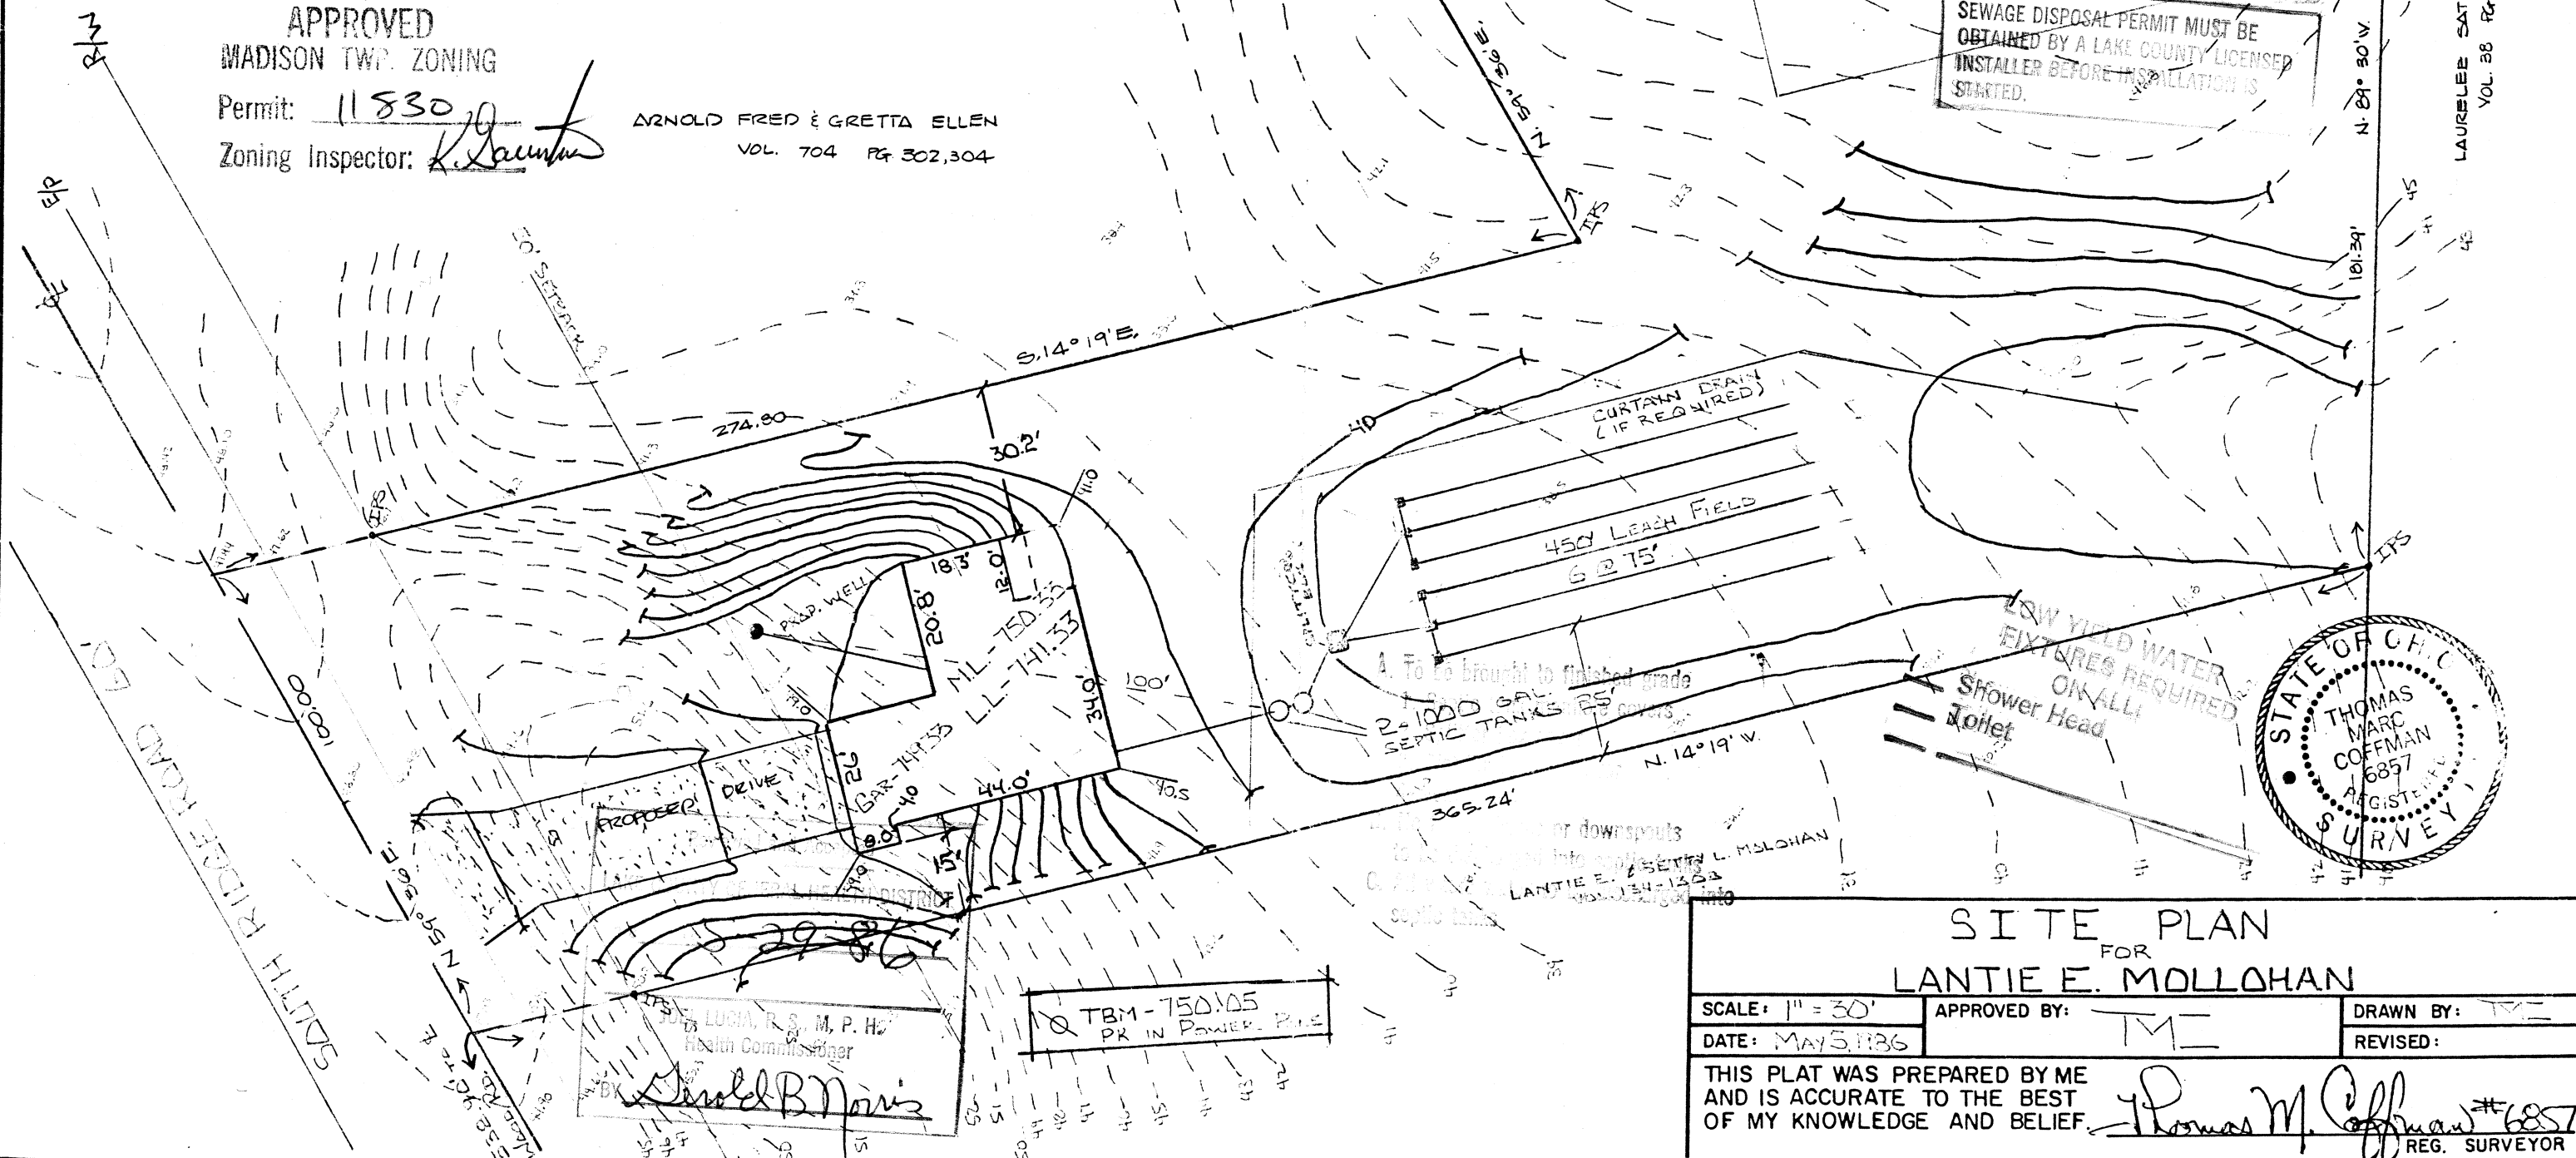

SITE PLAN
FOR
LANTIE E. MOLLOHAN

SCALE: 1" = 30'

DATE: MAY 5 1980

APPROVED BY:

DRAWN BY:

REVISÉ:

THIS PLAT WAS PREPARED BY ME
AND IS ACCURATE TO THE BEST
OF MY KNOWLEDGE AND BELIEF.

Thomas M. Coffman #685
REG. SURVEYOR