

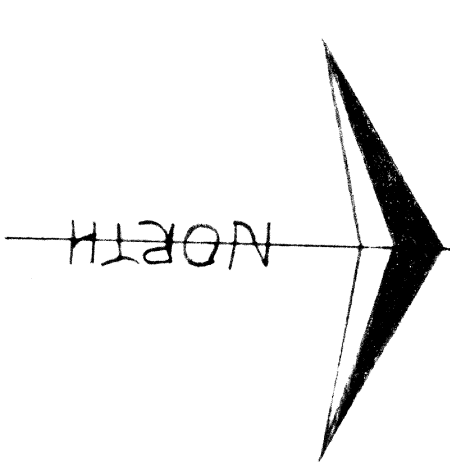


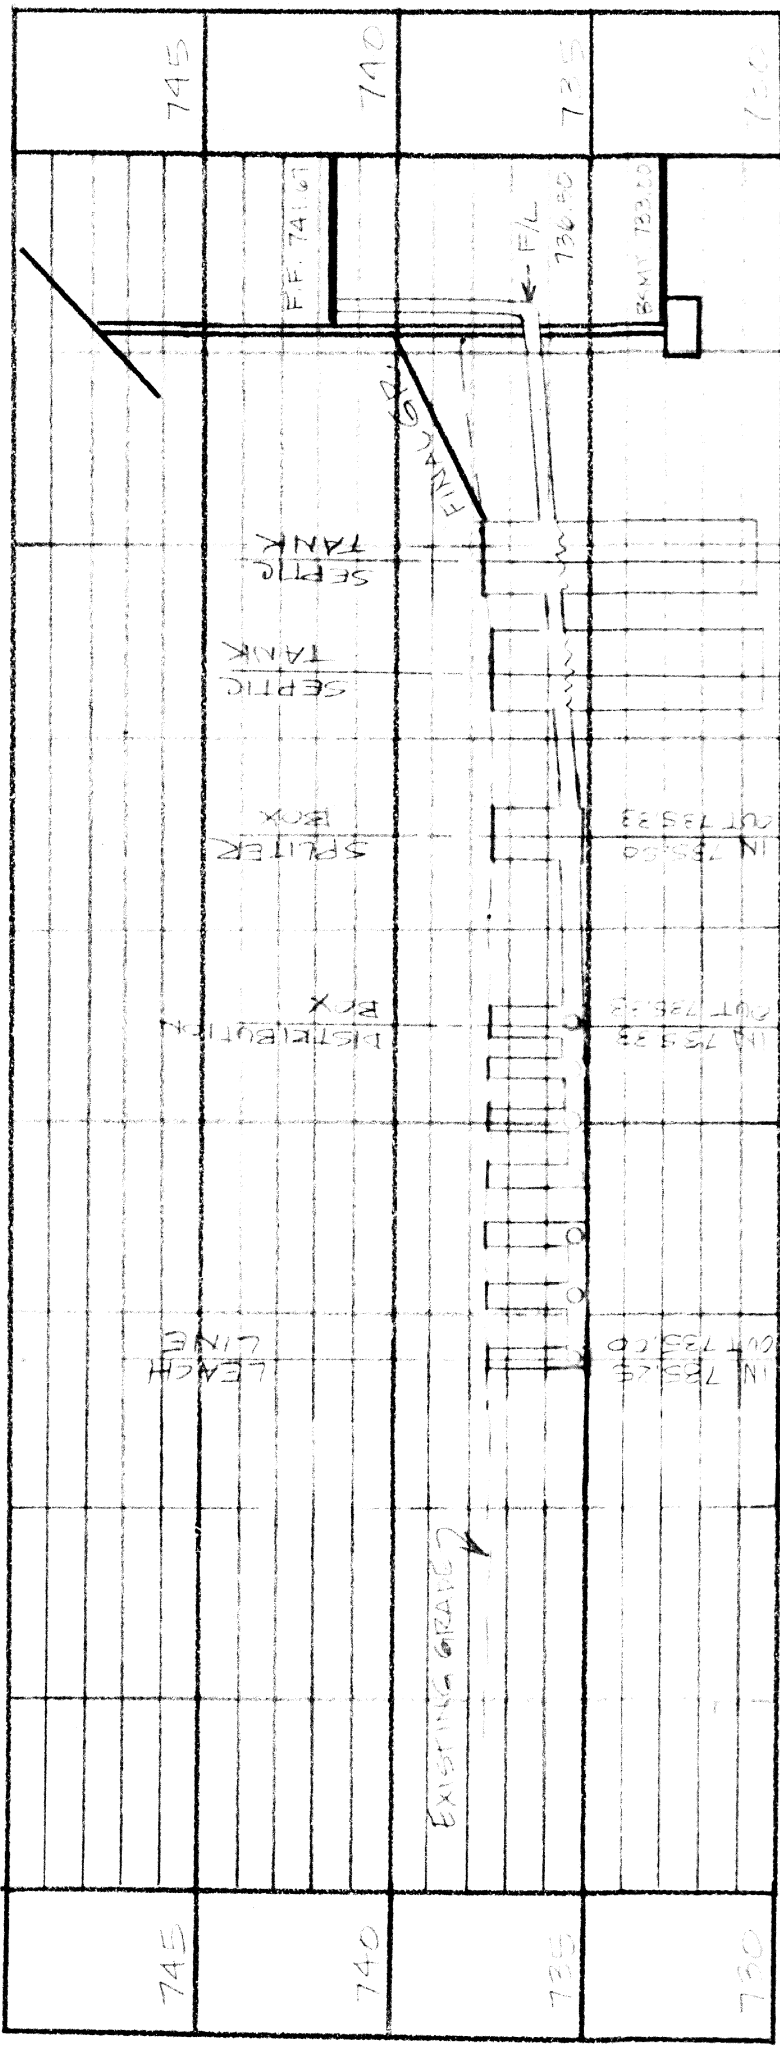


Grading Plan Approved
as shown and/or noted
THOMAS P. GILLES, P.E.
Lake County Engineer


By THP Date 8-28-87

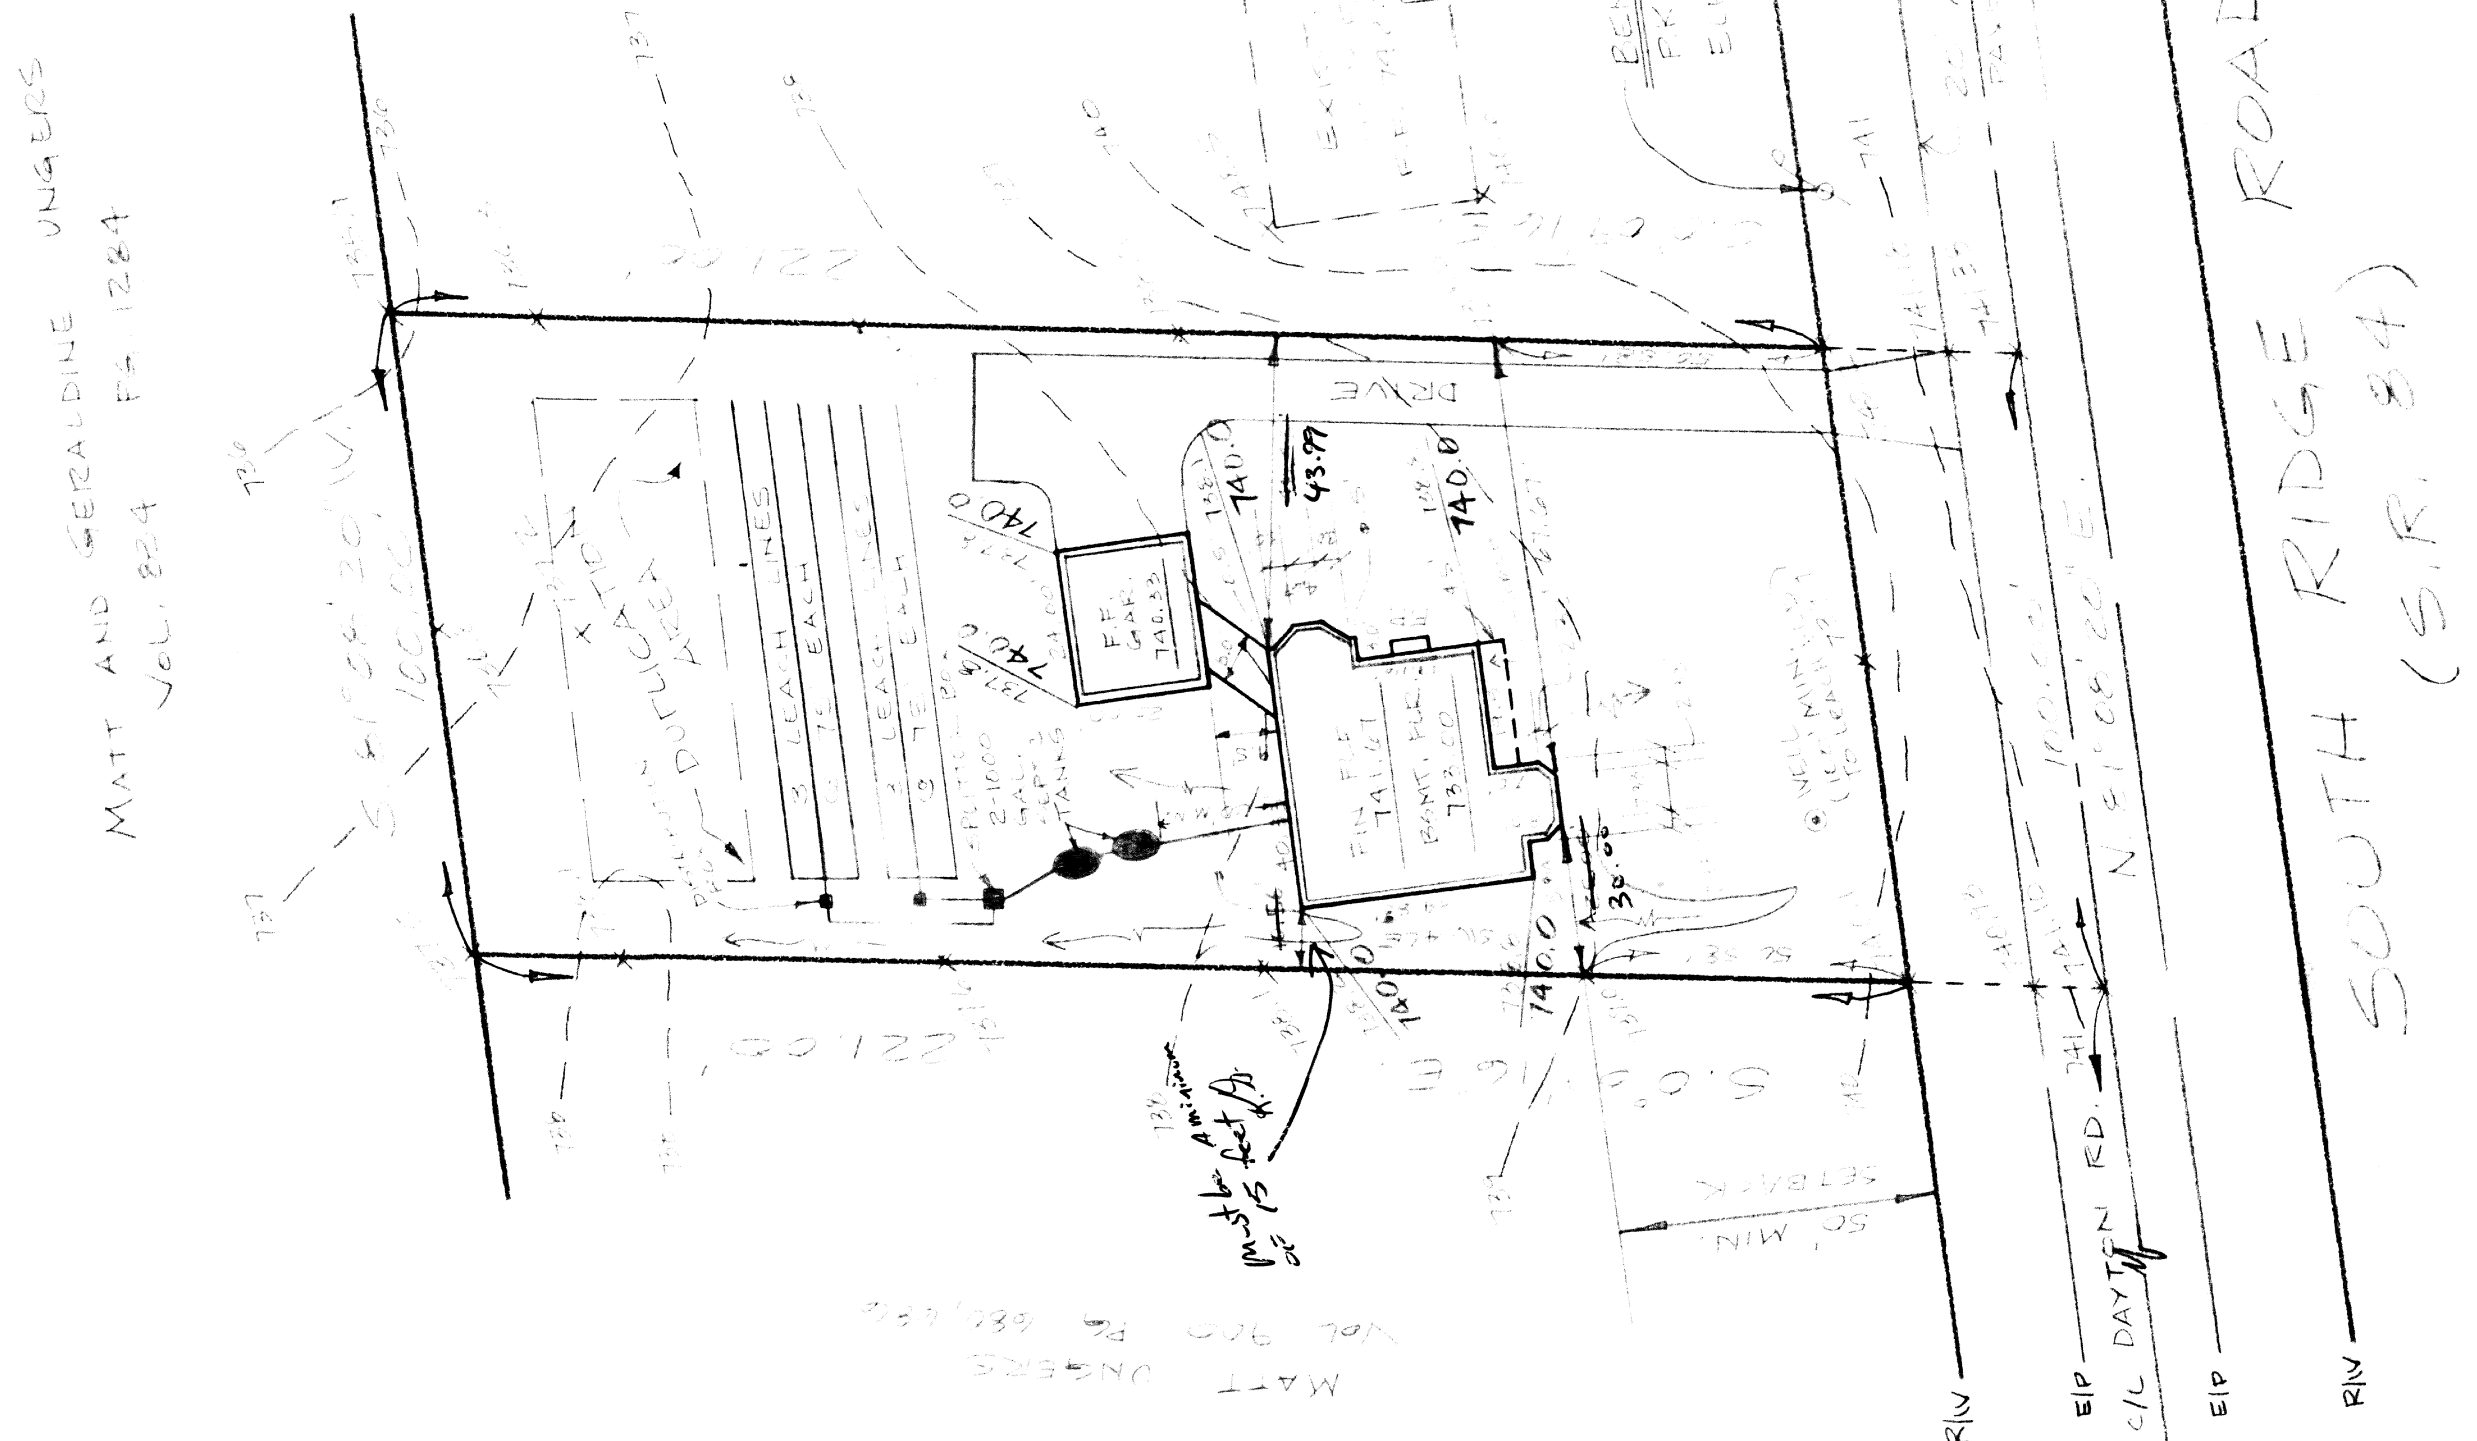

HYDRAULIC PROFILE
SCALE: 1" = 20' HORIZ.,
1" = 5' VERT.

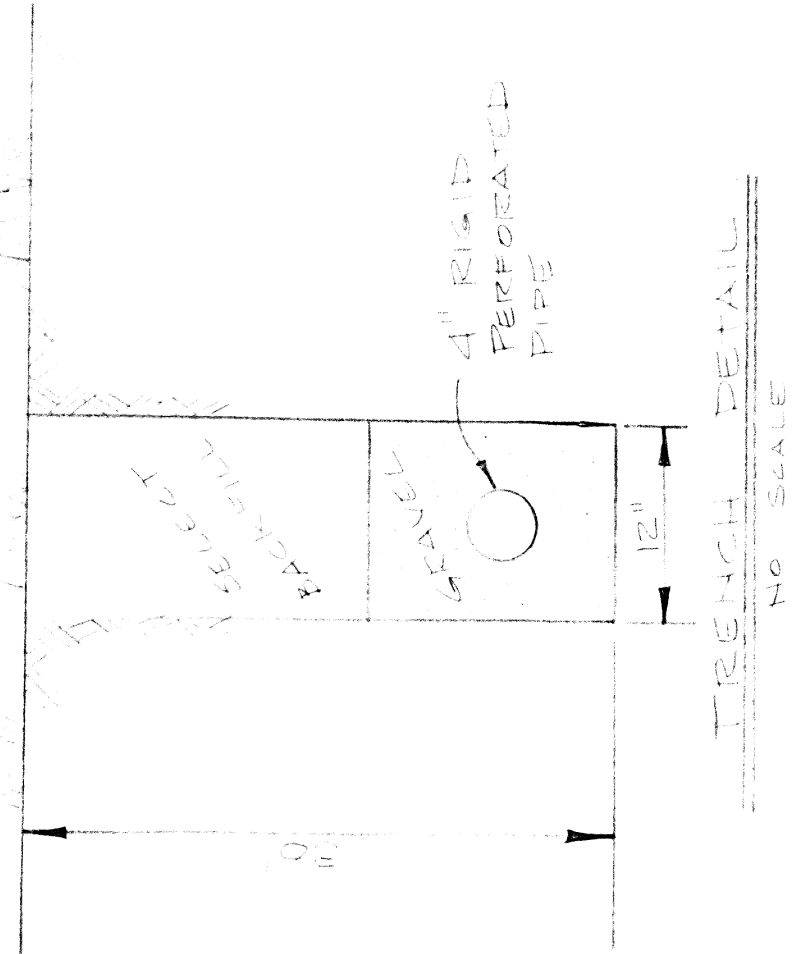

TRENCH DETAIL
NO SCALE

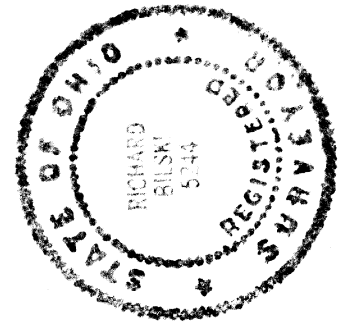

APPROVED
MADISON TWP. ZONING
Permit: 12150
Zoning Inspector: [Signature]

CERTIFICATION
THIS PLAT WAS PREPARED BY ME,
AND IS CORRECT TO THE BEST OF
MY KNOWLEDGE AND BELIEF.
[Signature]
REG. SURVEYOR NO. 5244

SITE PLAN FOR DOUG UNGERS
BEING A 0.570 ACRE PARCEL AND PART OF ORIGINAL
LOT NO. 13, AS SITUATED IN THE
TOWNSHIP OF MADISON, LAKE COUNTY, OHIO

COLPETZER-THOMAS, INC.
AN ENGINEERING GROUP
WILLOUGHBY • MENTOR • NORTH CANTON • STEUBENVILLE • LORAIN

DATE: 8-13-87
SCALE: 1" = 20'
DRAWN BY: RLS
CHKD BY: [Signature]
F.B. 522 PG. 104

SHEET 1 OF 1
CONTRACT NO. 87-251