


SITE PLAN
FOR
MARGARET LUKART

Grading Plan Approved
as shown and/or noted
THOMAS P. GILLES, P.E.
Lake County Engineer


By APG Date 2/28/87

N

SCALE: 1"=40'

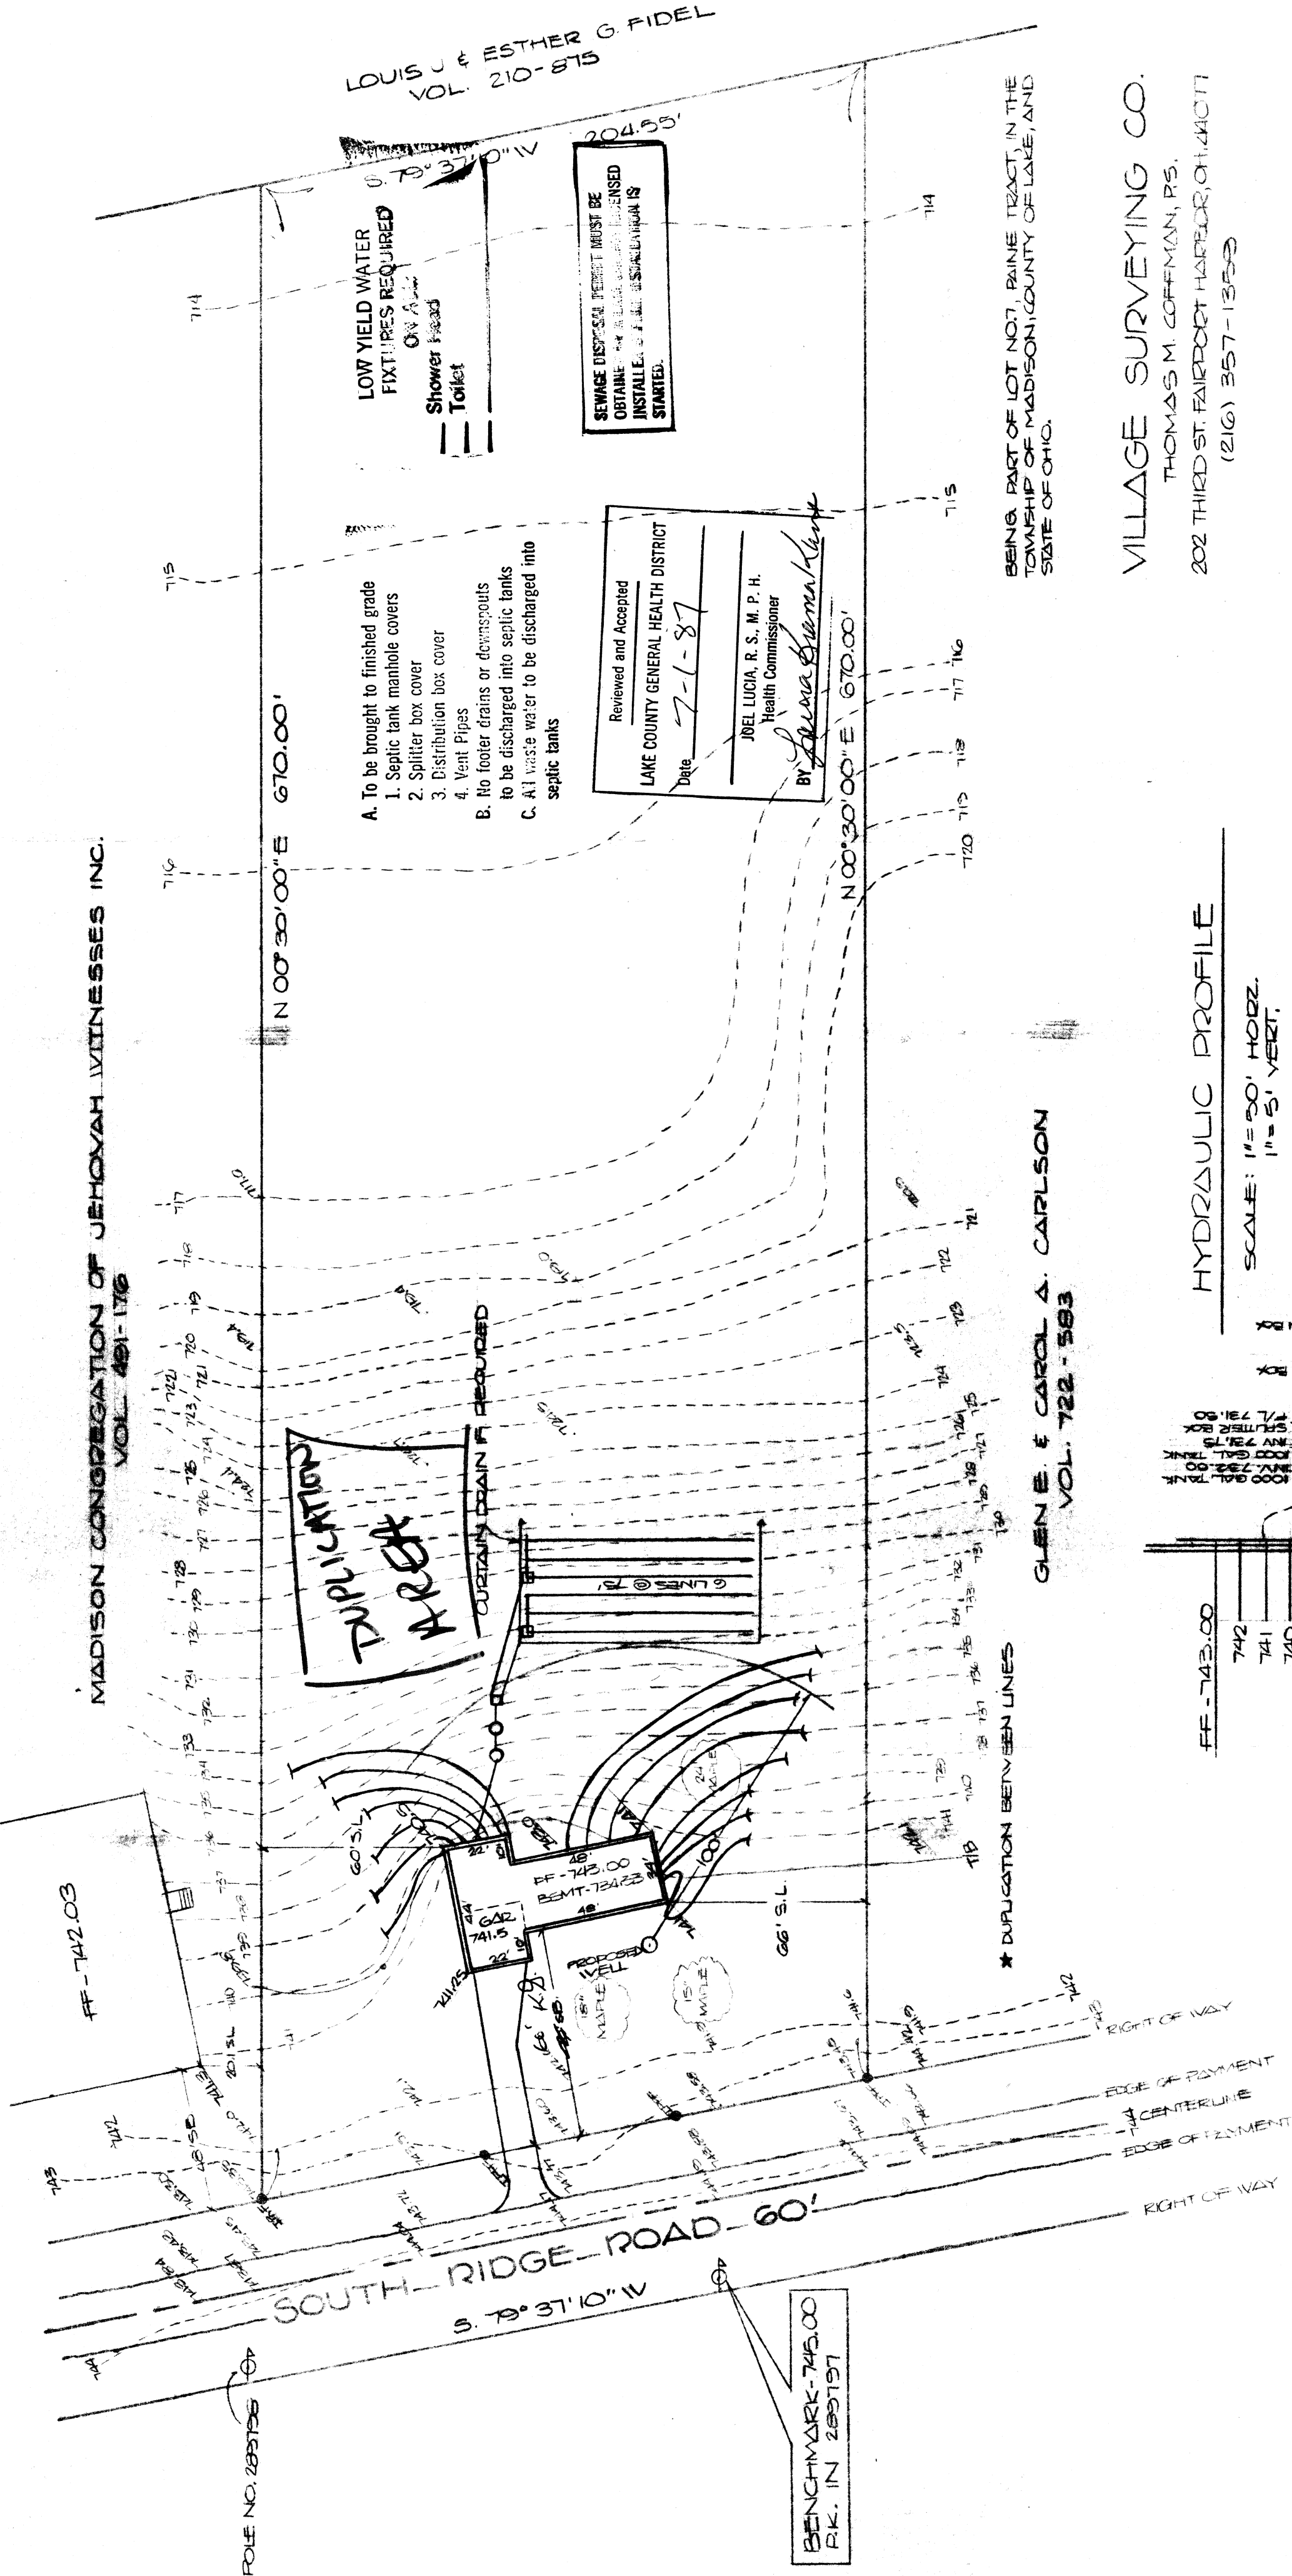

GLEN E. & CAROL A. CARLSON
VOL. 722-583

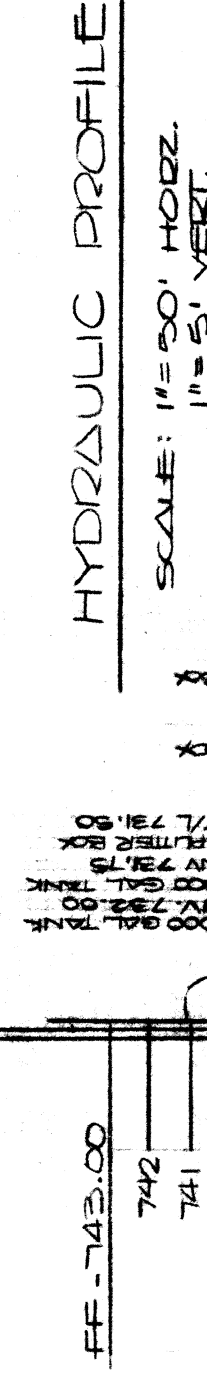

VILLAGE SURVEYING CO.
THOMAS M. COFFMAN, P.S.
202 THIRD ST. FAIRPORT HARBOR, OHIO 44130
(216) 357-1353

THIS PLAN WAS PREPARED BY ME AND IS TRUE & ACCURATE TO THE BEST OF MY KNOWLEDGE & BELIEF

Thomas M. Coffman
THOMAS M. COFFMAN, P.S.
STATE OF OHIO
REGISTERED
LAND SURVEYOR
NO. 6887

APPROVED
MADISON TWP. ZONING
Permit: 12108
Inspector: g. chard

