

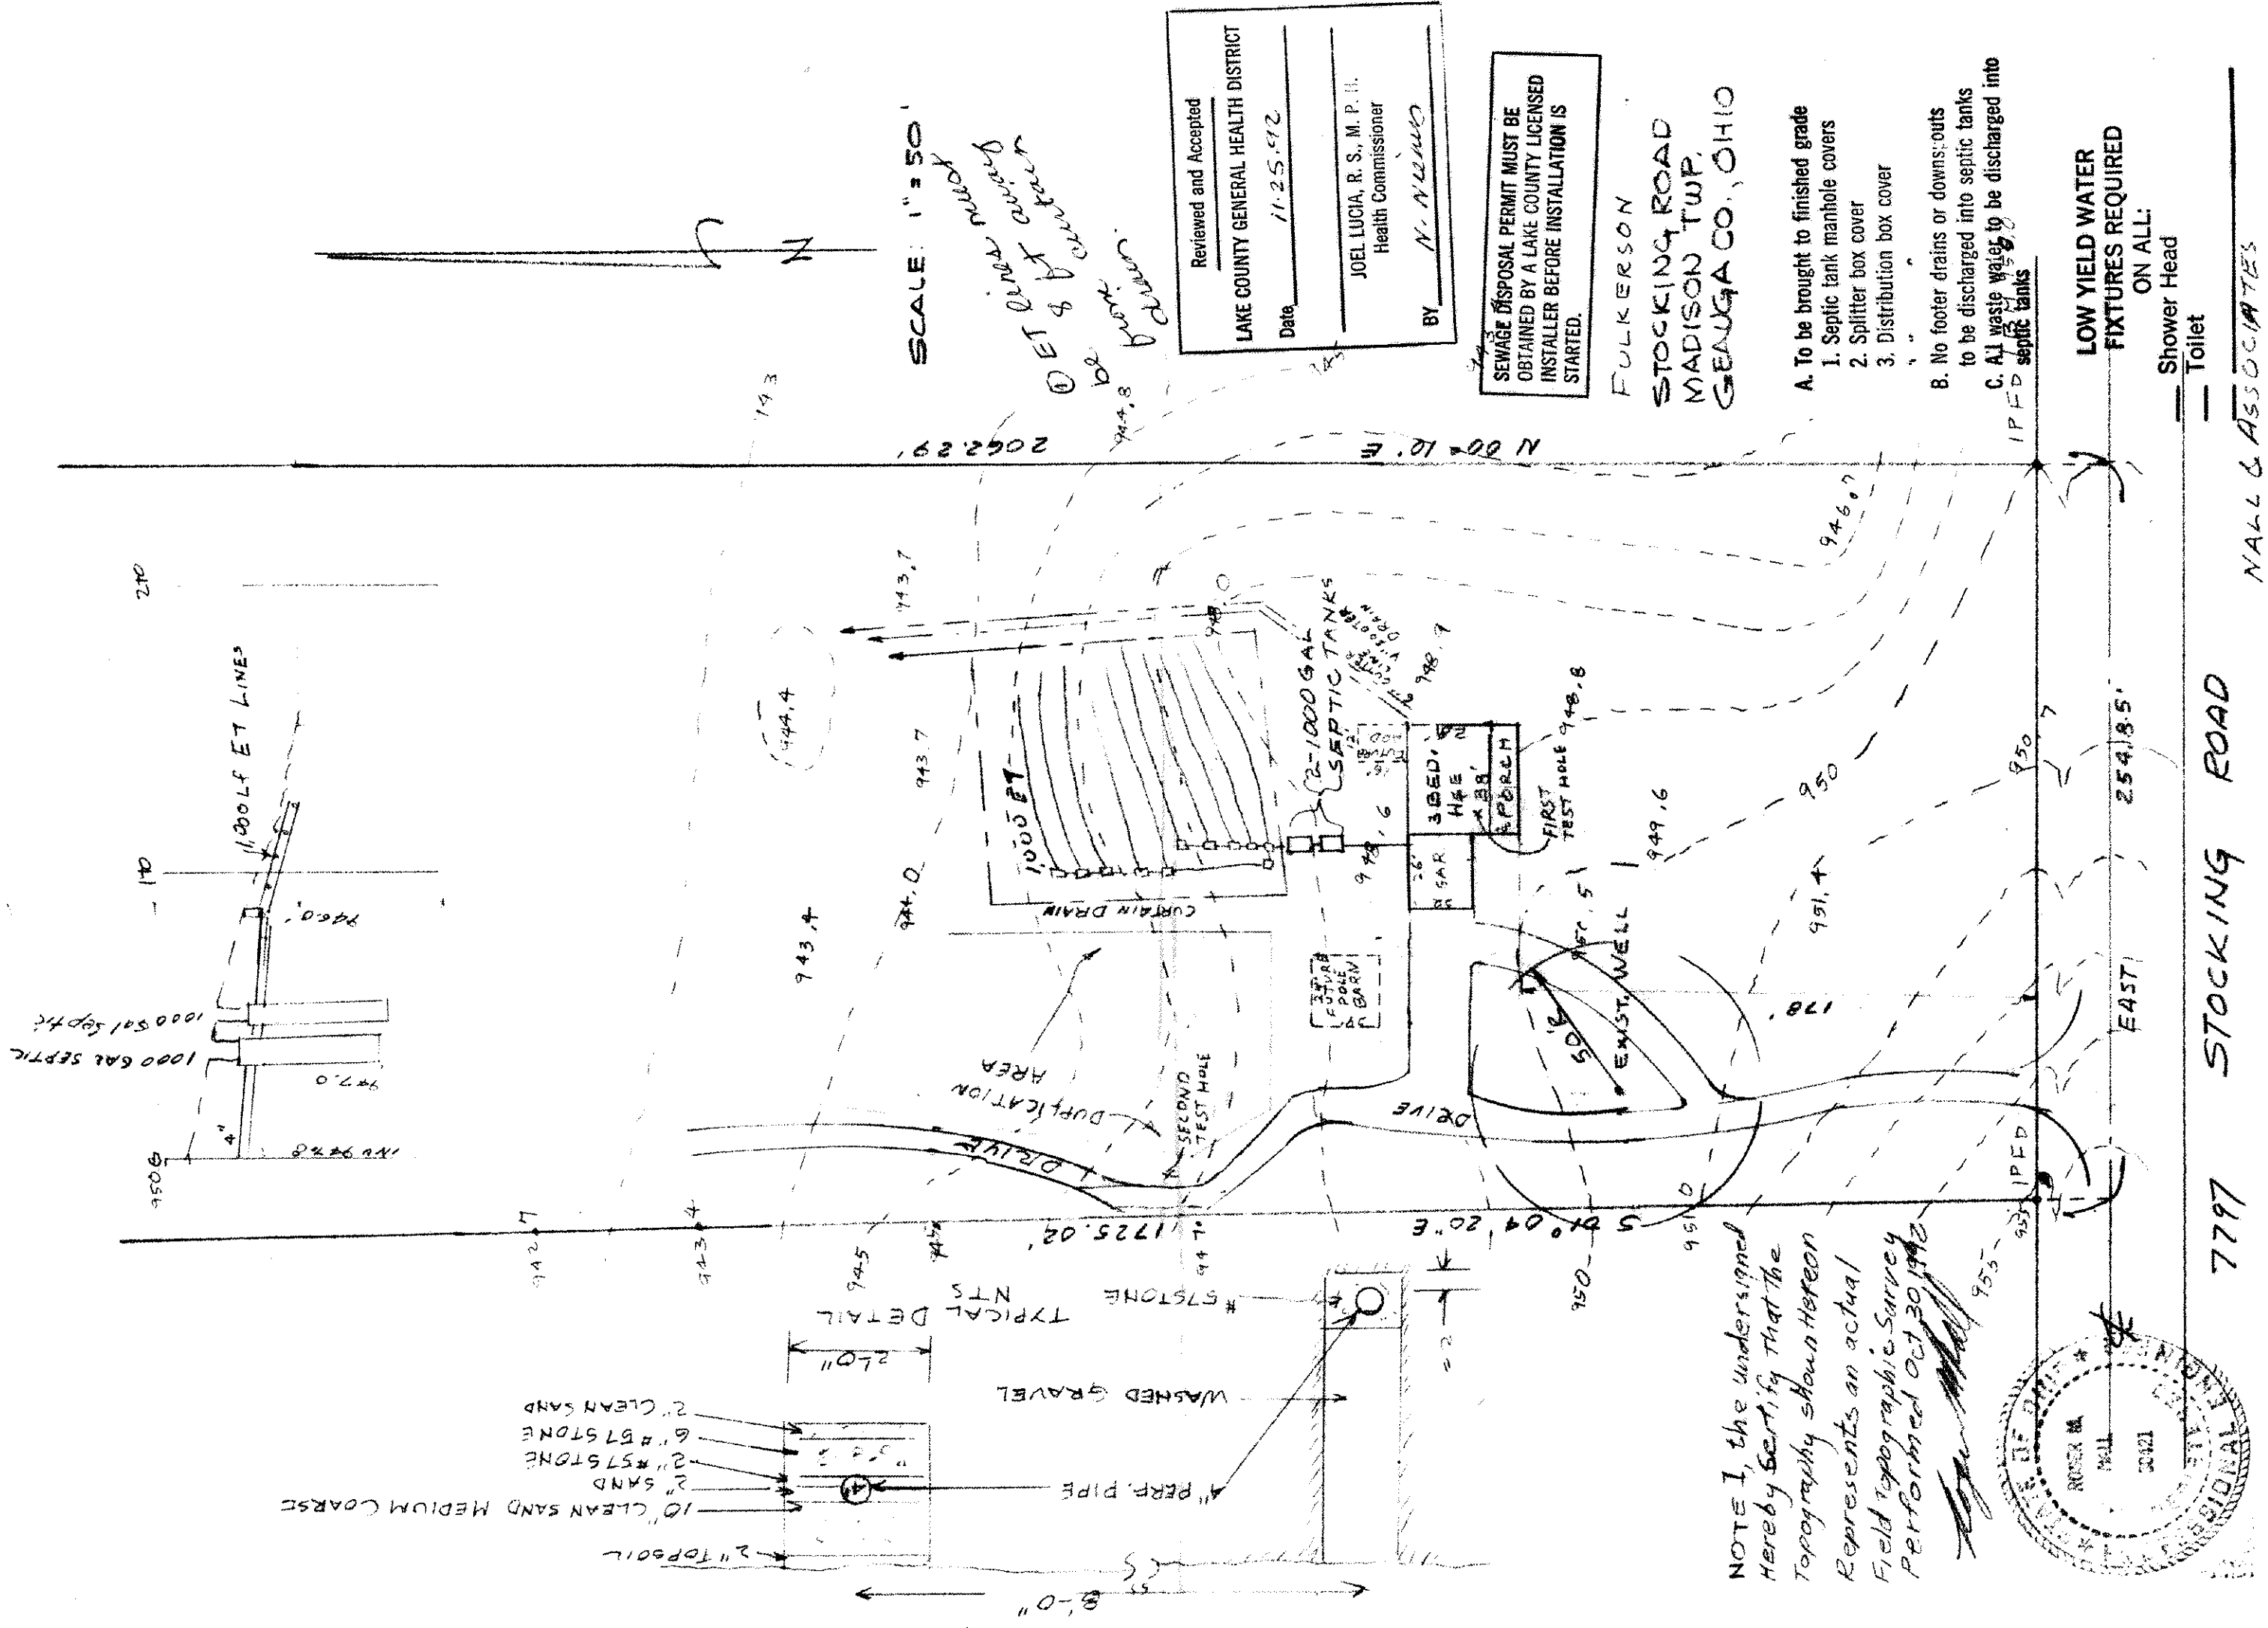
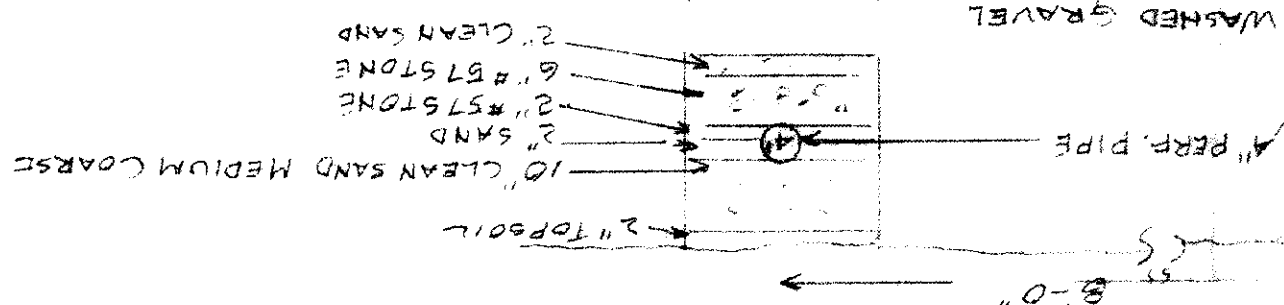


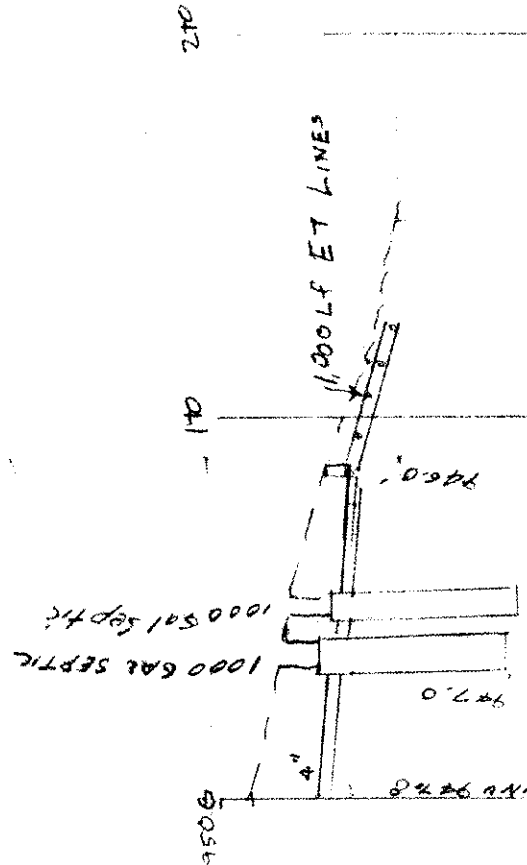

NOTE 1, the undersigned
 Hereby Certify that the
 Topography shown hereon
 Represents an actual
 Field topographic survey
 performed Oct 30, 1992

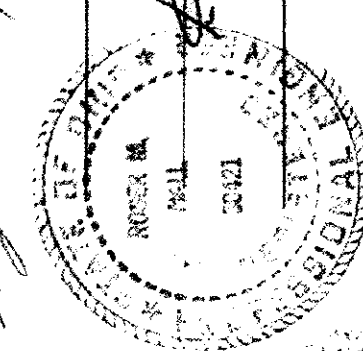

Reviewed and Accepted
 LAKE COUNTY GENERAL HEALTH DISTRICT
 Date 11.25.92
 JOEL LUCIA, R. S., M. P. H.
 Health Commissioner
 BY N. N. N.

SEWAGE DISPOSAL PERMIT MUST BE
 OBTAINED BY A LAKE COUNTY LICENSED
 INSTALLER BEFORE INSTALLATION IS
 STARTED.

FULKERSON
 STOCKING ROAD
 MADISON TWP.
 GAUGA CO., OHIO

- A. To be brought to finished grade
 1. Septic tank manhole covers
 2. Splitter box cover
 3. Distribution box cover
- B. No footer drains or downspouts
 to be discharged into septic tanks
- C. All waste water to be discharged into
 septic tanks

LOW YIELD WATER
 FIXTURES REQUIRED
 ON ALL:

- Shower Head
- Toilet

7797 STOCKING ROAD

NALL & ASSOCIATES
 11993 RAVENNA RD
 CHARDON OH 44024
 286-3207