


APPROVED
MADISON TWP. ZONING

Permit 11163
Zoning Inspector *K. Lewis*

Milton R. Bloomhouse
Reg. Surveyor #2247

Grading Plan Approved
as shown and/or noted
THOMAS P. GILLES, P.E.
Lake County Engineer
Date 4-7-83

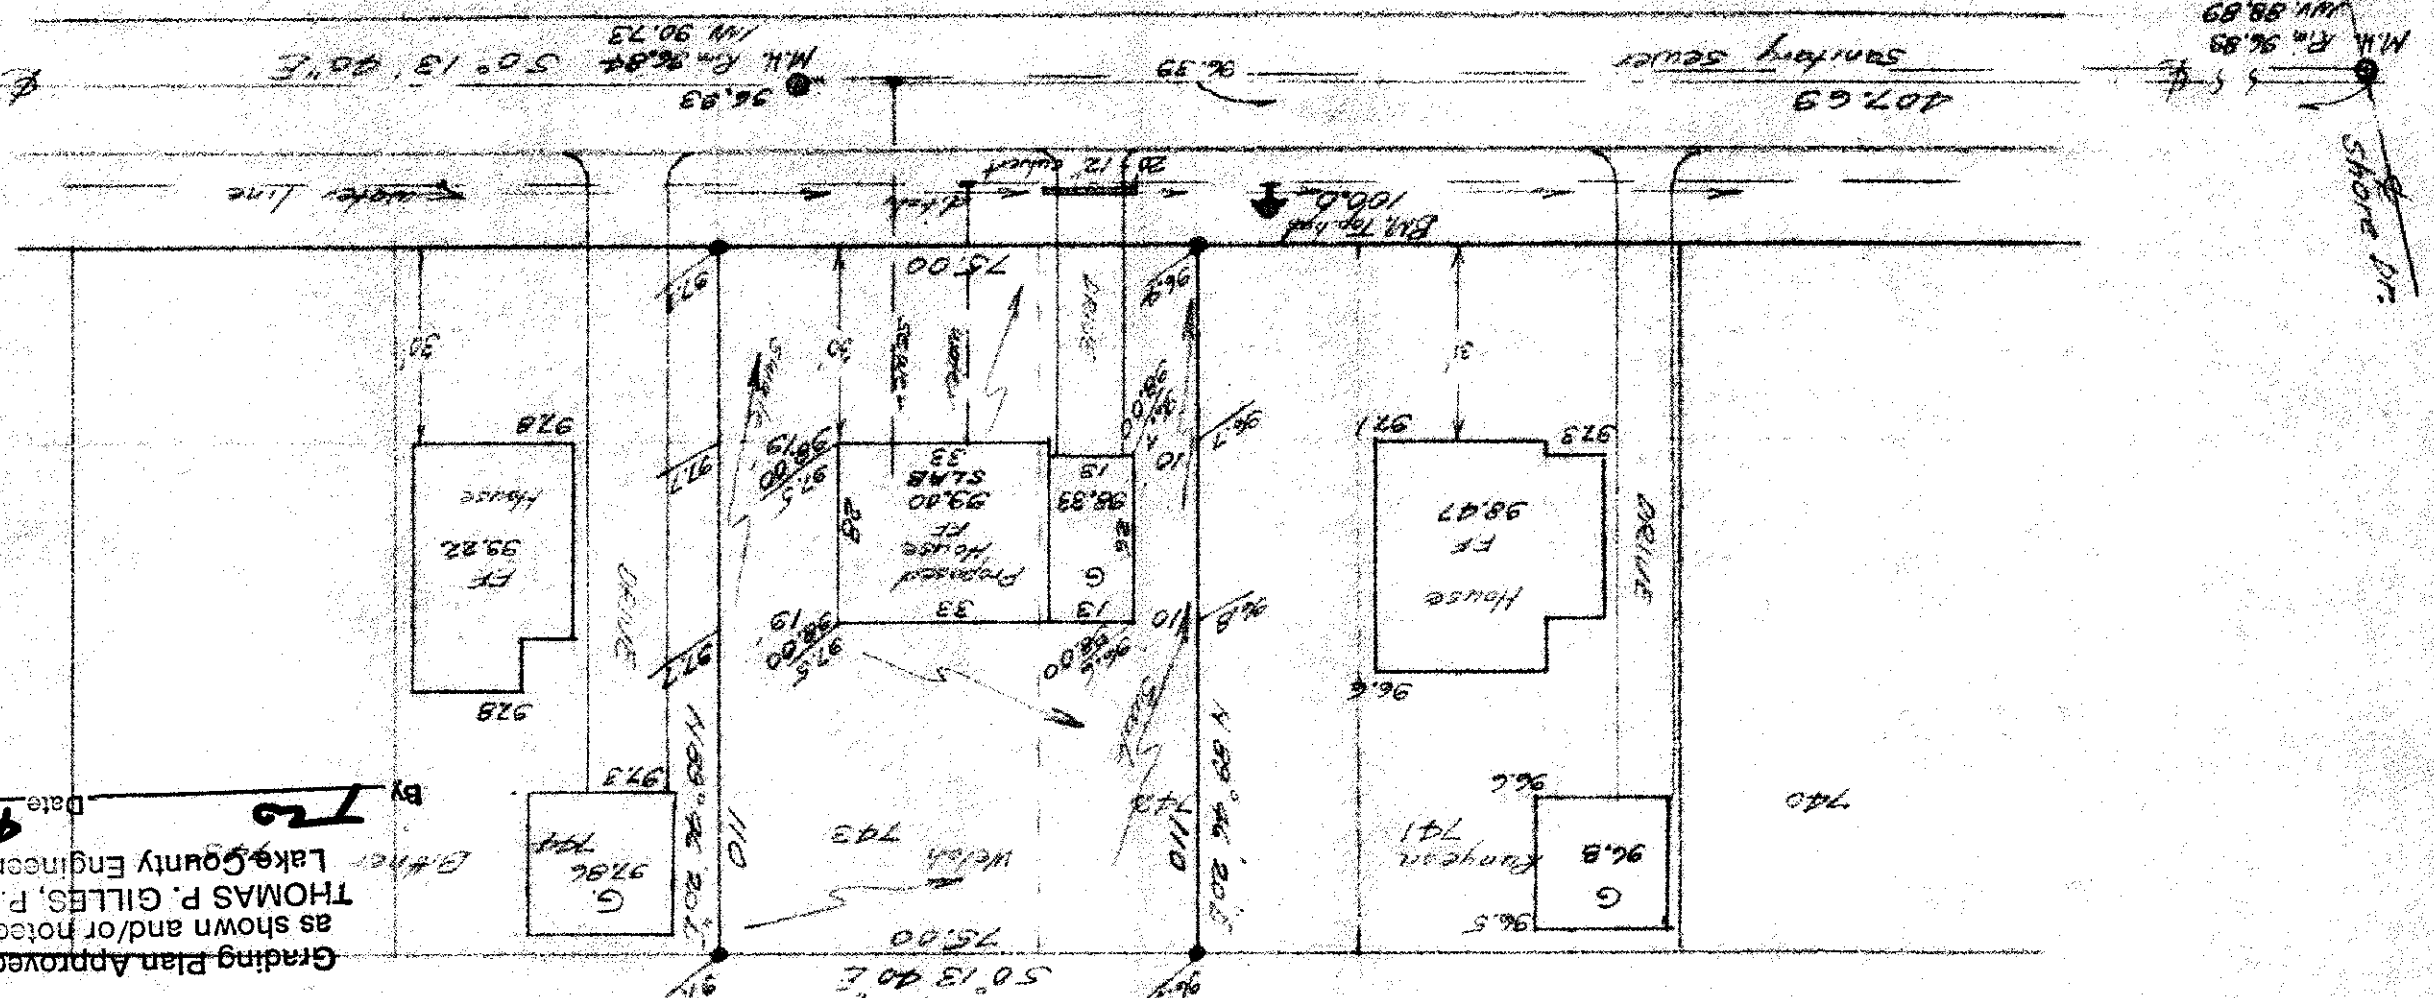

SITE PLAN
for
JOE WELCH
MADISON TOWNSHIP
LAKE CO OHIO
1" = 30' MAR 1983