


SITE PLAN
FOR

CHARLES T. WARNER

KNOWN AS BEING SUBLOT 422 IN THE LAKE
BREEZE PARK COMPANY'S MADISON LAKELAND
SUBDIVISION AS RECORDED IN VOLUME D,
PAGE 52 OF THE LAKE COUNTY PLAT RECORDS

TOWNSHIP OF MADISON
COUNTY OF LAKE - STATE OF OHIO

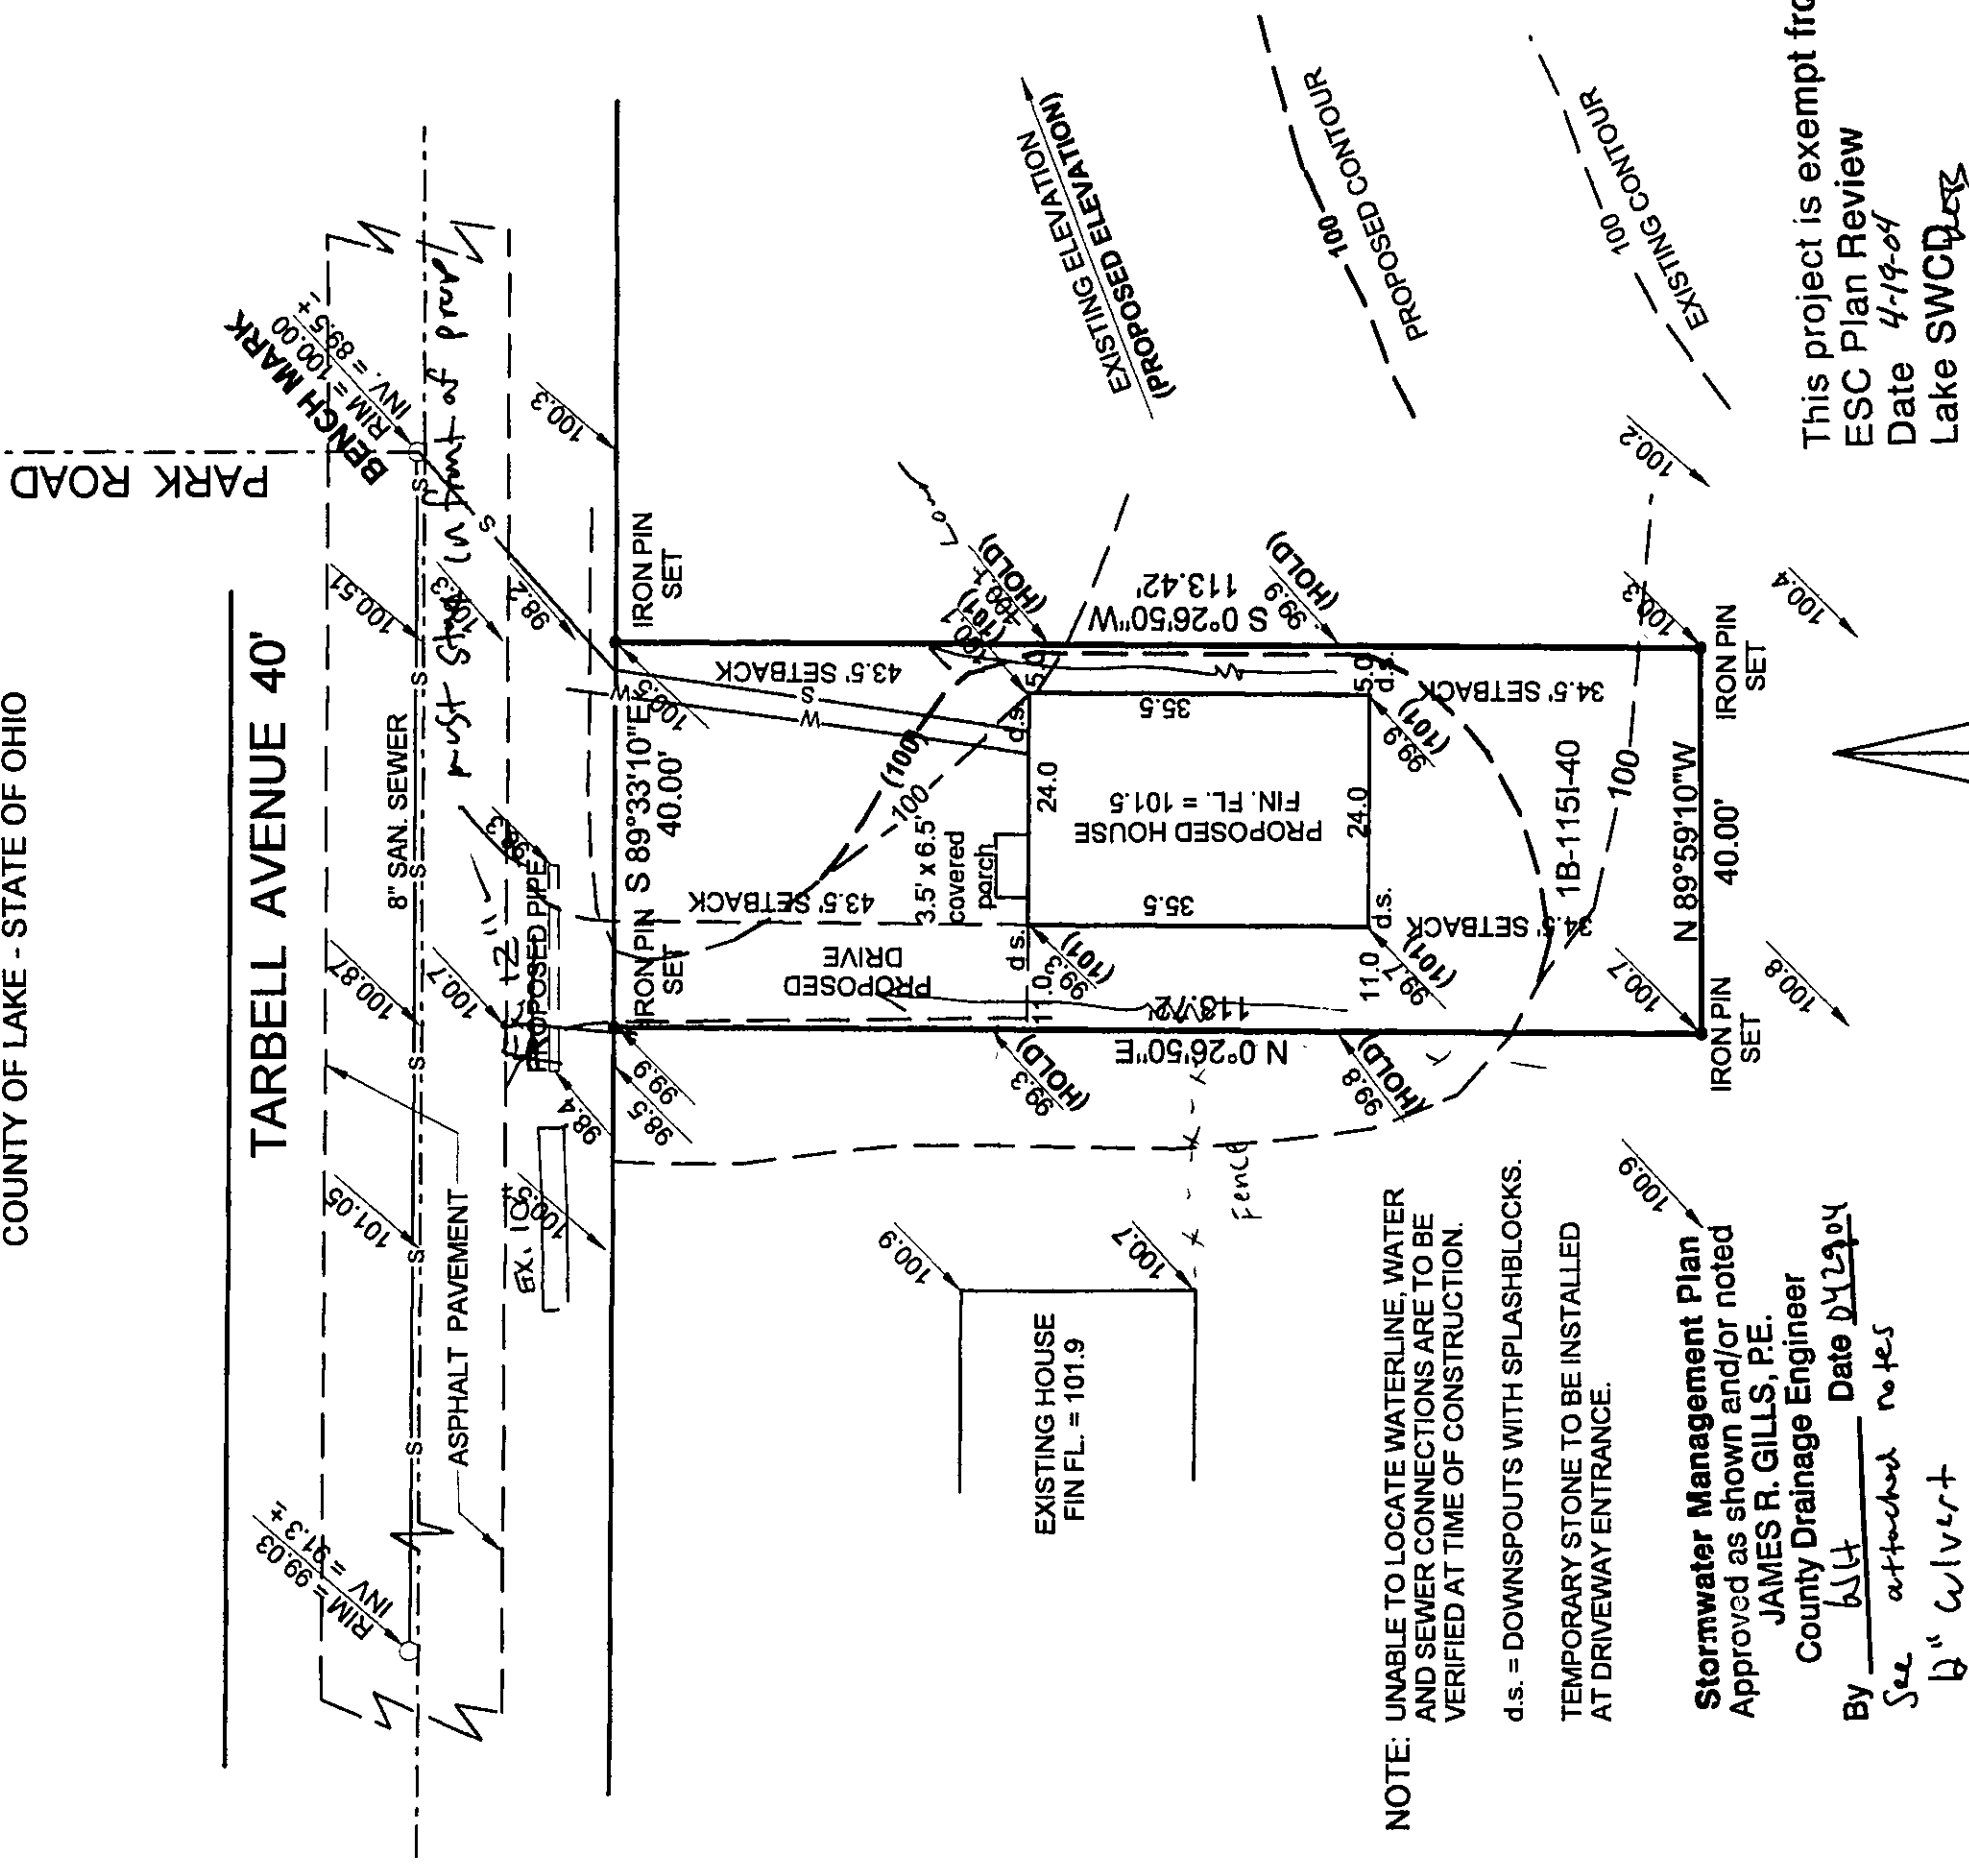

NOTE: UNABLE TO LOCATE WATERLINE, WATER
AND SEWER CONNECTIONS ARE TO BE
VERIFIED AT TIME OF CONSTRUCTION.

d.s. = DOWNSPOUTS WITH SPLASHBLOCKS.

TEMPORARY STONE TO BE INSTALLED
AT DRIVEWAY ENTRANCE.

Stormwater Management Plan
Approved as shown and/or noted
JAMES R. GILLS, P.E.

County Drainage Engineer


By 6/14 Date 6/14/04

See attached notes

12" culvert

"I, THE UNDERSIGNED, HEREBY CERTIFY THAT THE
TOPOGRAPHY SHOWN HEREON, INDICATED BY SPOT
ELEVATIONS AND ONE FOOT CONTOURS, REPRESENTS
AN ACTUAL FIELD SURVEY MADE BY ME ON THE 9th
DAY OF MARCH, 2004 AND THAT THE ELEVATIONS WERE
TAKEN AT APPROPRIATE INTERVALS AND THAT AS OF
THAT DATE THEY EXISTED AS INDICATED HEREON."

This project is exempt from
ESC Plan Review
Date 4-19-04
Lake SWCD

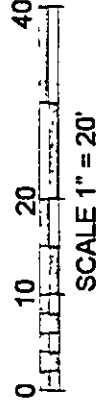

James A. Ziemba
JAMES A. ZIEMBA PROFESSIONAL SURVEYOR #7094



BENCHMARK SURVEY COMPANY
5964 SOUTH RIDGE ROAD
MADISON, OHIO 44057
1-440-428-8599
APR 16 2004 APPROVED
TOWNSHIP ZONING
DATE 4/16/04
BY dm 21765