
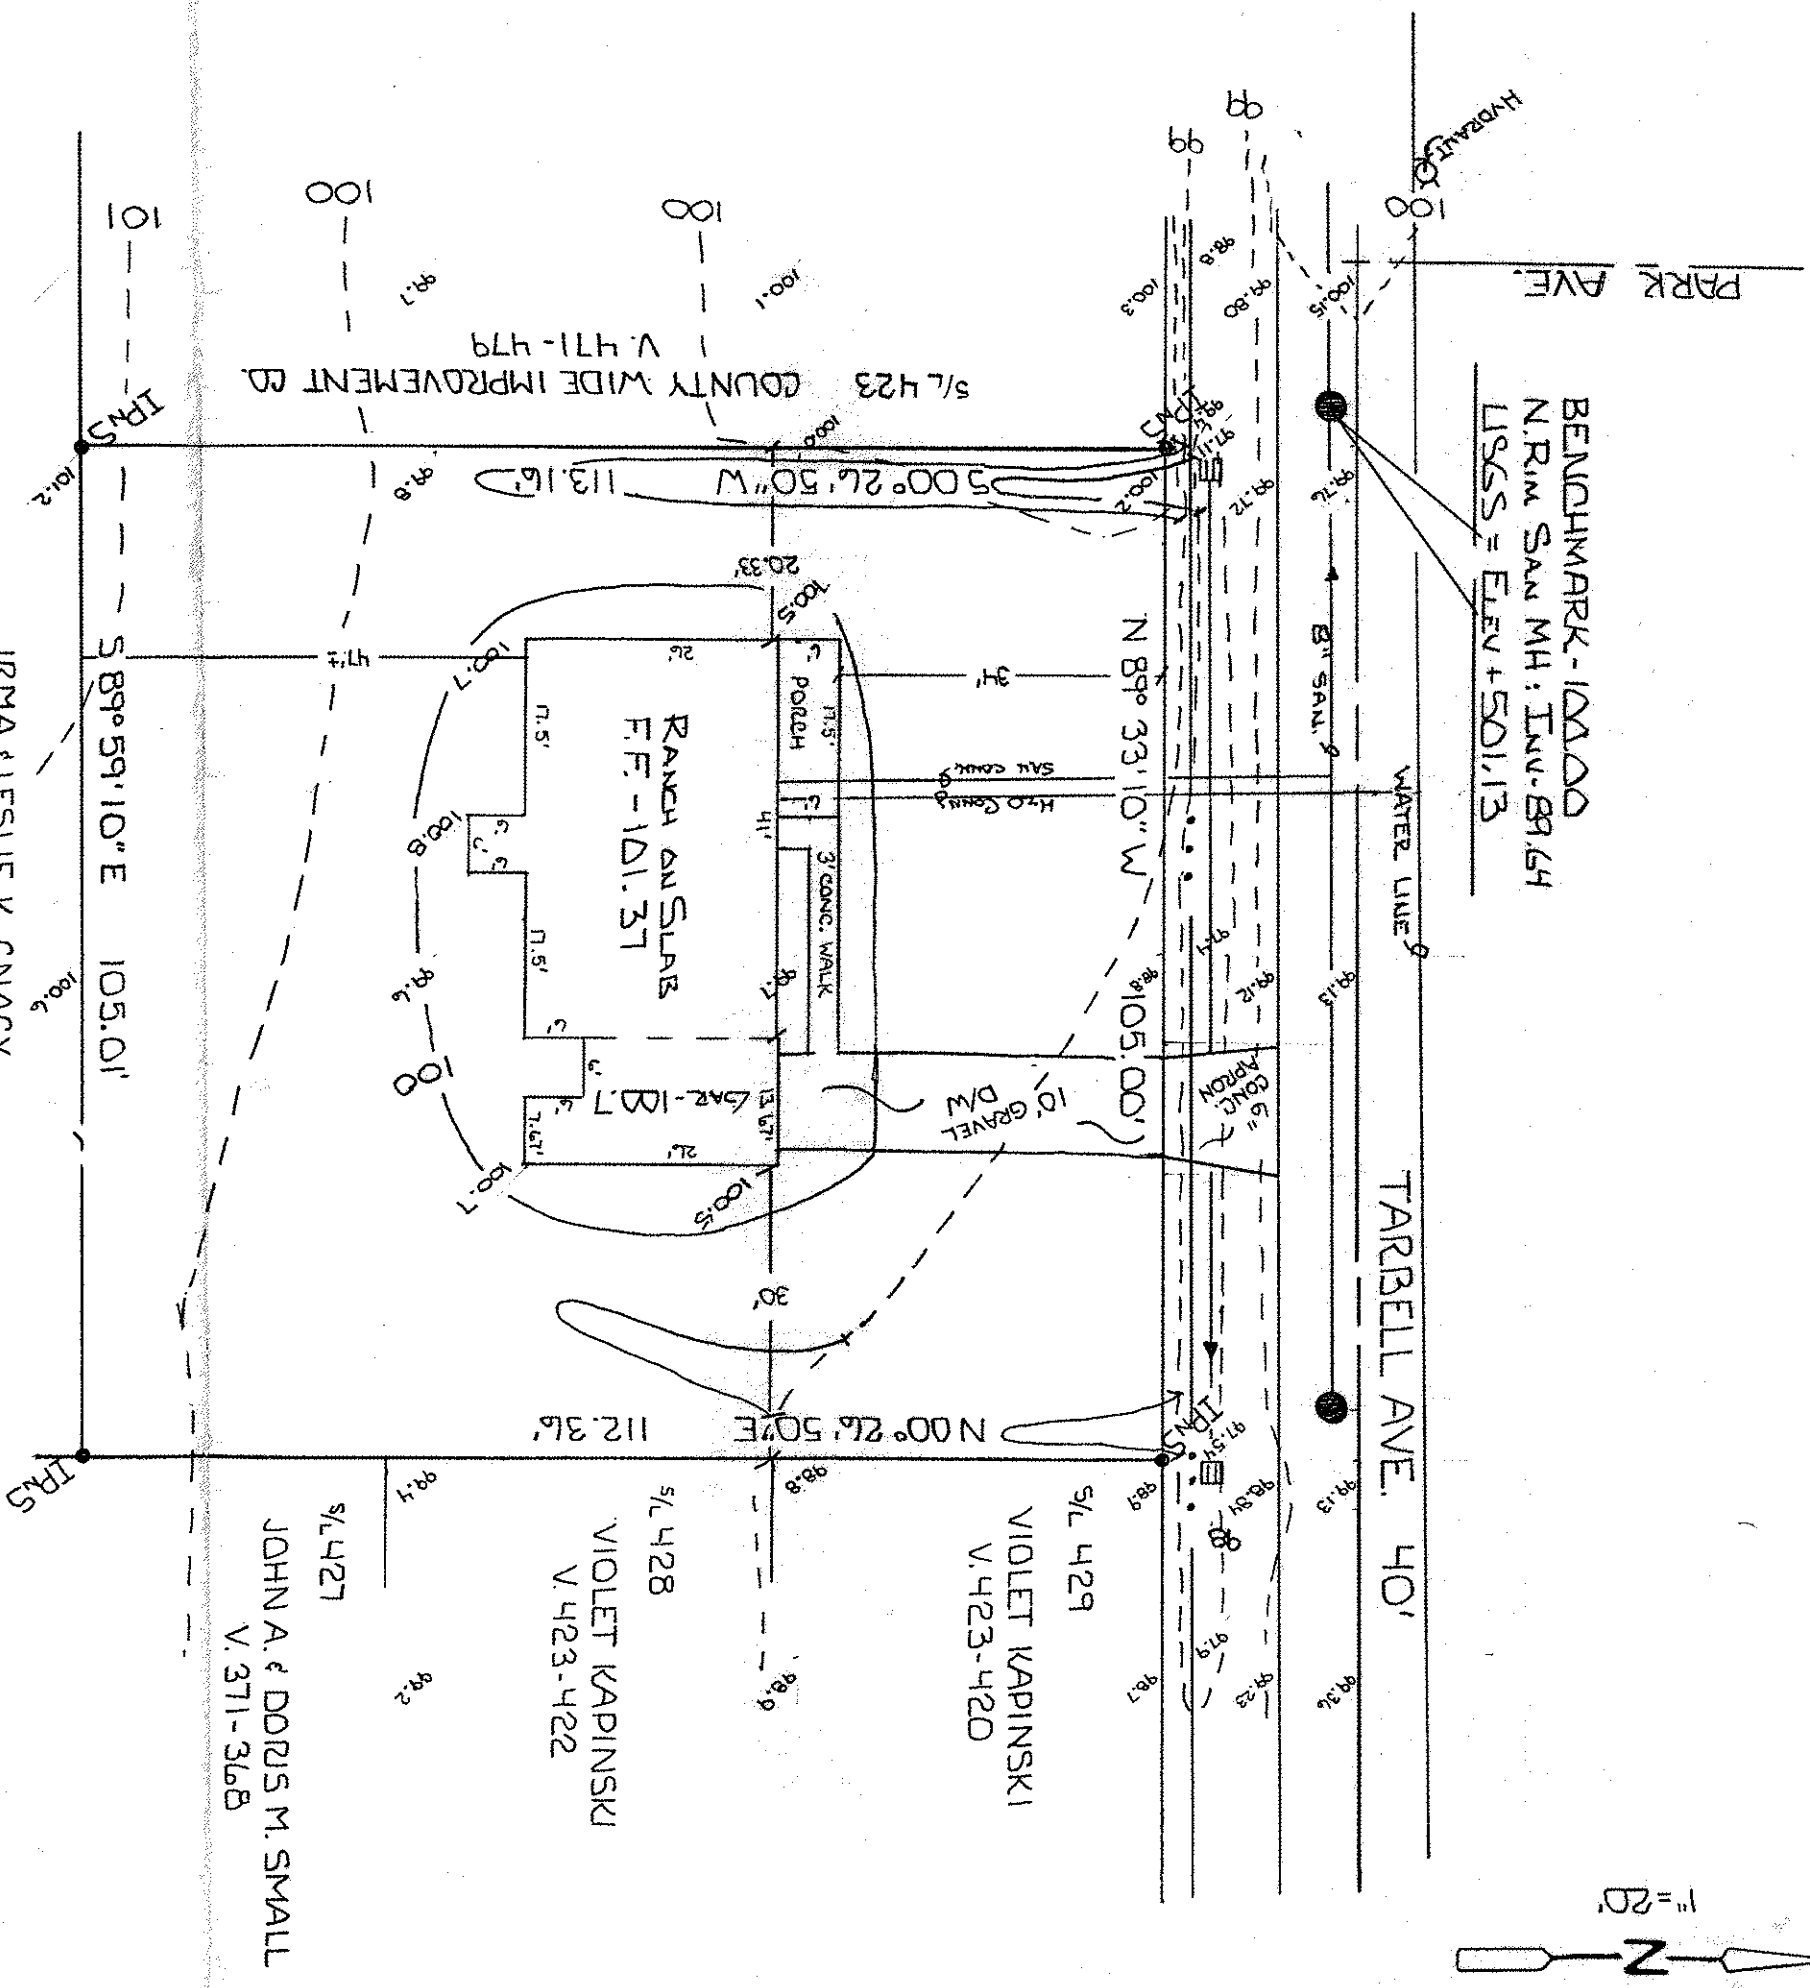


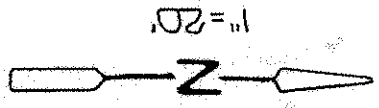

SITE PLAN

FOR
PAC HOMES

BEING S/L 424, 425 & 426 OF
LAKE BREEZE PARK CO.'S
MADISON- LAKELAND SUBD.
No. 2 IN THE TOWNSHIP OF
MADISON, COUNTY OF LAKE,
STATE OF OHIO.


APPROVED

MADISON TWP. ZONING

Permit 19836

Building Inspector

AUG. 20 1990

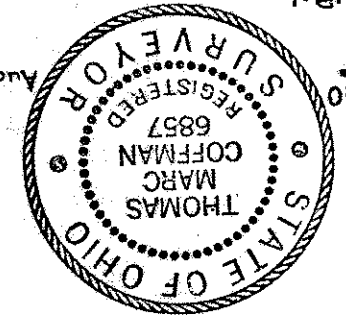

Grading Plan Approved
as shown and/or noted
Lake County Engineer
THOMAS P. GILLES, P.E.
Date 8/2/90

1. ENCLOSURE OF ROADSIDE DITCH
AND PIPE SIZE TO BE APPROVED BY
MADISON TWP.

I, the undersigned hereby certify that
this topography, indicated by 1' contours,
and elevations shown hereon represent an
actual field survey made by me on June 29, 1990
and that the elevations were taken at
appropriate intervals and that as of that
date they existed as indicated hereon.

J. M. Coffman P.E.
No. 6857

VILLAGE SURVEYING CO.
202 THIRD STREET, FAIRPORT HARBOR, OHIO 44077
(216) 357-1359